


SURVEY FOR: LEAR WAY PLAZA, LLC
P.O. BOX 4521
MEDFORD, OR 97501

SURVEY BY: L.J. FRIAR & ASSOCIATES, P.C.
CONSULTING LAND SURVEYORS
816 WEST EIGHTH STREET
MEDFORD, OREGON 97501
PHONE: (541) 772-2782
EMAIL: LJFRIAR@CHARTER.NET

DATE: AUGUST 14, 2006


MAP OF SURVEY
Property Line Adjustment
Located in the N.E. 1/4 of Section 7,
T.37S, R.1W, W.M. in the City of Medford
Jackson County, Oregon
(File No. PLA-06-190)

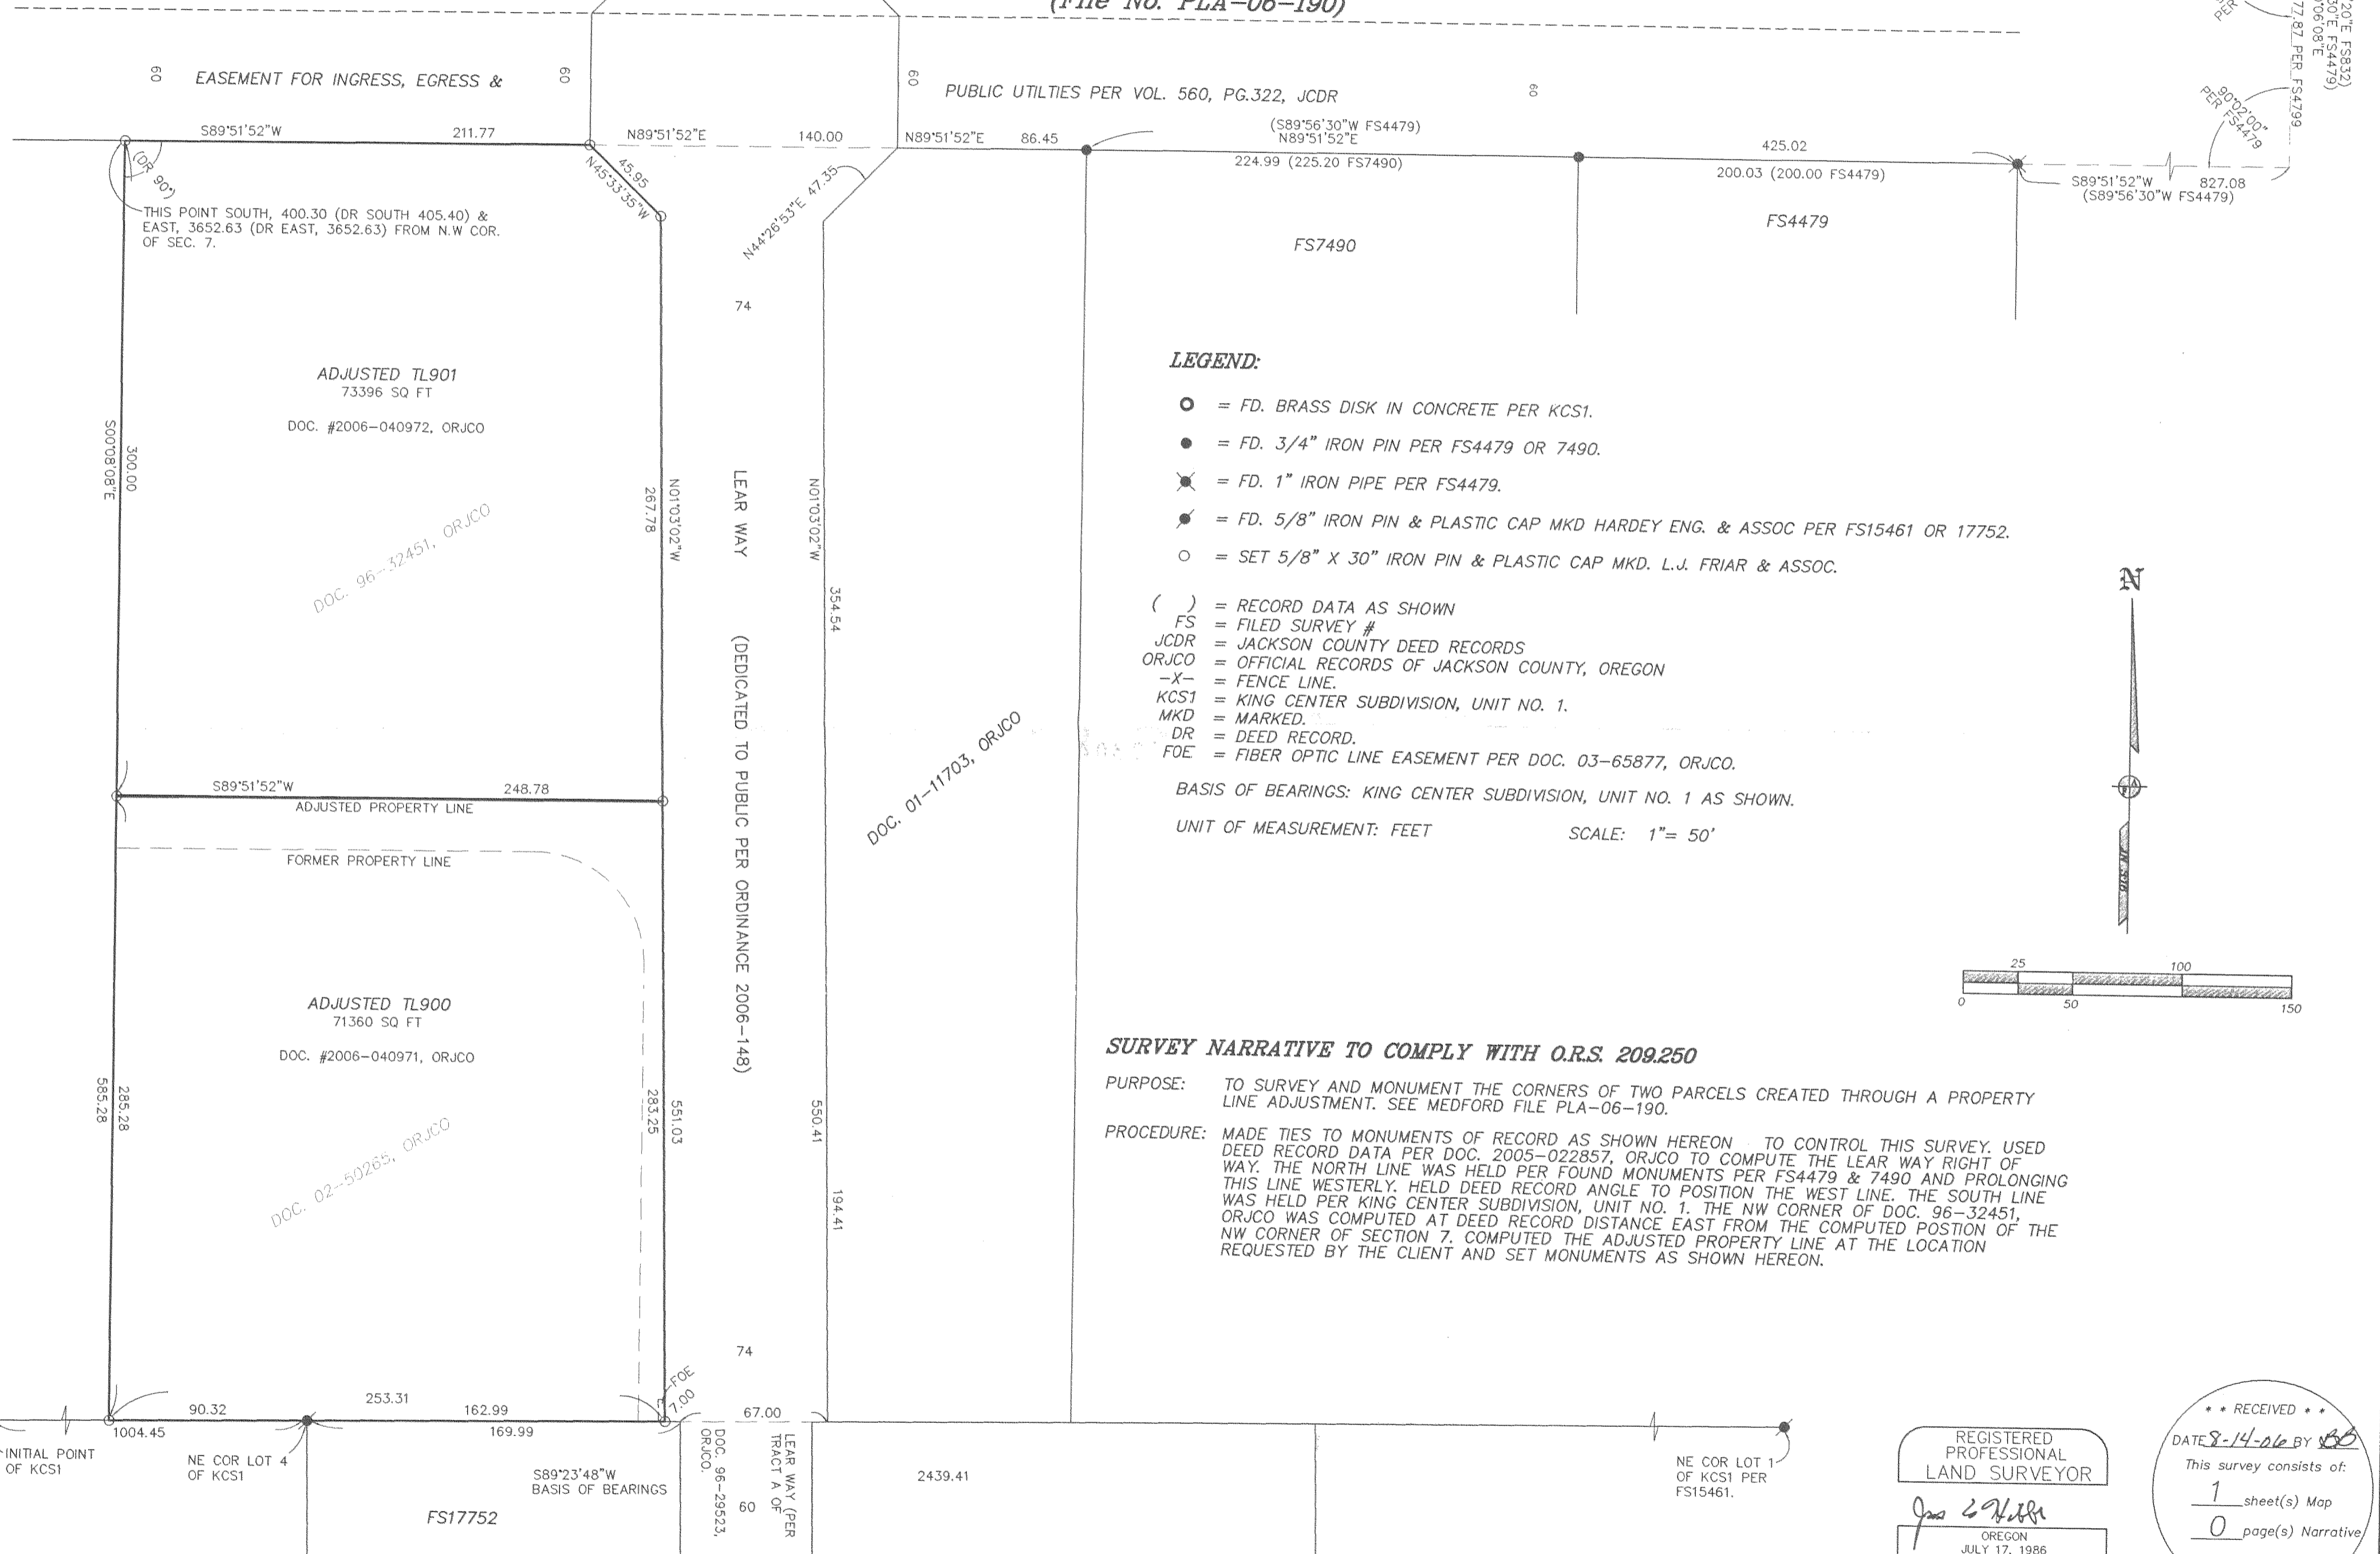

LEGEND:

- = FD. BRASS DISK IN CONCRETE PER KCS1.
- = FD. 3/4" IRON PIN PER FS4479 OR 7490.
- ⊗ = FD. 1" IRON PIPE PER FS4479.
- ⊙ = FD. 5/8" IRON PIN & PLASTIC CAP MKD HARDEY ENG. & ASSOC PER FS15461 OR 17752.
- = SET 5/8" X 30" IRON PIN & PLASTIC CAP MKD. L.J. FRIAR & ASSOC.
- () = RECORD DATA AS SHOWN
- FS = FILED SURVEY #
- JCDR = JACKSON COUNTY DEED RECORDS
- ORJCO = OFFICIAL RECORDS OF JACKSON COUNTY, OREGON
- X- = FENCE LINE.
- KCS1 = KING CENTER SUBDIVISION, UNIT NO. 1.
- MKD = MARKED.
- DR = DEED RECORD.
- FOE = FIBER OPTIC LINE EASEMENT PER DOC. 03-65877, ORJCO.

BASIS OF BEARINGS: KING CENTER SUBDIVISION, UNIT NO. 1 AS SHOWN.
UNIT OF MEASUREMENT: FEET SCALE: 1" = 50'

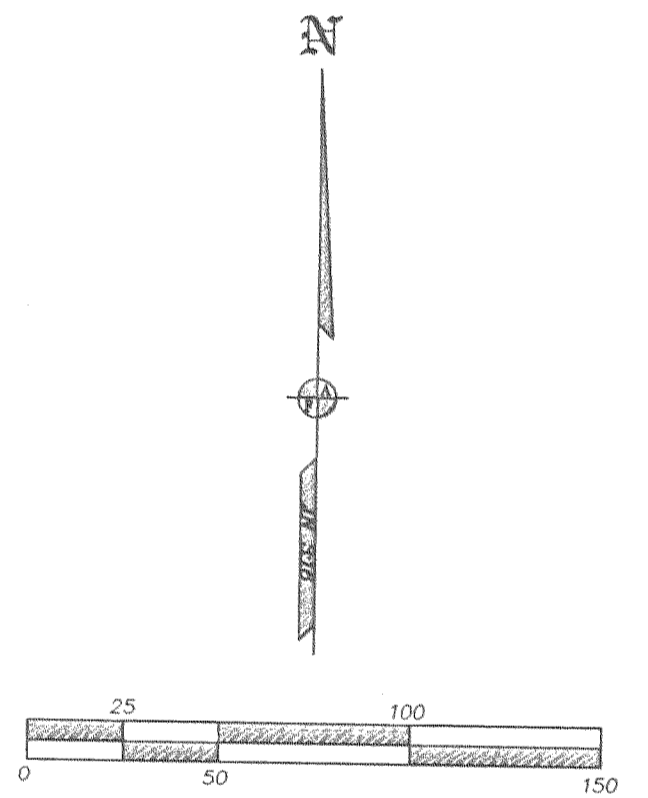

SURVEY NARRATIVE TO COMPLY WITH O.R.S. 209.250

PURPOSE: TO SURVEY AND MONUMENT THE CORNERS OF TWO PARCELS CREATED THROUGH A PROPERTY LINE ADJUSTMENT. SEE MEDFORD FILE PLA-06-190.

PROCEDURE: MADE TIES TO MONUMENTS OF RECORD AS SHOWN HEREON TO CONTROL THIS SURVEY. USED DEED RECORD DATA PER DOC. 2005-022857, ORJCO TO COMPUTE THE LEAR WAY RIGHT OF WAY. THE NORTH LINE WAS HELD PER FOUND MONUMENTS PER FS4479 & 7490 AND PROLONGING THIS LINE WESTERLY. 

REGISTERED
PROFESSIONAL
LAND SURVEYOR

James E. Hibbs

OREGON
JULY 17, 1986
JAMES E. HIBBS
2234
RENEWAL DATE 6-30-07

** RECEIVED **

DATE 8-14-06 BY *JEB*

This survey consists of:

1 sheet(s) Map

0 page(s) Narrative

JACKSON COUNTY
SURVEYOR