


19339

CERTIFIED RECORD OF LAND CORNER MONUMENTATION

History of original corner establishment: T. 32 S., R. 3 W., W. M.
Loyd R. Moffit, Land Surveyor No. 944, established the South 1/16 corner of sections 35 and 36 in 1978 on Jackson County survey No. 7276. He set a 2 inch pipe with 3" brass cap marked: He marked new bearing trees: a 10" fir, bears N. 84° E., 22.3 feet, scribed "S1/16 S36 BT"; and a 10" fir, bears N. 31° W., 16.8 feet, scribed "S1/16 S35 BT"; with a brass tag, stamped "LS 944", nailed to the BT portion of each new bearing tree.

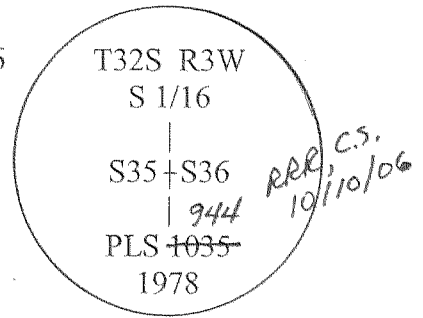

Description of corner evidence found: September 11, 2006
I found a 2 inch outside diameter iron pipe, firmly set, projecting 2 inches above a 3 foot diameter mound of stone, with a 3 inch diameter brass cap marked as shown above.

From which the following bearing trees marked by Moffit in 1978:

- 12" diameter Douglas fir, bears N. 84° E., 22.1 feet (rec. 22.3 feet), with scribe marks "S1/16 S36" and a 3/4" brass washer visible on a partially healed double blaze. The blazed side of the tree has been scorched by a wildfire.
- 12" diameter shattered Douglas fir stump, bears N. 31° W., 16.5 feet (rec. 16.8 feet), with a log alongside with a partially healed double blaze. Blazes are face down and not visible.

Description of monument and accessories I established to perpetuate the original location of this corner: September 11, 2006

I add new accessories for this corner:


- A steel fence post, bears N. 04° E., 3.1 feet, found as a guard post, projecting 4 feet above ground, with Forest Service signs "Property Boundary" (#54-2) and "Land Survey Monument" (#54-9) attached.
- 6" diameter Douglas fir, bears S. 53-1/2° W., 40.4 feet, scribed "S1/16 35 BT" on a single blaze with a 3/4" brass washer, stamped "LS 2150", nailed flush to the base of the blaze.

At the corner point, I used a magnetic declination of 22° East in the staff compass. Bearings are measured to the nearest 1/4°. Trees are measured to the center of the root crown. Tree diameters are at breast height. This corner is in the 1987 Angle Fire. The corner is at the end of a logging trail approximately 800 feet easterly from the intersection of Forest Service roads 3242 and 3242-900.

Witnesses: Michael Vail

My certificate expires June 30, 2007

Leonard E. Herzstein, L.S. 2150
Umpqua National Forest
2900 NW Stewart Parkway
Roseburg, OR 97470

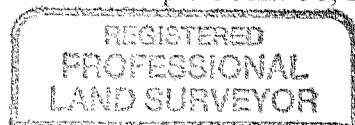

LEH 09/14/06

