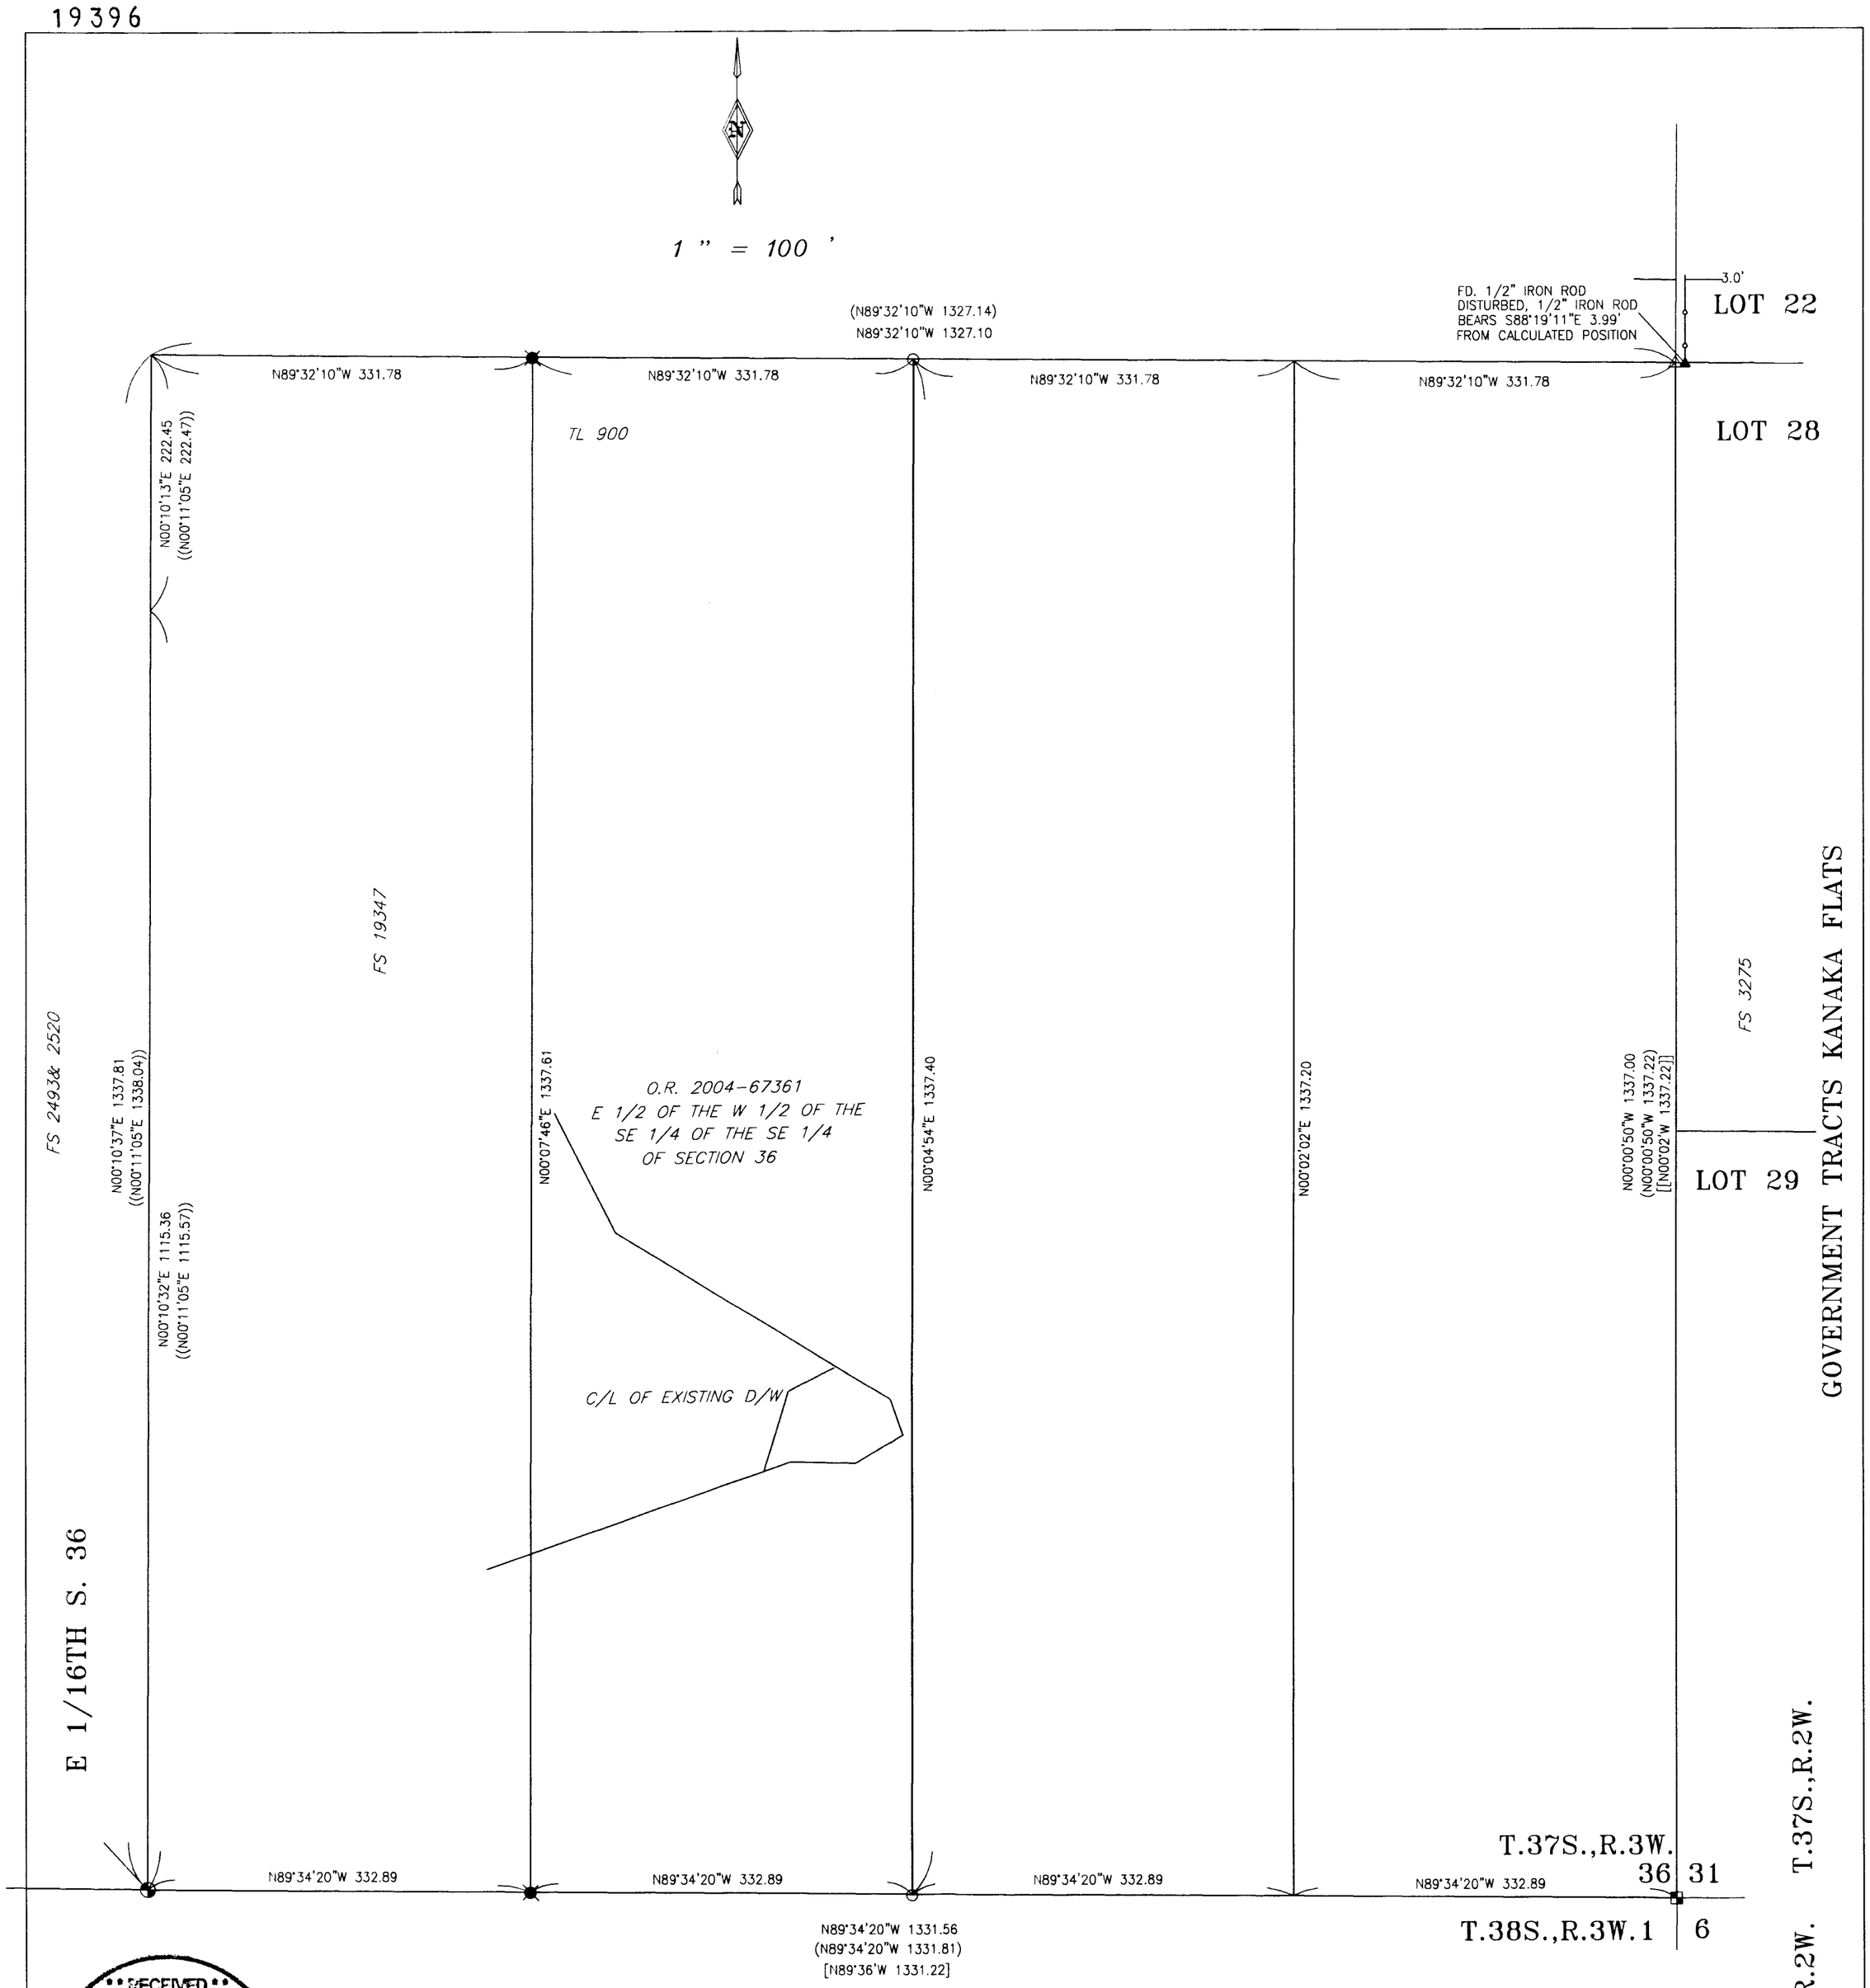

RECEIVED
Date 11-1-06 By
This survey Consists of:
1 sheet(s) Map
0 page(s) Narrative
JACKSON COUNTY SURVEYOR

LEGEND

- ○ SET 5/8" X 30" REBAR WITH PLASTIC CAP MARKED "TEMPLIN LS2359"
- FD. 5/8" X 30" REBAR WITH PLASTIC CAP MARKED "TEMPLIN LS2359" PER FS 19347
- FD. STANDARD B.L.M. BRASS CAP MONUMENT, PER B.L.M. RECORD
- FD. JACKSON COUNTY BRASS CAP MONUMENT, PER JACKSON COUNTY RE-ESTABLISHMENT
- ● FD. 5/8" REBAR PER F.S. # 2520
- ▲ FD. 1/2" IRON ROD PER F.S. # 3275, LOOSE AND AGAINST FENCE POST,PRESUMED MOVED
- △ INDICATES CALCULATED POSITION, NO MONUMENT SET THIS SURVEY
- ( ) INDICATES RECORD DATA PER FILED SURVEY NUMBER 2493
- (( )) INDICATES RECORD DATA PER FILED SURVEY NUMBER 2520
- [[ ]] INDICATES RECORD DATA PER FILED SURVEY NUMBER 3275
- [ ] INDICATES RECORD DATA PER OFFICIAL B.L.M. SURVEY
- INDICATES EXISTING FENCE
- FS INDICATES FILED SURVEY

BASIS OF BEARING: SOUTH LINE OF SECTION 36 PER F.S. # 19347

SURVEY NARRATIVE

PURPOSE: To survey, monument and mark the the East line of Instrument number 2004-67361 of the Official Records of Jackson County, Oregon.

PROCEDURE: Utilizing control from filed survey 19347 performed by this office, I computed and set the Northeast and Southeast corners of the Instrument number 2004-67361, recorded in the Official Records of Jackson County, Oregon. Spikes and wood stakes were set along the East line every 100 feet more or less of said Instrument number 2004-67361 for possible future fence building.

REGISTERED PROFESSIONAL LAND SURVEYOR
OREGON JULY 26, 1988 RICHARD G. TEMPLIN 2359
RENEWAL DATE: 6-30-08

RICHARD TEMPLIN LAND SURVEYING
P.O. BOX 1946 899-2032 JACKSONVILLE, OREGON 97530

MAP OF SURVEY
LOCATED IN
SE 1/4 OF THE SE 1/4 OF SECTION 36, T.37S.,R.3W.,W.M.
JACKSON COUNTY, OREGON

SURVEYED FOR: MR. JASON ALEXANDER
624 WAGON TRAIL DR.
JACKSONVILLE, OR. 97530

DATE: OCTOBER 25, 2006

37-3W-36D TL 900