MAP OF SURVEY

FOR


JOHN W. ROELFS, RT. 4, 410 R, MEDFORD, ORE. IN SEC. 11 ! 12, T. 385., R. 2 W. W.M.

JACKSON CO. OREGON.

DATE: 4-27-62

SCALE: 1"=100"

SOLAR DATUM

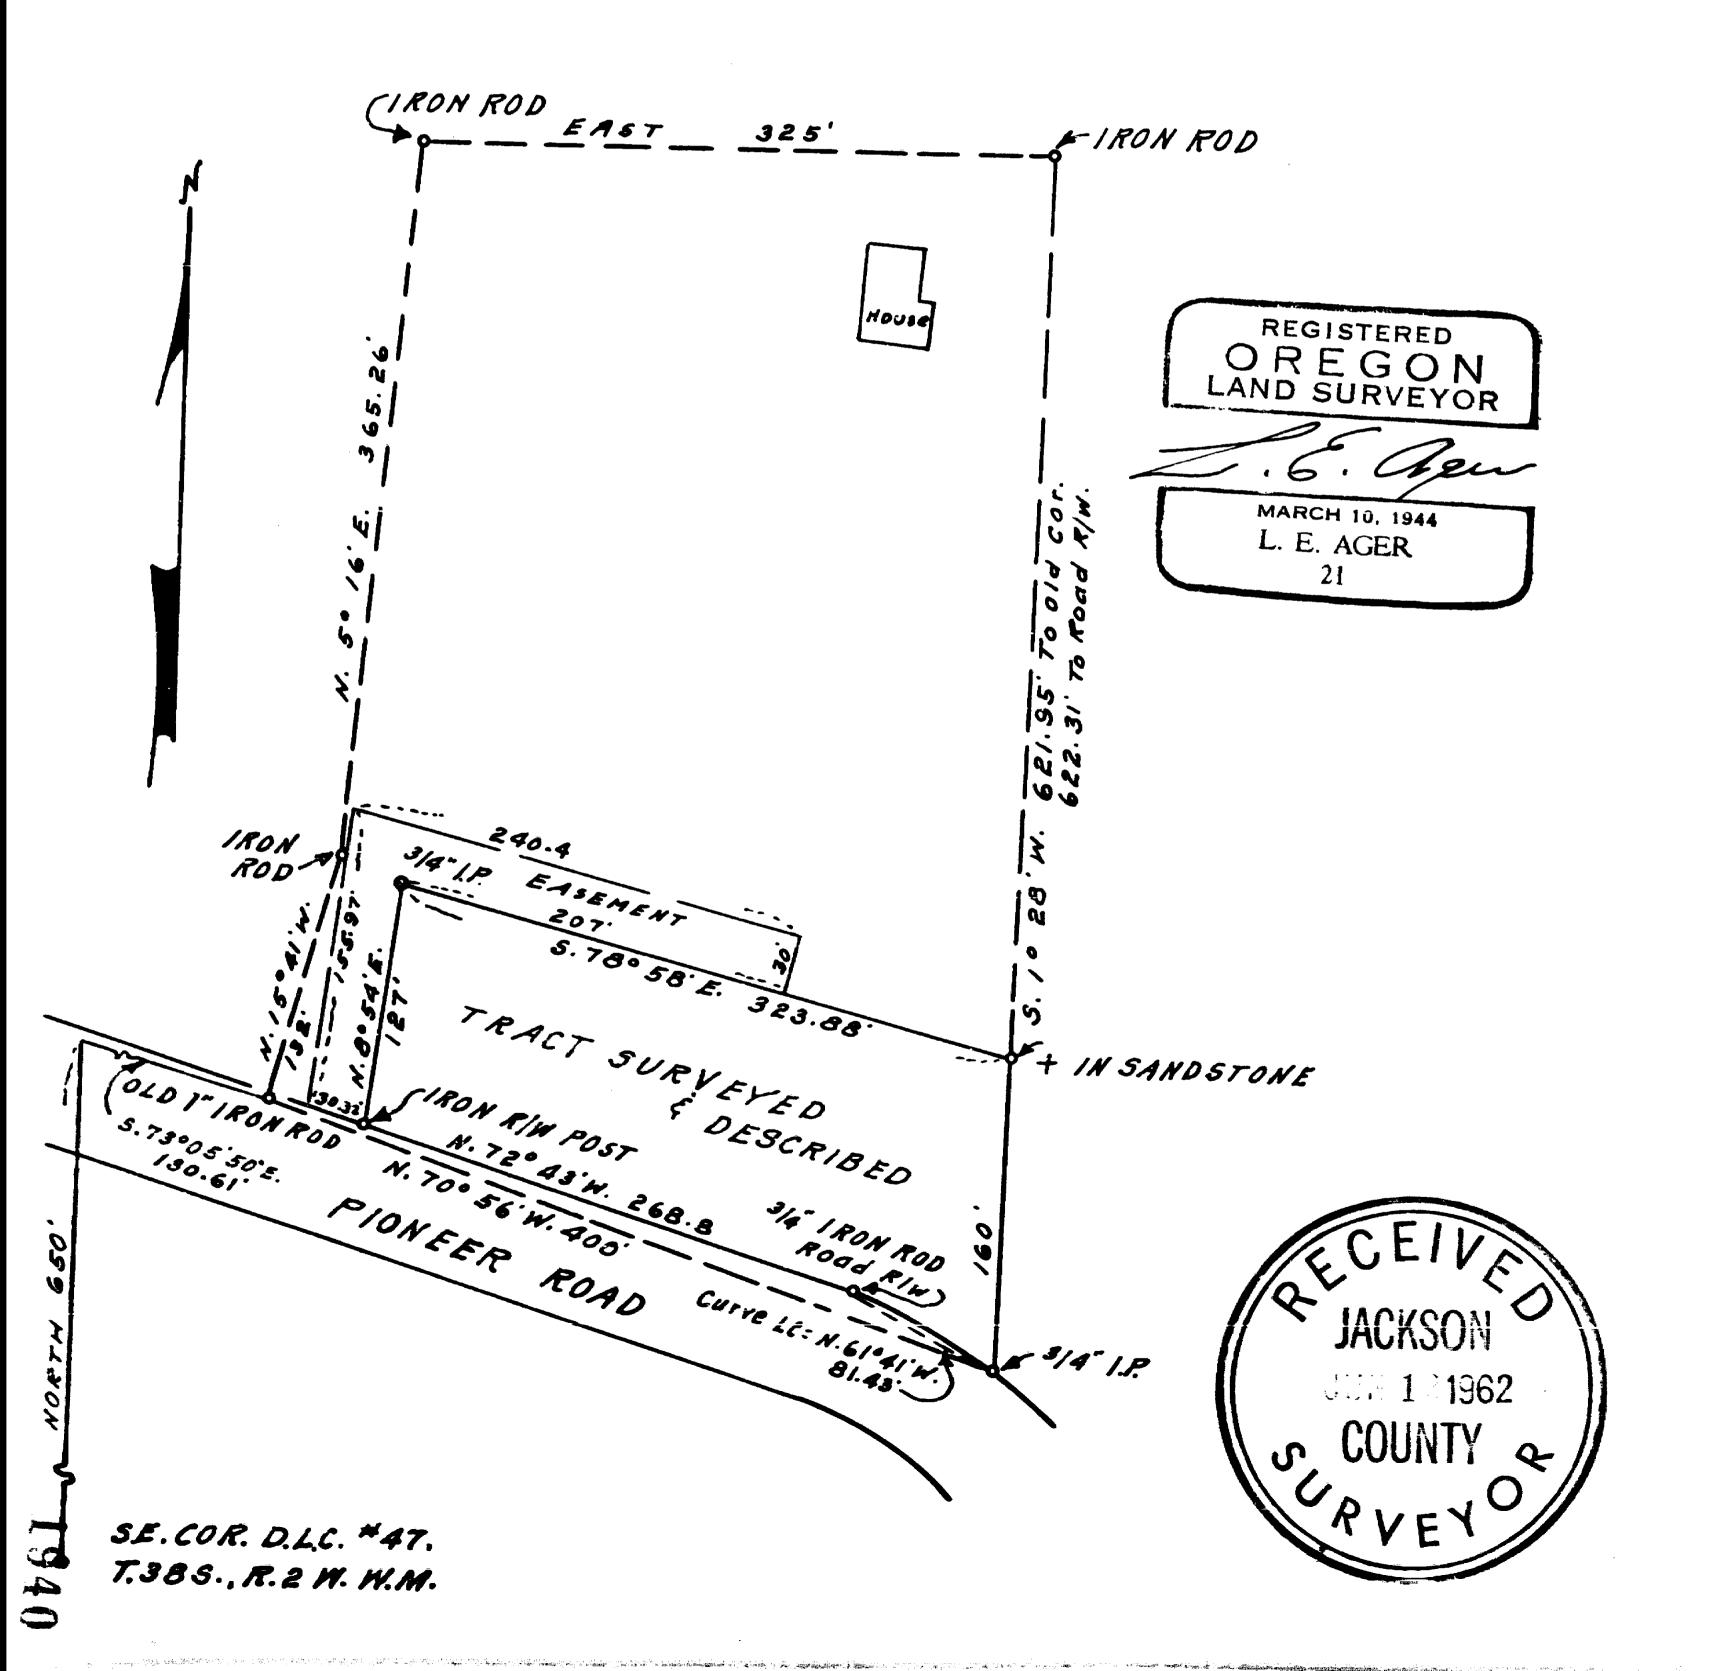

Survey narrative to comply with ORS 209.250, Oregon State Law

For: John W. Roelfs, Rt. 4, Box 410R. Medford, Oregon.

Purpose: To mark the boundaries of tract shown.

Proceedure: The boundaries of the original tract had been previously surveyed and all corners set, which I used for my survey. The Southerly line of the property extended within the boundary of the Pioneer Road as now located but for my survey I used the Northerly line of the relocated road for the southerly line of tract shown.

