
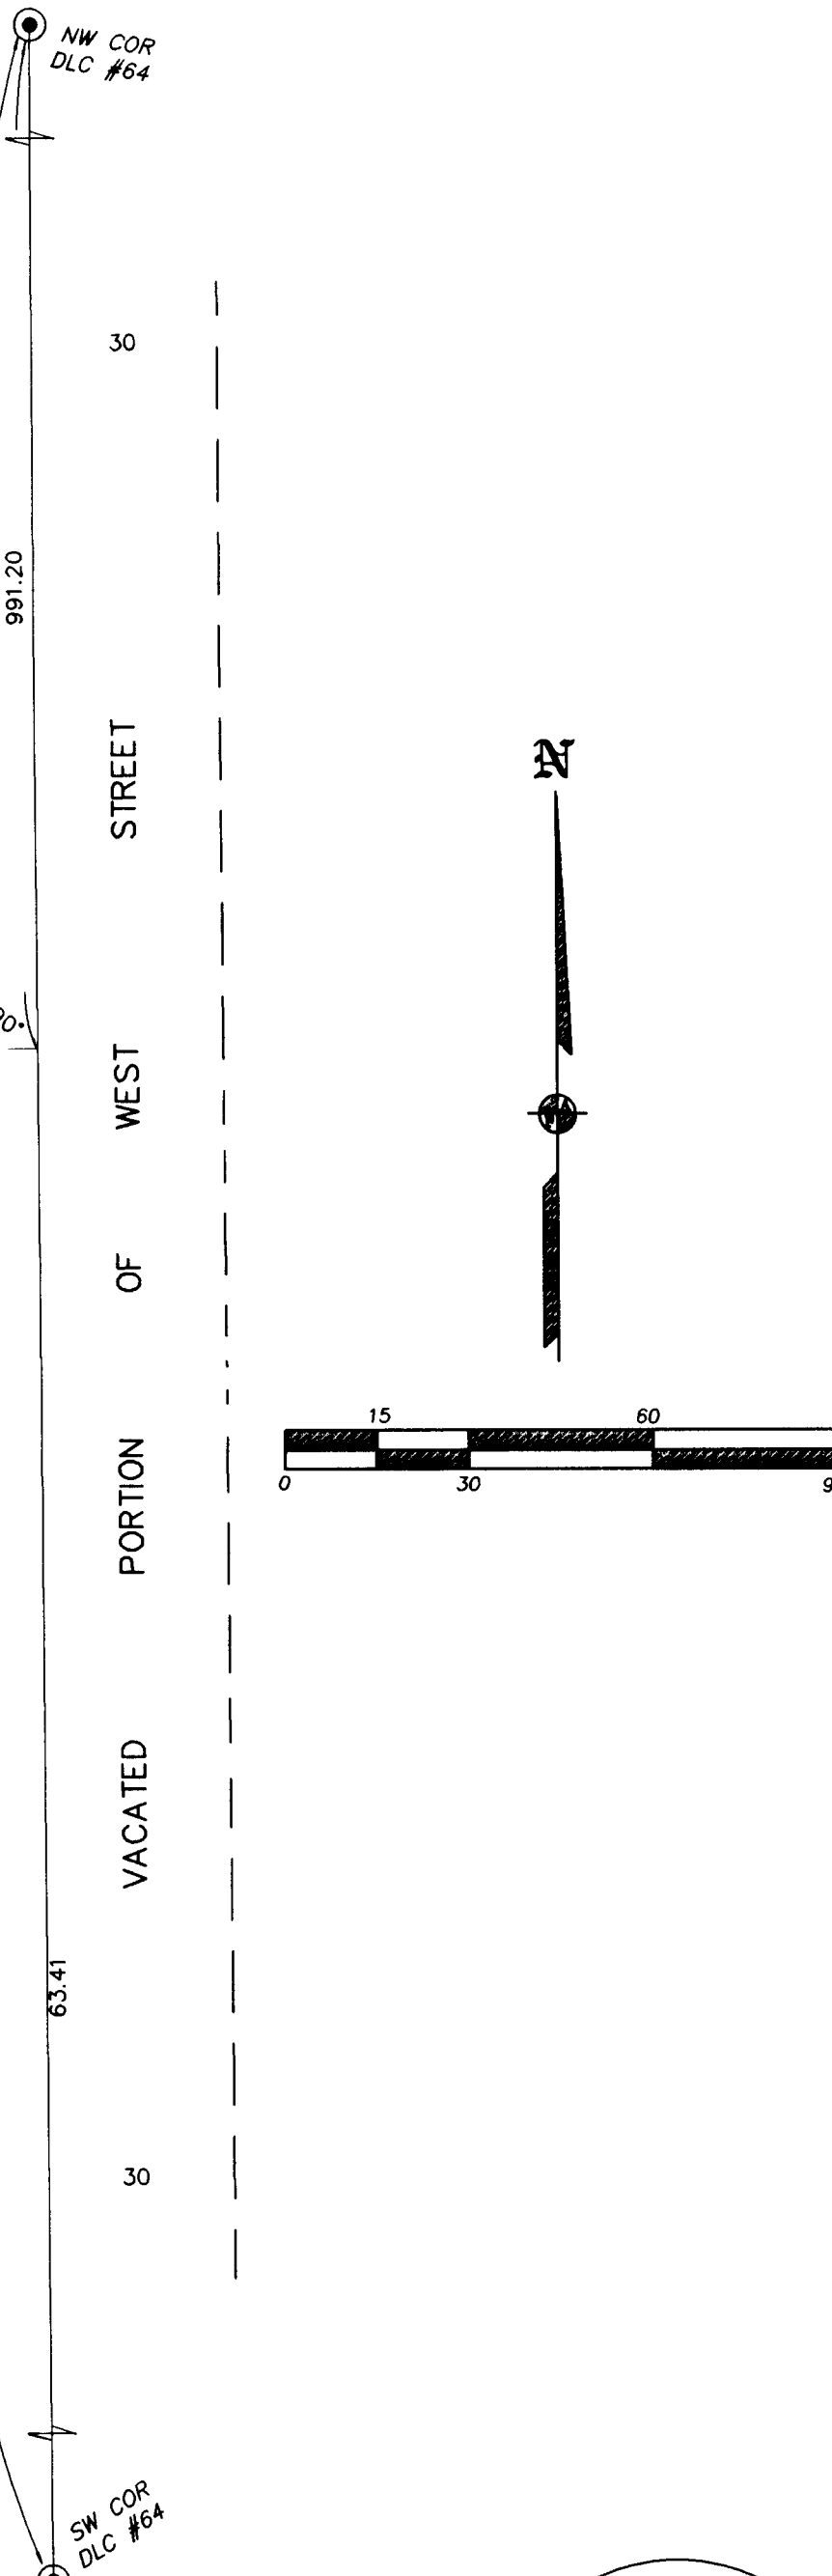
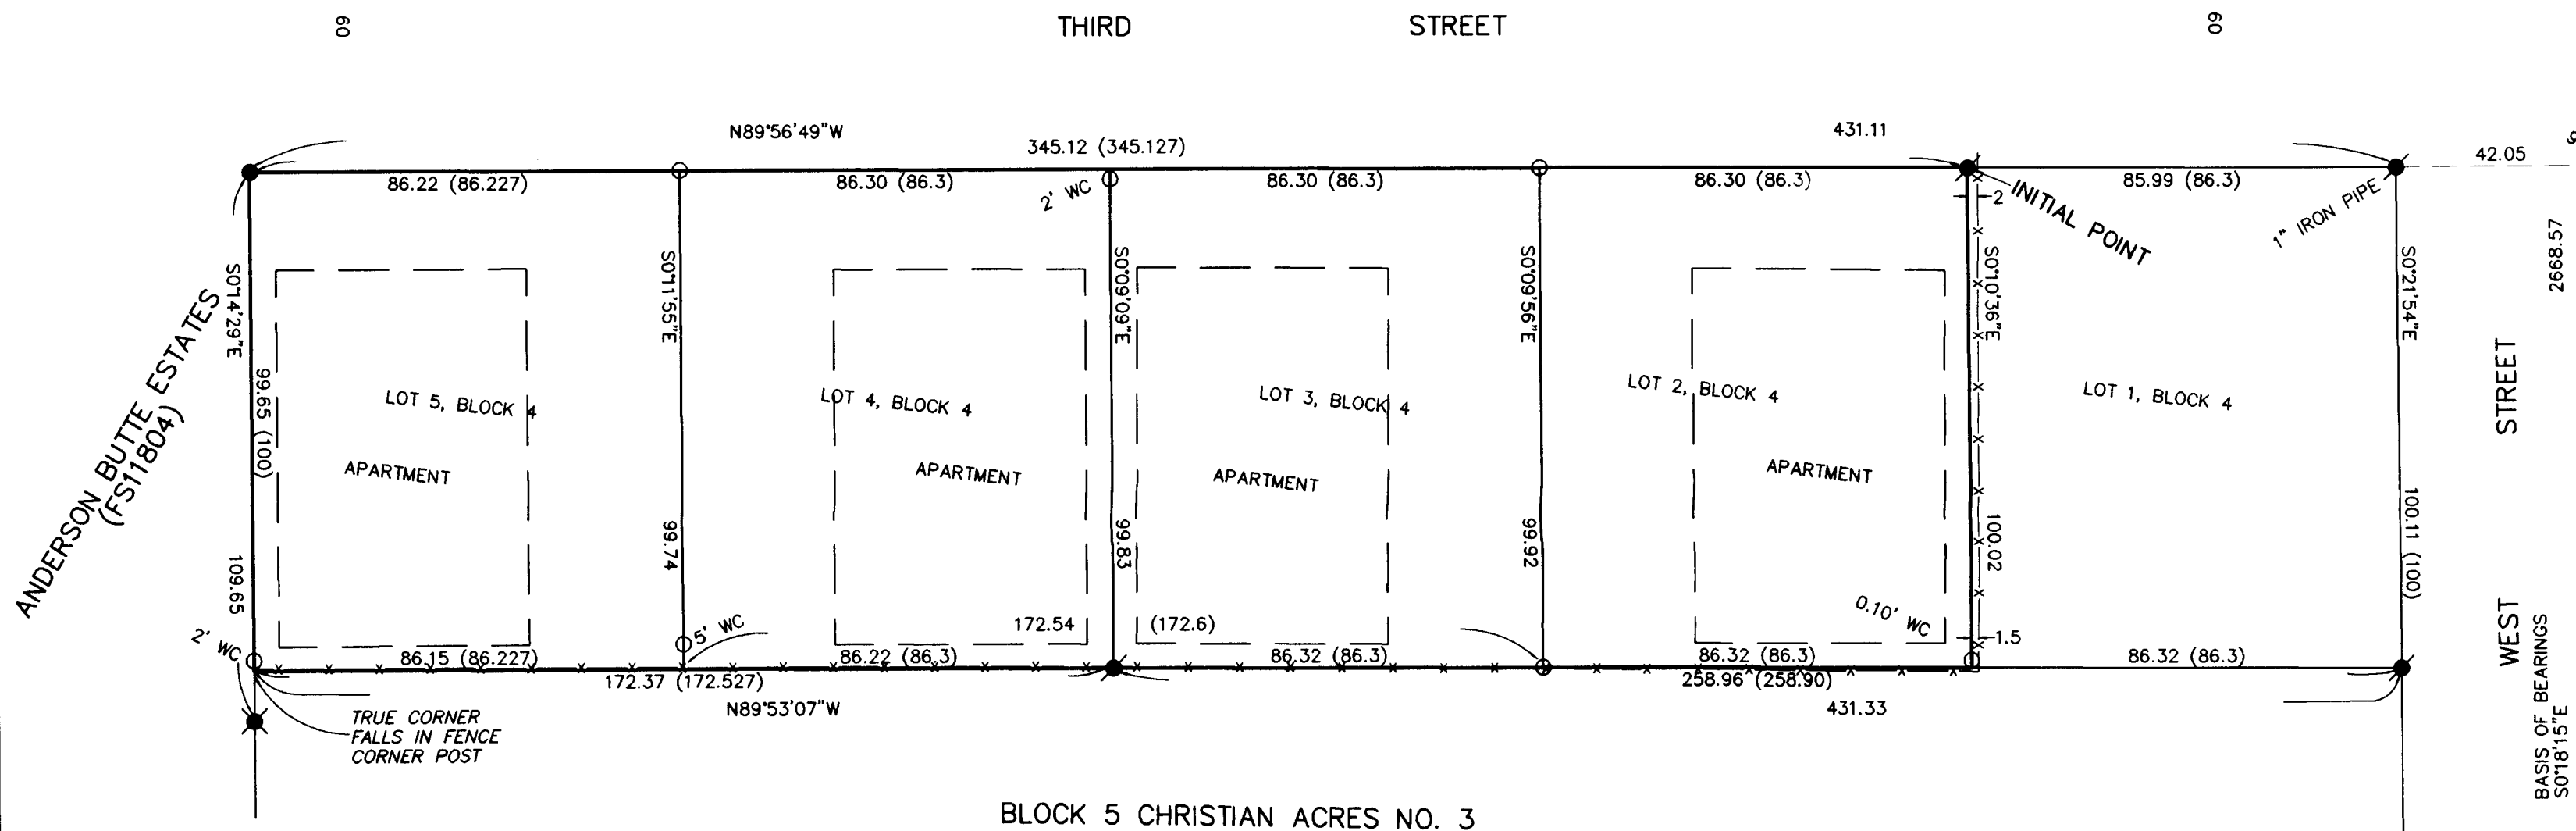


SURVEY BY:
 L.J. FRIAR & ASSOCIATES, P.C.
 CONSULTING LAND SURVEYORS
 816 WEST EIGHTH STREET
 MEDFORD, OREGON 97501
 PHONE: (541) 772-2782
 EMAIL: LJFRIAR@CHARTER.NET

MAP OF SURVEY
 In Lots 2, 3, 4 & 5 of Block 4, CHRISTIAN ACRES NO. 2
 & located in the N.W. 1/4 of Sec. 26, T.38S, R.1W., W.M.,
 City of Talent Jackson County, Oregon.
 for
 Philip & Sharon Thormahlen
 10 Montecito Road
 San Rafael, CA 94901

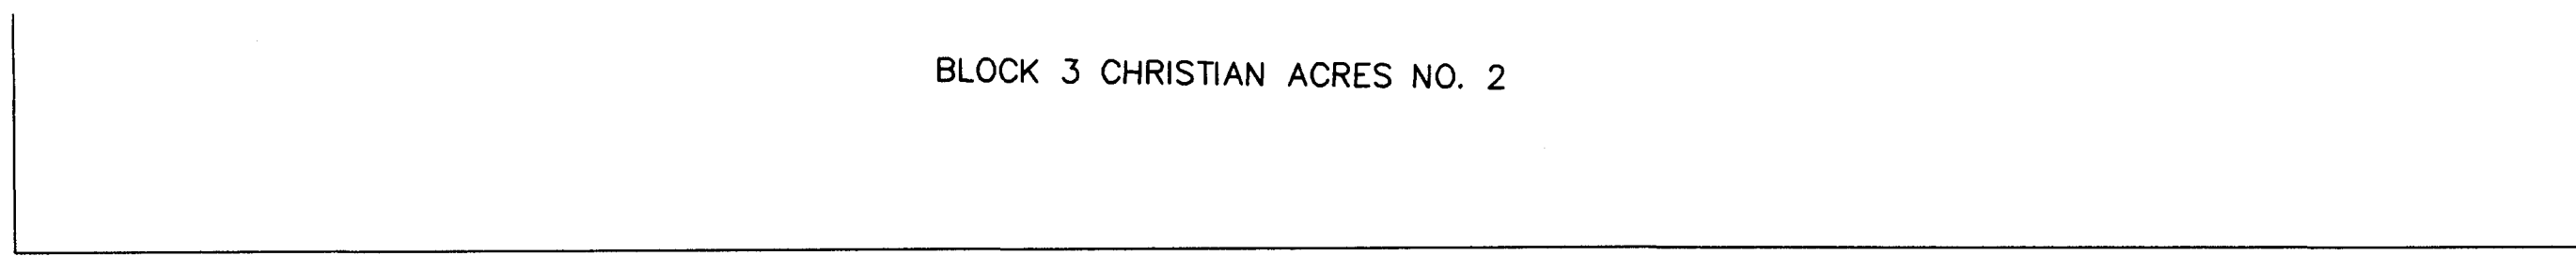

LEGEND:

- ⊙ = FD. COUNTY SURVEYOR'S BRASS CAPPED MONUMENT PER RE-ESTAB'S.
- = FD. 5/8" IRON PIN W/ PLASTIC CAP MKD. MCMAHAN LS1913 PER ABE.
- ⦿ = FD. 1/2" IRON PIPE PER CA2 OR MONUMENT AS NOTED PER CA2.
- ⊗ = FD. 5/8" IRON PIN W/ PLASTIC CAP MKD. MCMAHAN LS1913 PER ABE.
- = SET 5/8" X 30" IRON PIN W/ PLASTIC CAP MKD. L.J. & ASSOC.
- JC DR = JACKSON COUNTY DEED RECORDS.
- ABE = ANDERSON BUTTE ESTATES (FS11804).
- X- = FENCE LINE.
- ORJCO = OFFICIAL RECORDS OF JACKSON COUNTY, OREGON.
- FS = FILED SURVEY.
- CA2 = CHRISTIAN ACRES NO. 2.

BASIS OF BEARINGS:

WEST LINE DLC #64 PER FS17873.

UNIT OF MEASUREMENT = FEET DATE: NOVEMBER 2, 2006 SCALE: 1" = 30'

SURVEY NARRATIVE TO COMPLY WITH O.R.S. 209.250

PURPOSE: To survey and monument the corners of Lots 2, 3, 4 and 5 of Block 4, CHRISTIAN ACRES, NO. 2.

PROCEDURE: Made ties to the existing Subdivision monuments as shown hereon to control the subject tract. Used proportionate method to compute the location of the missing lot corners. Set pins at the locations shown hereon. To re-establish the tax lot boundaries segregation deeds were recorded as listed below.

SEGREGATION DEEDS:

- LOT 2 = DOC. #2005-000307, ORJCO
- LOT 3 = DOC. #2005-000308, ORJCO
- LOT 4 = DOC. #2005-000309, ORJCO
- LOT 5 = DOC. #2005-000310, ORJCO

MUTUAL RECIPROCAL EASEMENT AGREEMENTS:

- LOTS 2 & 3 = DOC. #2004-074151, ORJCO
- LOTS 4 & 5 = DOC. #2004-074150, ORJCO

REGISTERED PROFESSIONAL LAND SURVEYOR

James E. Hibbs
 OREGON
 JULY 17, 1986
 JAMES E. HIBBS
 2234
 EXPIRES 6-30-07

** RECEIVED **
 DATE 11-6-06 BY AB
 This survey consists of:
1 sheet(s) Map
0 page(s) Narrative
 JACKSON COUNTY SURVEYOR