

SILVER CREEK DRIVE


GRIFFIN OAKS UNIT NO. 2, PHASES II AND III
VOL 28, PG 23 S/N 17299

MAP OF SURVEY

located in the
NORTHEAST ONE QUARTER OF THE
NORTHWEST ONE QUARTER OF SECTION 10,
TOWNSHIP 37 SOUTH, RANGE 2 WEST,
WILLAMETTE MERIDIAN, JACKSON COUNTY, OREGON

for LEROY BURKHART

2167 TAYLOR ROAD
CENTRAL POINT, OREGON 97502

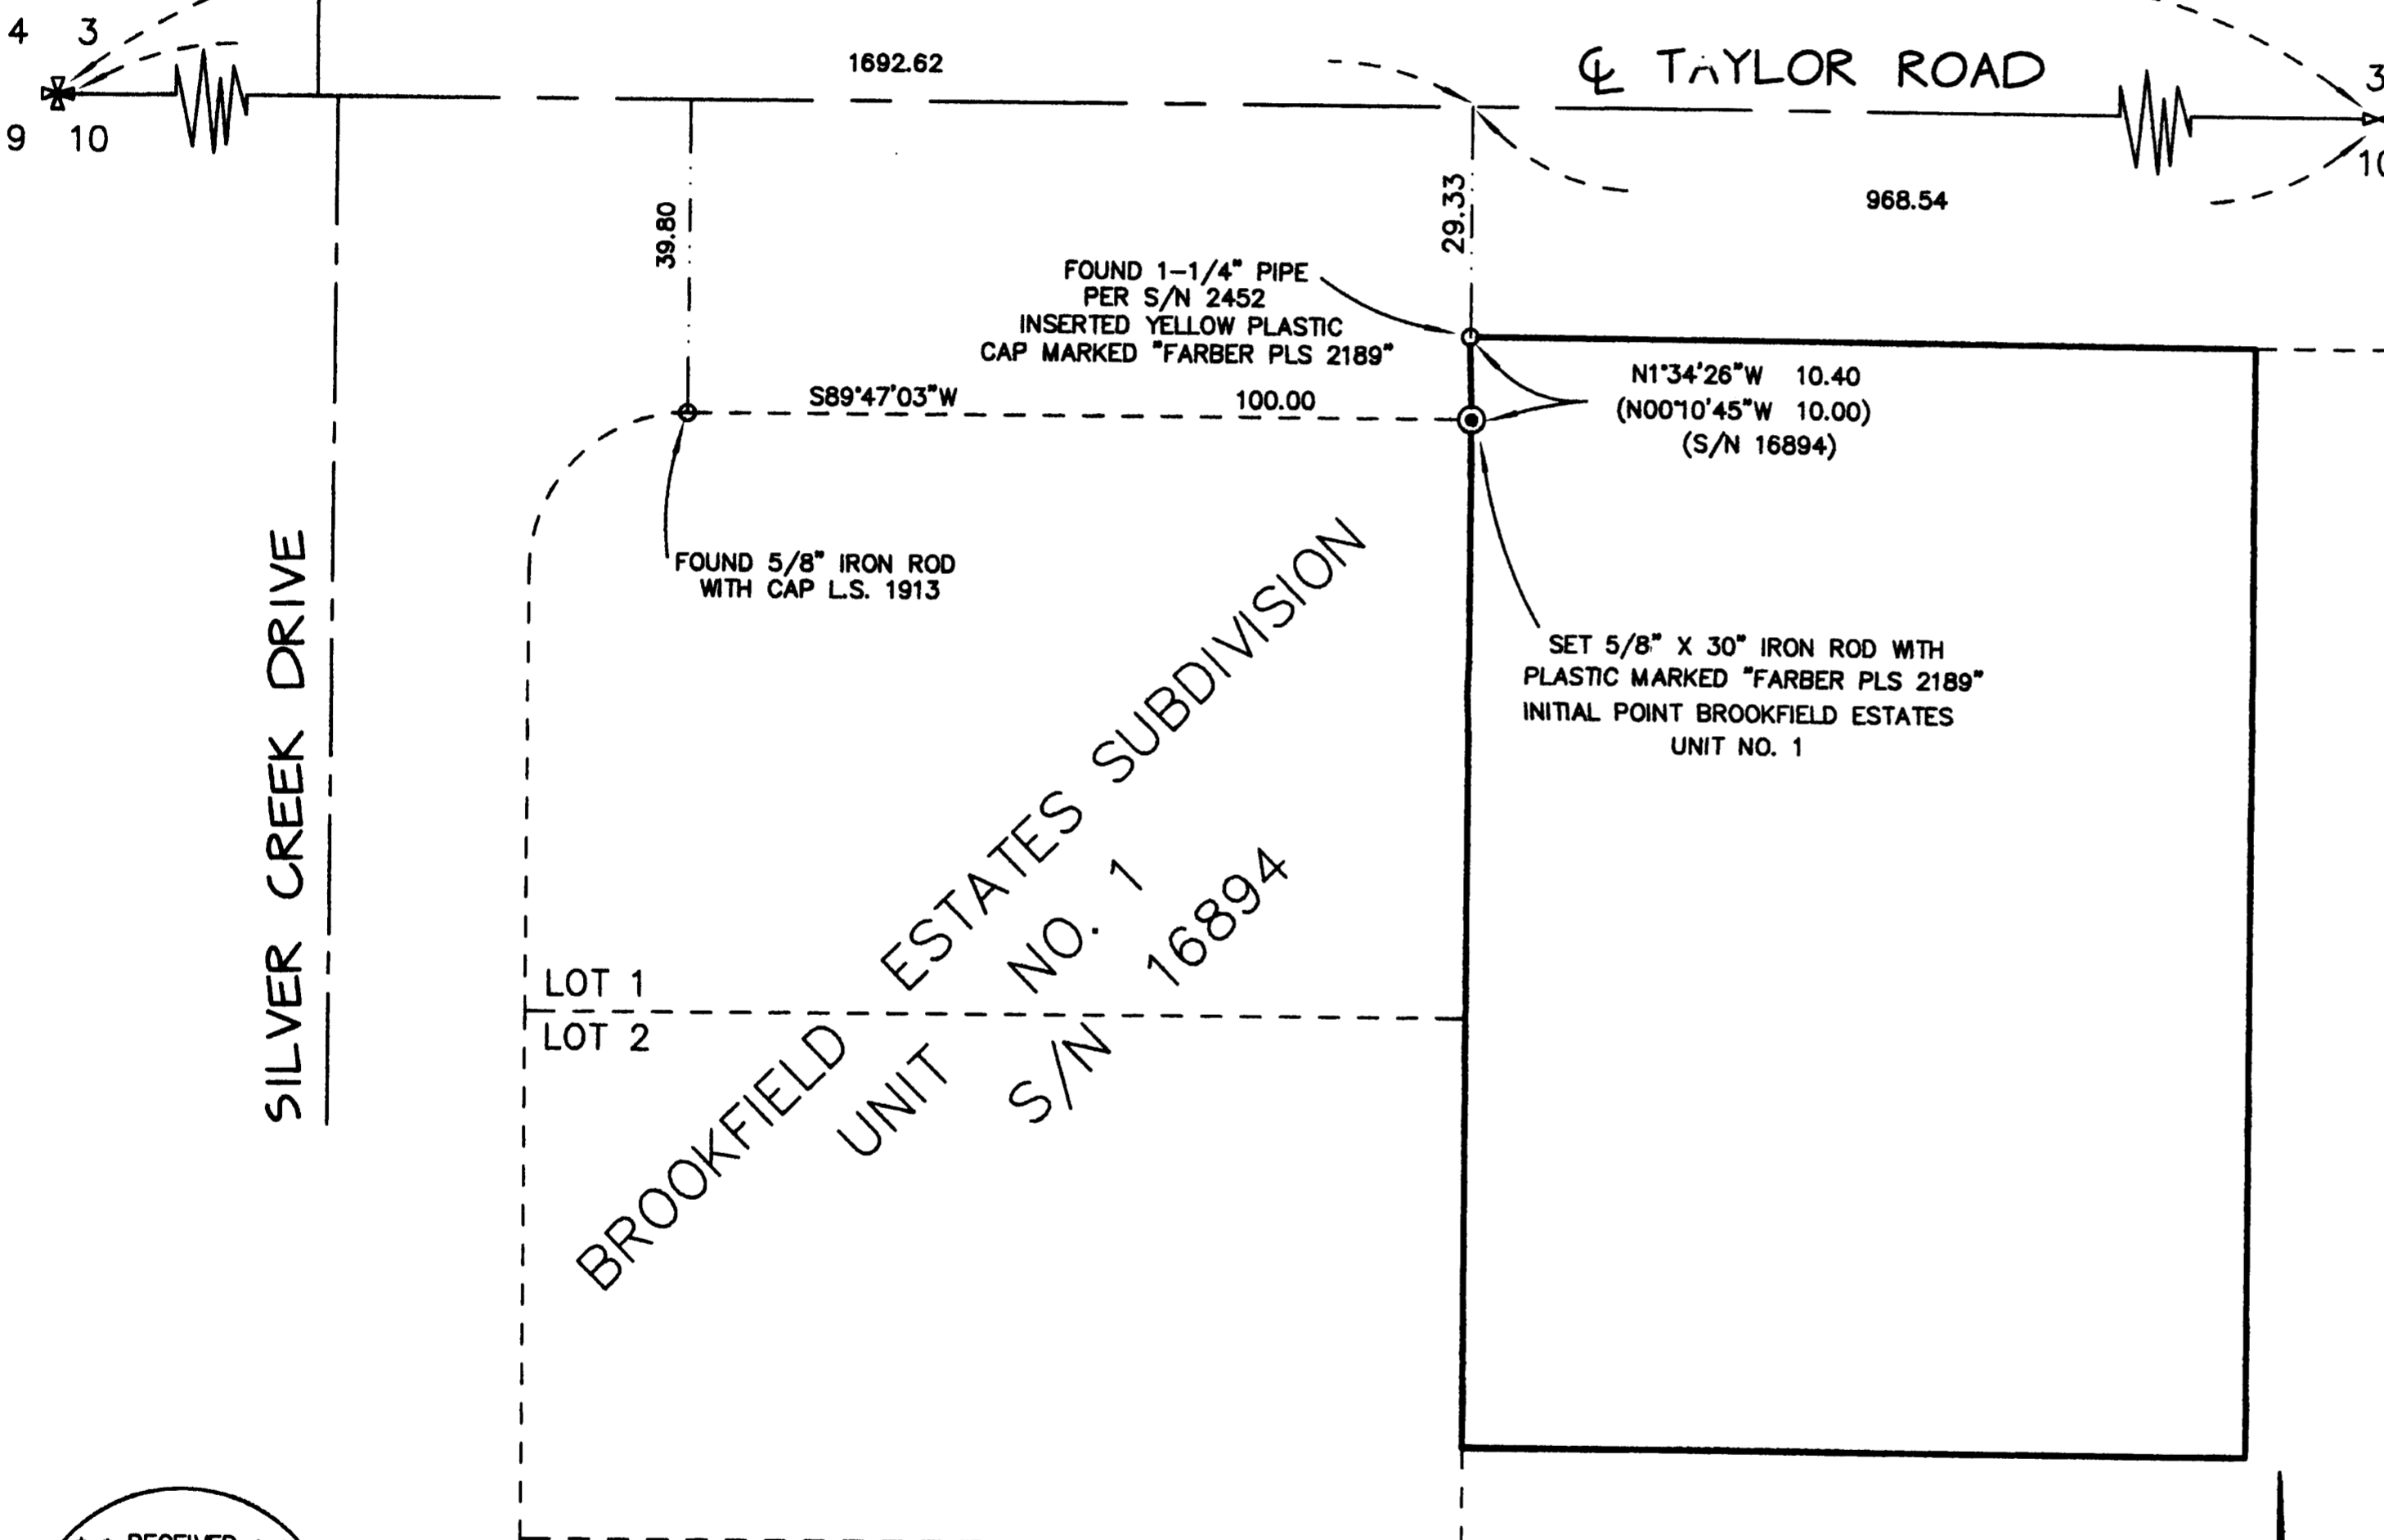

LEGEND


- = FOUND 5/8" IRON PIN, L.S. 1913 (OR AS NOTED)
- ⊙ = SET 5/8" x 30" IRON PIN w/ YELLOW PLASTIC CAP MARKED "FARBER PLS 2189"
- ⊕ = FOUND BRASS CAP PER JACKSON COUNTY SURVEYORS RE-ESTAB. NOTES
- ⊗ = FOUND BRASS CAP PER JACKSON COUNTY SURVEYORS RE-ESTAB. NOTES 1/4 CORNER
- S/N = RECORD FILED SURVEY NUMBER
- BASIS OF BEARING IS TRUE NORTH, NAD 83/91 DATUM, AS DERIVED BY GLOBAL POSITIONING SYSTEM OBSERVATIONS.
- RECORD SURVEY DATA IS SHOWN IN PARENTHESIS ADJACENT TO MEASURED SURVEY DATA WHERE APPLICABLE.
- INST. No. = INSTRUMENT NUMBER AS RECORDED IN THE OFFICIAL RECORDS OF JACKSON COUNTY, OREGON.

SURVEY NARRATIVE TO COMPLY WITH O.R.S. 209.250

PURPOSE: TO RE-ESTABLISH THE INITIAL POINT MONUMENT OF BROOKFIELD ESTATES SUBDIVISION, UNIT NO. 1, PER CLIENTS REQUEST. THE ORIGINAL INITIAL POINT MONUMENT WAS DESTROYED BY AN AUTOMOBILE ACCIDENT.

PROCEDURE: UTILIZING GLOBAL POSITIONING SYSTEMS CONTROL FROM PREVIOUS SURVEY NUMBER 17299, I RE-SET THE MONUMENT AS SHOWN. THE ORIGINAL BRASS DISC MONUMENT SET IN CONCRETE, THAT I HAD TIED IN ~~THE~~ PREVIOUS SURVEY, WAS RE-MONUMENTED WITH A 5/8" x 30" IRON PIN WITH YELLOW PLASTIC CAP MARKED "FARBER PLS 2189" AND WAS SET AT THE PREVIOUSLY TIED POSITION.

Surveyed by:
FARBER & SONS, INC.
dba FARBER SURVEYING
(541) 664-5599
PO BOX 5286
431 OAK STREET
CENTRAL POINT, OREGON 97502

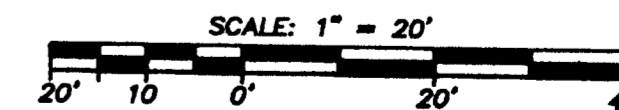

DATE: NOVEMBER 7, 2006
JOB NO.: 1437-06

DRAWING FILE: JOBS\CENTRAL POINT\BURKHART\MICROSURVEY\FINAL PLATS\BURKHART MOS.DWG

RECEIVED
DATE 12-1-06 BY [Signature]
This survey consists of:
1 sheet(s) Map
2 page(s) Narrative
JACKSON COUNTY SURVEYOR

REGISTERED PROFESSIONAL LAND SURVEYOR

[Signature]
OREGON
JULY 28, 1985
HERBERT A. FARBER
2189

RENEWAL DATE 12-31-07