

NARRATIVE


PURPOSE: To survey and mark the corners of Instrument number 95-18635 of the Official Records of Jackson County, Oregon.

PROCEDURE: I found and tied monuments found and set on filed survey number 8681. The Center 1/4 corner position of Section 8 was computed, but not set on said filed survey number 8681. Ties to the SW corner of Section 8, W 1/4, W 1/16th on the South line of Section 8 and S 1/4 found their location to be very close to the record of filed survey number 8681. I utilized the record data to compute the breakdown of the Southwest 1/4 of Section 8. In the course of researching the surrounding deeds I interpret the intent of the deeds to follow the quarter section lines, even though they call out 330 feet and 660 feet. Encroachments were tied in and the surrounding property owners are in harmony about a Property Line Adjustment to correct the encroachment problem.

LEGEND

- SET 5/8" X 30" REBAR WITH PLASTIC CAP MARKED "TEMPLIN LS2359"
- FD. STANDARD BLM PIPE AND BRASS CAP MONUMENT
- ⊙ FD. BRASS CAP MONUMENT PER F.S # 8681
- FD. BRASS CAP MONUMENT PER JACKSON COUNTY REESTABLISHMENT
- △ INDICATES CALCULATED POSITION
- () INDICATES RECORD DATA PER FS 8681
- FS INDICATES FILED SURVEY

BASIS OF BEARING: THE WEST LINE OF SW 1/4 OF SECTION 8 PER F.S. 8681

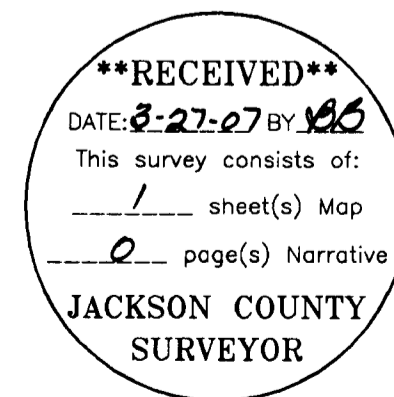

REGISTERED PROFESSIONAL LAND SURVEYOR
 [Signature]
 OREGON
 JULY 25, 1988
 RICHARD G. TEMPLIN
 2359
 MY CERTIFICATE EXPIRES
 JUNE 30, 2008

FILE: "knott mar25.dwg"

RICHARD TEMPLIN LAND SURVEYING
 P.O. BOX 1946 899-2032 JACKSONVILLE, OREGON

MAP OF SURVEY
 LOCATED IN
 IN THE SE 1/4 OF THE SW 1/4 OF SECTION 8,
 T.40S., R.3W., W.M., JACKSON COUNTY, OREGON

For: Mr. Retta Knott
 P.O. Box 430
 Jacksonville, Or. 97530

DATE: MARCH 25, 2007