




DATE: 3-27-2007
SCALE: 1"=300'

MAP OF SURVEY



LOCATED IN:
THE NW 1/4 OF SECTION 8, TOWNSHIP 39 SOUTH
RANGE 1 EAST, WILLAMETTE MERIDIAN
JACKSON COUNTY, OREGON

SURVEY FOR:
JASON & KIRSTEN COUCH
1 BIRNAM WOOD ROAD
ASHLAND, OREGON

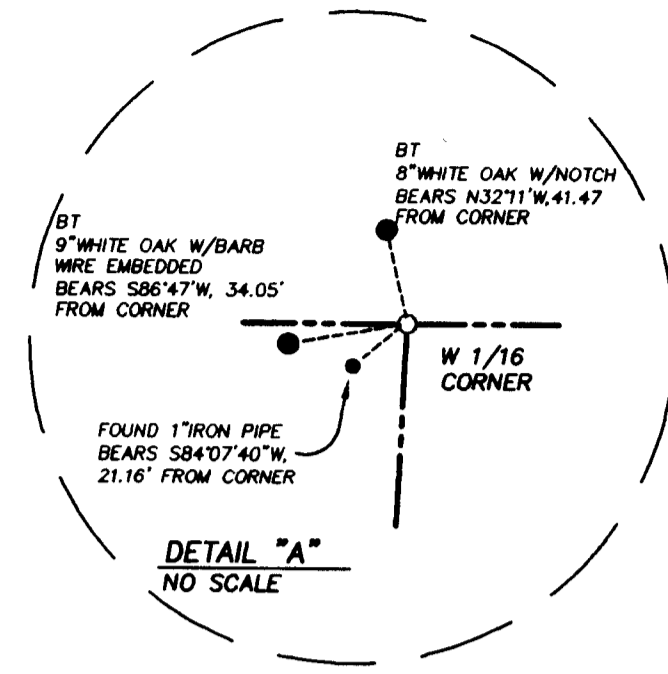

PT "B"
1/4 CORNER
FOUND 3" BRASS DISC W/PUNCH STAMPED
"CITY OF ASHLAND SURVEY MARKER T395
R1E 1/4 COR 5/8 LS 759 1996"
REF: FS 14908

PT "A"
SECTION CORNER
FOUND 2" BRASS DISC W/PUNCH STAMPED
"T 39 S R 1 E 6 1/8 PLS 759, 1970"
REF: FS 4407

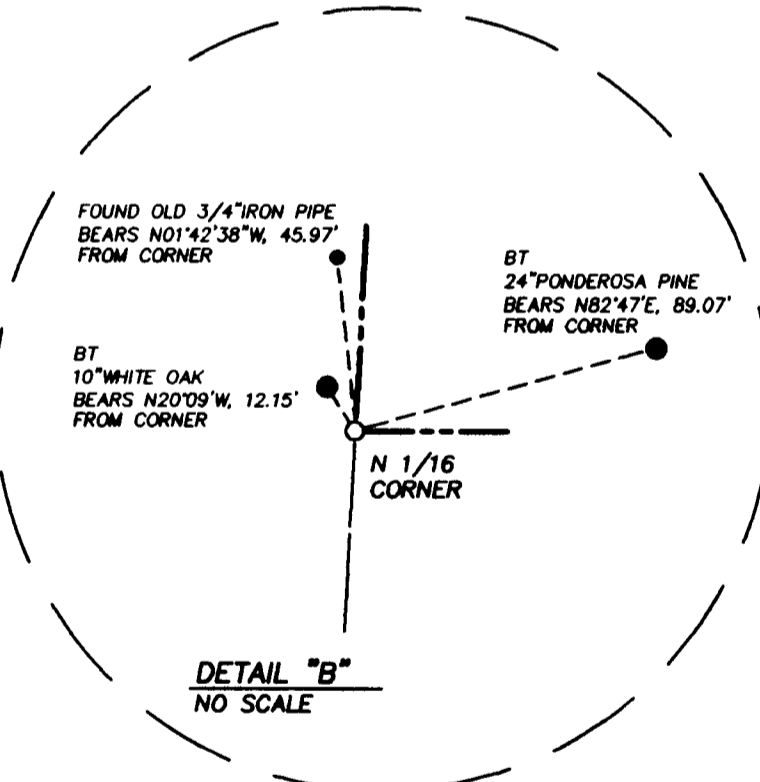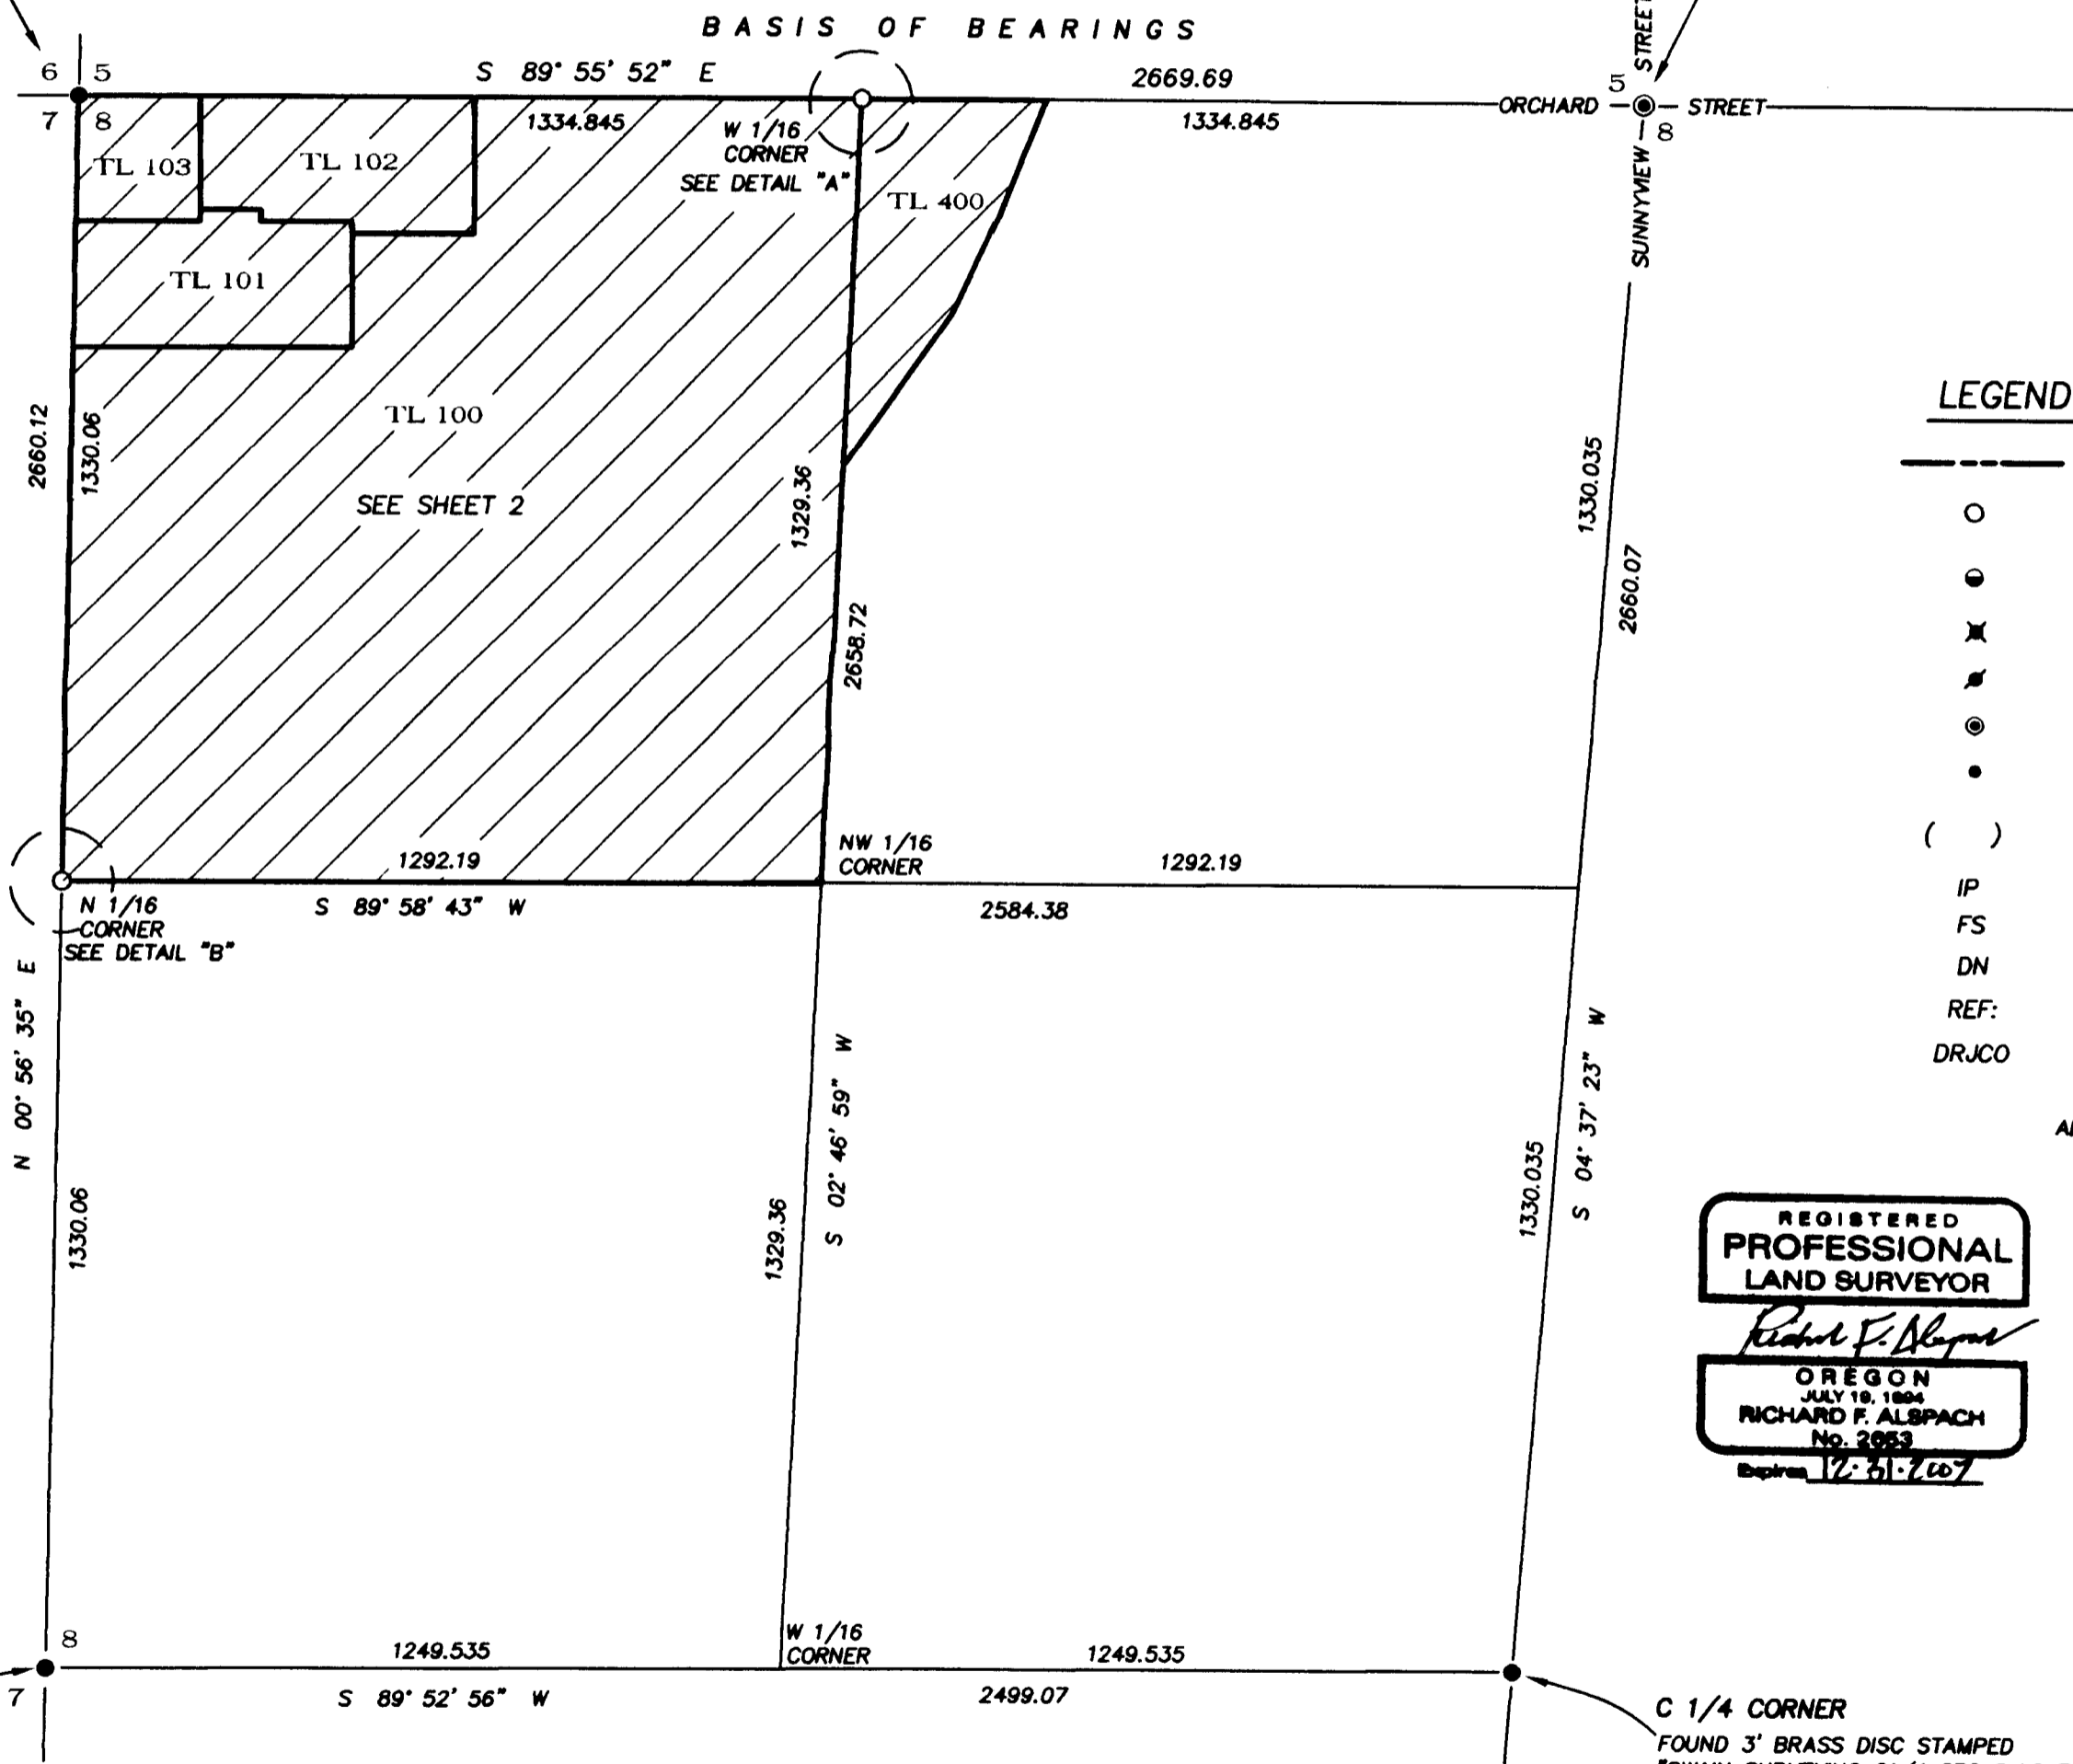

LEGEND

- SURVEYED PROPERTY LINE
- SET 5/8" X 30" IRON PIN W/CAP STAMPED "ALSPACH PLS 2653" UNLESS OTHERWISE NOTED
- FOUND 5/8" IP W/CAP STAMPED "KAMPMANN PLS 2883" PER FS 19545
- ✕ FOUND 5/8" IP W/CAP STAMPED "D McMAHON LS 1913" PER FS 12734
- ⊙ FOUND 1/2" IP PER FS 5118
- FOUND MONUMENT AS NOTED
- () RECORD DATA WHEN DIFFERENT FROM MEASURED
- IP IRON PIN
- FS FILED SURVEY
- DN DOCUMENT NUMBER, OFFICIAL RECORDS, JACKSON COUNTY, OREGON
- REF: REFERENCE
- DRJCO DEED RECORDS JACKSON COUNTY OREGON

ALL DISTANCES ARE IN FEET AND DECIMALS THEREOF

REGISTERED
PROFESSIONAL
LAND SURVEYOR

Richard F. Alspach
OREGON
RICHARD F. ALSPACH
No. 2653
Expires 12-31-2007

TERRASURVEY, INC.

PROFESSIONAL LAND SURVEYORS

274 FOURTH STREET
ASHLAND, OREGON 97520

(541) 482-6474
terrain@bisp.net



JOB NO. 576-06

BASIS OF BEARING
MONUMENTS FOUND AT POINT "A" AND POINT "B" AS S 89° 55' 52" E, AS SHOWN ON THE SURVEY FILED AS NUMBER 18672 IN THE OFFICE OF THE JACKSON COUNTY SURVEYOR

I CERTIFY THAT THIS SURVEY WAS PREPARED WITH ARCHIVAL QUALITY MATERIALS AS REQUIRED BY ORS 209.250. SPECIFIC PRODUCTS USED ARE HEWLETT PACKARD INK #51640A ON CONTINENTAL MYLAR #JPC-4M2.

Richard F. Alspach
RICHARD F. ALSPACH, PLS 2653

RECEIVED
DATE 5-2-07 BY *[Signature]*
This survey consists of:
2 sheet(s) Map
3 page(s) Narrative
JACKSON COUNTY SURVEYOR

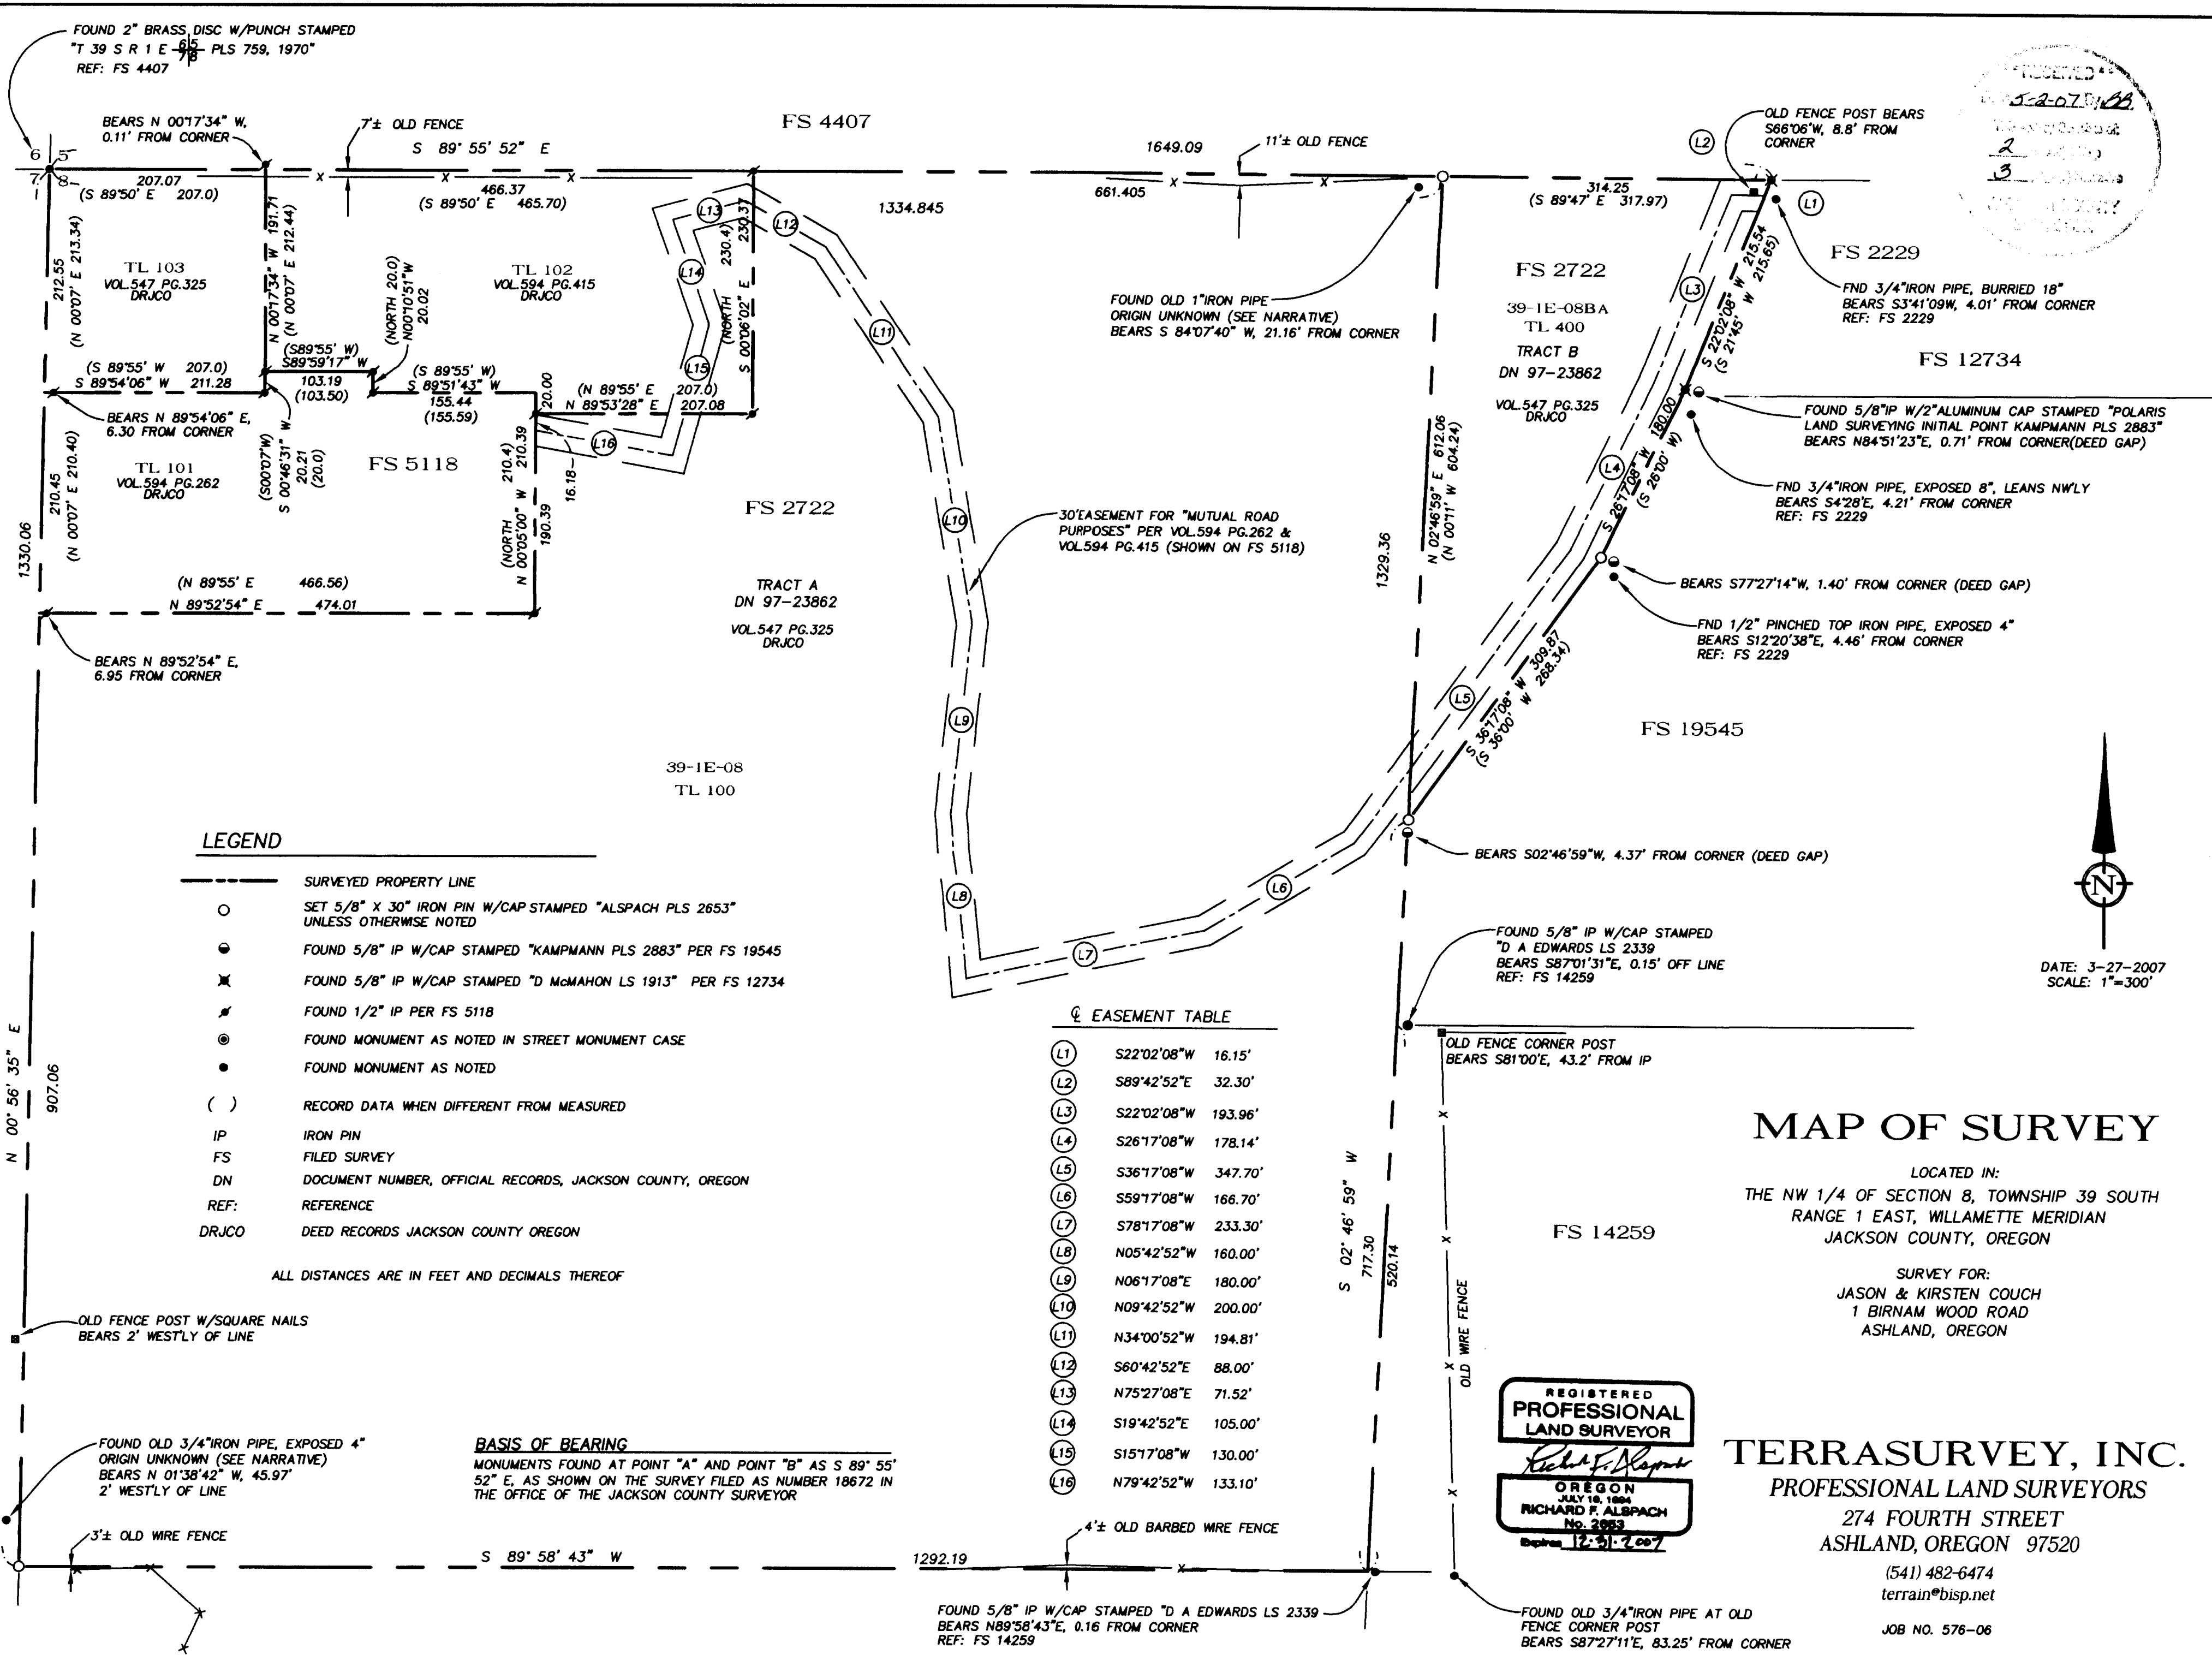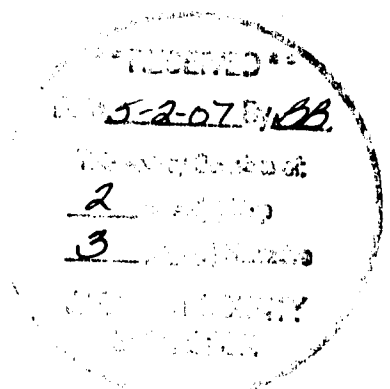


- LEGEND**
- SURVEYED PROPERTY LINE
 - SET 5/8" X 30" IRON PIN W/CAP STAMPED "ALSPACH PLS 2653" UNLESS OTHERWISE NOTED
 - FOUND 5/8" IP W/CAP STAMPED "KAMPMANN PLS 2883" PER FS 19545
 - ✕ FOUND 5/8" IP W/CAP STAMPED "D McMAHON LS 1913" PER FS 12734
 - ✎ FOUND 1/2" IP PER FS 5118
 - ◎ FOUND MONUMENT AS NOTED IN STREET MONUMENT CASE
 - FOUND MONUMENT AS NOTED
 - () RECORD DATA WHEN DIFFERENT FROM MEASURED
 - IP IRON PIN
 - FS FILED SURVEY
 - DN DOCUMENT NUMBER, OFFICIAL RECORDS, JACKSON COUNTY, OREGON
 - REF: REFERENCE
 - DRJCO DEED RECORDS JACKSON COUNTY OREGON
- ALL DISTANCES ARE IN FEET AND DECIMALS THEREOF

EASEMENT TABLE

(L1)	S22°02'08"W	16.15'
(L2)	S89°42'52"E	32.30'
(L3)	S22°02'08"W	193.96'
(L4)	S26°17'08"W	178.14'
(L5)	S36°17'08"W	347.70'
(L6)	S59°17'08"W	166.70'
(L7)	S78°17'08"W	233.30'
(L8)	N05°42'52"W	160.00'
(L9)	N06°17'08"E	180.00'
(L10)	N09°42'52"W	200.00'
(L11)	N34°00'52"W	194.81'
(L12)	S60°42'52"E	88.00'
(L13)	N75°27'08"E	71.52'
(L14)	S19°42'52"E	105.00'
(L15)	S15°17'08"W	130.00'
(L16)	N79°42'52"W	133.10'

BASIS OF BEARING
 MONUMENTS FOUND AT POINT "A" AND POINT "B" AS S 89° 55' 52" E, AS SHOWN ON THE SURVEY FILED AS NUMBER 18672 IN THE OFFICE OF THE JACKSON COUNTY SURVEYOR

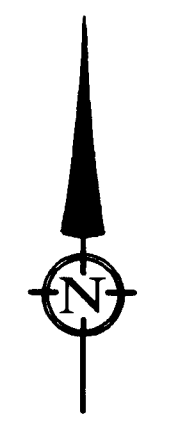


DATE: 3-27-2007
 SCALE: 1"=300'

MAP OF SURVEY

LOCATED IN:
 THE NW 1/4 OF SECTION 8, TOWNSHIP 39 SOUTH
 RANGE 1 EAST, WILLAMETTE MERIDIAN
 JACKSON COUNTY, OREGON

SURVEY FOR:
 JASON & KIRSTEN COUCH
 1 BIRNAM WOOD ROAD
 ASHLAND, OREGON

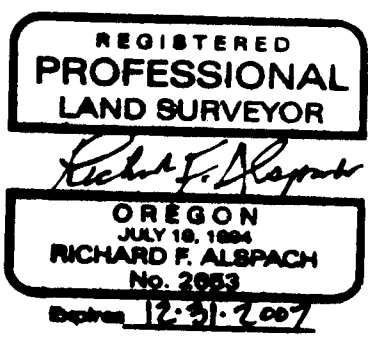

TERRASURVEY, INC.

PROFESSIONAL LAND SURVEYORS

274 FOURTH STREET
 ASHLAND, OREGON 97520

(541) 482-6474
 terrain@bisp.net

JOB NO. 576-06