


SURVEY IN SEC. 8, T 37S, R 1E, WM.,

FOR
CAL - ORE RANCHES

BY EDWARD McGINTY
MEDFORD OREGON
MAY 1962


- SCALE 1" = 300'
- = 5/8" I.P.I.N
 - = 2" G.I.P.
 - ◻ = FD. COR.
 - = B.C.

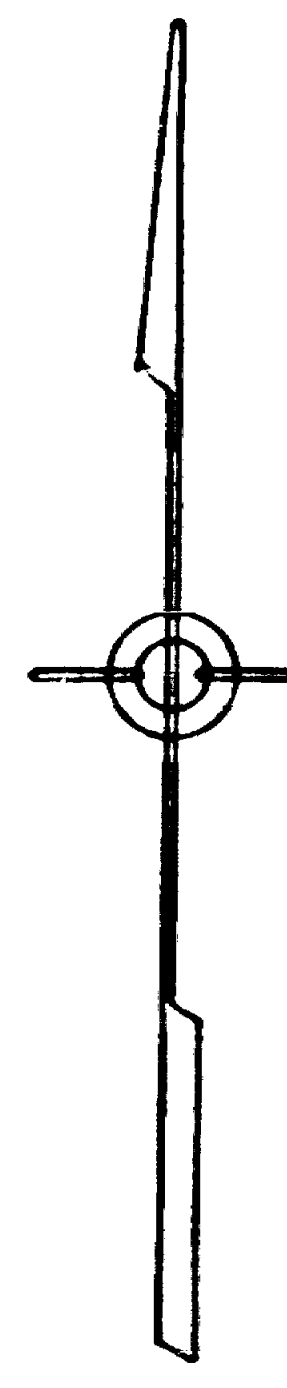

REGISTERED
OREGON
LAND SURVEYOR
Edward A. McGinty
JULY 10, 1953
EDWARD A. MCGINTY
301

Survey Narrative to comply with O.R.S. 209-250.

Survey for: Cal-Ore Ranches
Survey by: Edward S. McGinty, L.S. 6/6/62

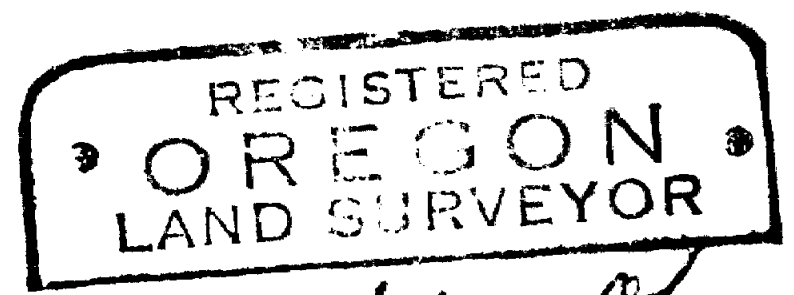

Edward S. McGinty
JULY 10 1962
EDWARD S. MCGINTY
331

BASIS OF BEARING: Solar Observation.

PRECEDENCE OF SURVEY:

Survey in Sec. 8, T37S, R1E., at the 1/4 corner between Sec's 8 and 17 set a 5/8 inch iron pin in a mound of stone, from which
Orig. bearing tree, now an 18 in. black oak, bears N.40°W., 57.2 links, 1/4 visible.

Orig. bearing tree, now a 12 in. black oak, bears S.66°W., 63.2 links.

At corner between secs. 8, 9, 16 and 17 found a rock mound and a wood post, replaced wood post with a 5/8 in. iron pin. Found the original bearing tree, now a down snag, N.77°W., also stump holes of orig. bearing tree, S.63°E and N.67°E., from which

- A fir tree, 6 ins. diam., bears S.11°W., 3.0 ft., mkd. with 2 blazes
- A pine tree, 6 ins. diam., bears S.38 1/2°E., 10.2 ft., mkd. with 2 blazes
- A fir tree, 8 ins. diam., bears N.29 1/4°W., 11.0 ft., mkd. with 2 blazes
- A fir tree, 6 ins. diam., bears N.44 1/2°E., 21.8 ft., mkd. with 2 blazes

At the East one quarter corner of Sec. 8 set a 5/8 inch iron pin, from which

- A manzanita, bears N.49°E., 21.1 ft., mkd. with 2 blazes, orig. BT.
- A laurel tree, 10 ins. diam., bears S.38°W., 24.7 ft., 2 blazes in a stool of laurels where the orig. BT was
- A white oak, 18 ins. diam., bears N.89°E., 40.6 ft., 2 blazes

At the Northeast corner of Sec. 8 found a 2 in. Gal. iron pipe (See Co. Surveyors Re-estab. note

At the North quarter corner of Sec. 8 set a 5/8 inch iron pin, from which

- A white oak, 20 ins. diam., bears S.51°E., 54.1 ft., orig. BT.
- A white oak, 26 ins. diam., bears N.2°W., 70.6 ft., orig. BT.
- An iron axles, 1 1/2 ins. diam., bears S.66°E., 1.11 ft.

At the Northeast corner of Sec. 8, found a rock mound, also a stump hole NW. and a down snag SE. being evidence of the orig. bearing trees.

Drilled a hole and set a 1 1/2 in. brass cap in bedrock outcrop from which

- Found a white oak, 15 ins. diam., bears S.88°W., 76.1 ft., scribed S-7, approx. 50 years ago.
- A white oak, 5 ins. diam., bears N.22 3/4°W., 75.2 ft., 2 blazes
- A white oak, 6 ins. diam., bears N.18 1/4°E., 21.2 ft., 2 blazes
- A white oak, 6 ins. diam., bears S.21 1/4°E., 84.5 ft., 2 blazes

At the west one quarter corner of Section 8 found a rock mound, set a 5/8 inch iron pin; from which

- A black oak snag, 26 ins. diam., bears S.85°W., 66.0 ft., 2 old blazes scribed and deteriorated, being the orig. BT.
- A pine tree, 6 ins. diam., bears N.44°W., 65.6 ft., 2 blazes
- A white oak, 18 ins. diam., bears S.82°E., 34.9 ft., 2 blazes

