

**SURVEY FOR:**  
LARRY BLODGETT  
1548 U.S. HWY. 52  
NEW RICHMOND, OHIO 45157

**DATE OF SURVEY:**  
MAY 8, 2007

# MAP OF SURVEY

Located in the N.E. 1/4 of Sec. 25, T.38S., R.2E., W.M.  
Jackson County, Oregon

**SURVEY BY:**  
L.J. FRIAR & ASSOCIATES, P.C.  
CONSULTING LAND SURVEYORS  
816 WEST EIGHTH STREET  
MEDFORD, OREGON 97501  
PHONE: (541) 772-2782  
EMAIL: ljfriar@charter.net

**LEGEND:**  
⊙ = FD. 2.5" DIA. B.L.M. BRASS CAP AND ACCESSORIES PER B.L.M. 1965 SURVEY.  
○ = SET 5/8" X 30" IRON PIN W/ PLASTIC CAP MKD. L.J. FRIAR & ASSOC.  
◦ = CALCULATED POSITION OF THE N-S 1/64 CORNER, NOTHING SET.

ORJCO = OFFICIAL RECORDS OF JACKSON COUNTY, OREGON.  
JCDR = JACKSON COUNTY DEED RECORDS.  
( ) = RECORD DATA AS SHOWN.  
DR = DEED RECORD DATA.


**SURVEY NARRATIVE TO COMPLY WITH O.R.S. 200.250**

**PURPOSE:** TO SURVEY AND MONUMENT THE SOUTHEAST CORNER OF THE SUBJECT PROPERTY DESCRIBED IN DOCUMENT NO. 2006-055429, ORJCO.

**PROCEDURE:** MADE TIES TO MONUMENTS OF RECORD, AS SHOWN HEREON, TO CONTROL THE EAST LINE OF THE NORTHEAST QUARTER OF SECTION 25. CALCULATED THE POSITION OF THE N-S 1/64 CORNER AT THE MID-POINT OF THE 1/4 CORNER AND THE NORTH 1/16 CORNER. SET THE SOUTHEAST CORNER OF SUBJECT PROPERTY ON THE SECTION LINE 220 FEET NORTH OF THE 1/64 CORNER PER DEED RECORD.

**BASIS OF BEARINGS:**

EAST LINE OF THE N.E. 1/4 OF SECTION 25 PER 1965 BLM SURVEY BY J. GAWRON ET. AL.  
UNIT OF MEASUREMENT = FEET SCALE: 1" = 50'

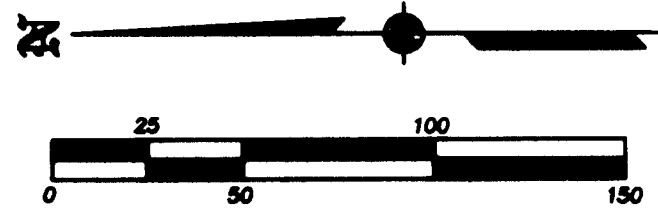

N 1/16 COR.

BASIS OF BEARINGS  
N00°30'00"W

449.91

(20.27 CH.)  
1339.82

220.00 = DR

N-S 1/64 COR.

SEC 30, T.38S. R.3E., W.M.

SEC 25, T.38S. R.2E., W.M.

DOC. #2006-055429, JCDR

REGISTERED  
PROFESSIONAL  
LAND SURVEYOR

*James E. Hibbs*  
OREGON  
JULY 17, 1988  
JAMES E. HIBBS  
2234

RENEWAL DATE 6-30-09

• • RECEIVED • •  
DATE 5-17-07 BY *[Signature]*  
This survey consists of:  
1 sheet(s) Map  
0 page(s) Narrative  
JACKSON COUNTY  
SURVEYOR