
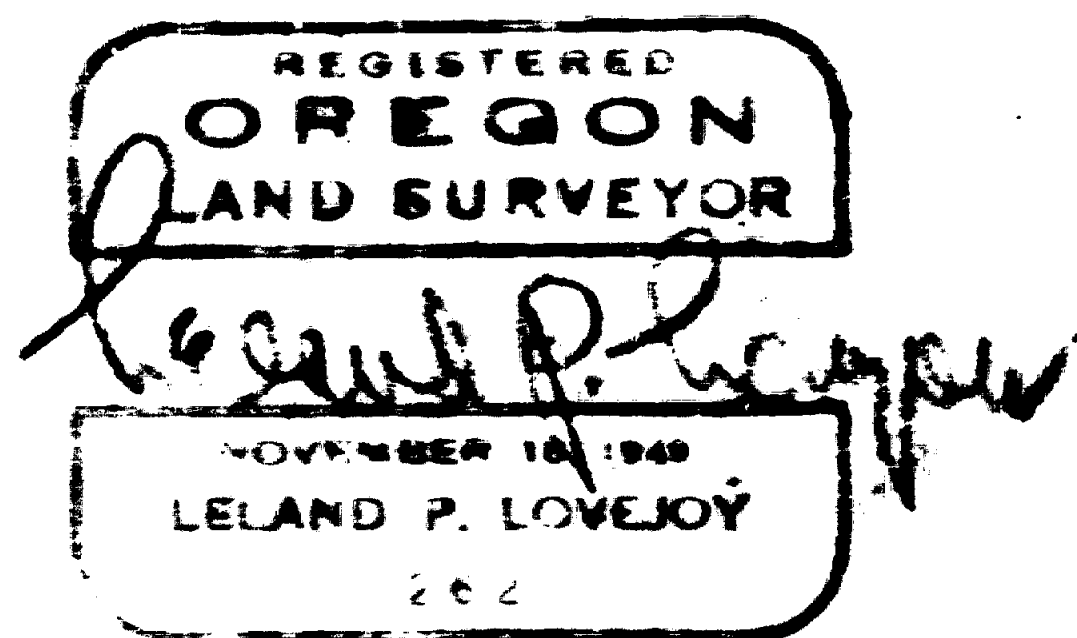


BEARINGS BY PREVIOUS SURVEY  
 ○ = SET 5/8" STEEL PIN  
 ● = FD. 5/8" STEEL PIN

BOUNDARY SURVEY OF PROPERTY  
 SITUATE IN  
 S.E. 1/4 SEC. 36, T. 36 S., R. 2 W. W.M.  
 JACKSON COUNTY, OREGON  
 FOR  
 PEARL BARAGER  
 L.P. LOVEJOY L.S. MEDFORD, ORE.  
 SCALE: 1" = 200'  
 JUNE 19, 1962

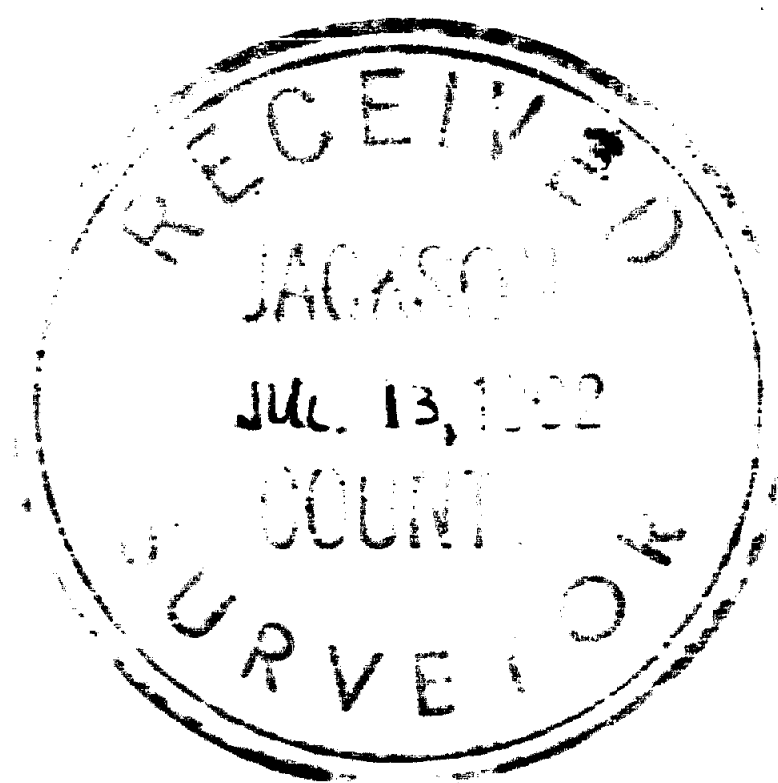

19. 1968

Survey Narrative to Comply with Section 87-330  
1947 Oregon State Laws

Survey for: Mrs. Pearl Barager  
Shell Lake, Wisconsin

Purpose of Survey: To establish property  
boundaries.

Survey Location: Southeast Quarter (1/4) of  
Section 36, Township 36  
South, Range 2 West,  
Willamette Meridian, Jackson  
County, Oregon.

Survey Procedure: Found section and quarter  
corners, as shown on map,  
and other survey points,  
and used as basis for survey  
control. Set 5/8" steel pins.

Leland P. Lovejoy  
Registered Land Surveyor

Work completed June 19, 1962

