


19682

VOL.442, PG.158, 500

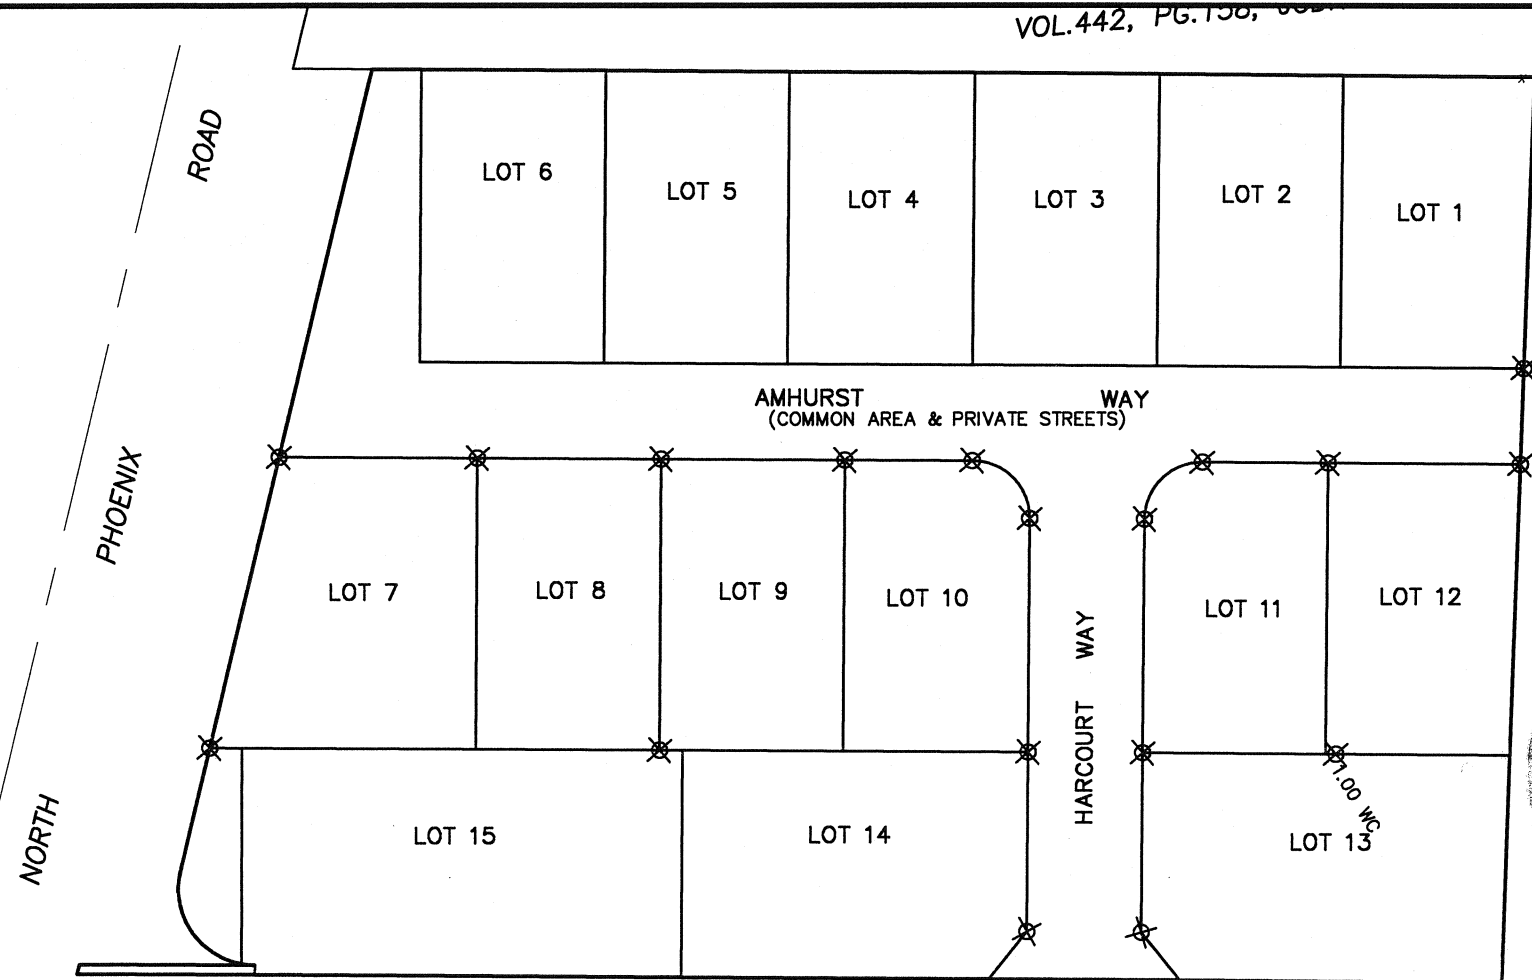

PARCEL 1 PER PP# P-40-2005


**** RECEIVED ****
 Date: 6-25-07
 Title: City Clerk
 0
 2
 JACOBSON COUNTY SURVEYOR

121

HARBROOKE ROAD (VOL.473, PG.114, JCDR)

LEGEND:

- ⊗ = SET BRASS TAG MKD. L.J. FRIAR & ASSOC. IN LEAD PLUG IN CONCRETE.
- WC = WITNESS CORNER MONUMENT.

<p>REGISTERED PROFESSIONAL LAND SURVEYOR</p> <p><i>James E. Hibbs</i></p> <p>OREGON JULY 17, 1986 JAMES E. HIBBS 2234</p> <p>RENEWAL DATE 6-30-09</p>	<p>TITLE: AFFIDAVIT OF POST MONUMENTATION EXHIBIT</p>	<p>DATE: 21 MAY 2007</p>
	<p>SUBDIVISION NAME: HARBROOKE COURT</p>	<p>SCALE: 1 inch : 50 feet</p>
	<p>FOR: KOKANEE INVESTMENTS, LLC P.O. BOX 8271 MEDFORD, OR 97504</p>	<p>DRAWN BY: JEH CHK BY:</p>
<p> L.J. FRIAR & ASSOCIATES P.C. CONSULTING LAND SURVEYORS 816 W. 8TH ST., MEDFORD, OR. (541) 772-2782 ljfriar@charter.net</p>	<p>ORIGIN:</p> <p>ROTATION: 0° JOB#: 05171FM</p>	<p>Sheet 1 of 1.</p>