

N.W. COR. D.L.C. NO. 42,
T. 37 S., R. 2 W., W.M.
FD. STONE WITH 'X'

50°00'50"W
333.59'

S 86°45'20"E
143.34'

PRIVATE ROAD
EAST 523.94'

502.80'
EAST 534.38'

S 34°56'00"E
M.C.O.R.
N 51°41'00"E

WIL & DIR 429-465
M.I.D.
WEST
S 53°31'30"E
120.00'

BOUNDARY SURVEY OF PROPERTY
SITUATE IN
D.L.C. No. 42, T. 37 S., R. 2 W., W.M.
JACKSON COUNTY OREGON
FOR
K.W. SWARTZ



L.P. LOVEJOY L.S. MEDFORD, ORE.
SCALE 1"=60' 6-1-62

BEARINGS BY PREVIOUS SURVEY
□ = FD 3/4" IRON BOLT
○ = SET 5/8" STEEL PIN

W/L D.L.C. 42 N 0°00'50"E 326.41'
296.41'

WEST 806.20'
N/L & PROJECTION THEREOF OF DIR 459-29 AND DIR 285-339

S.W. COR. D.L.C. NO. 42
T. 37 S., R. 2 W., W.M.
FB. 1 1/2" G.I.P.

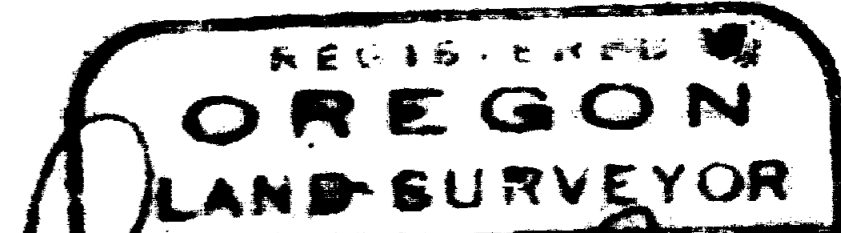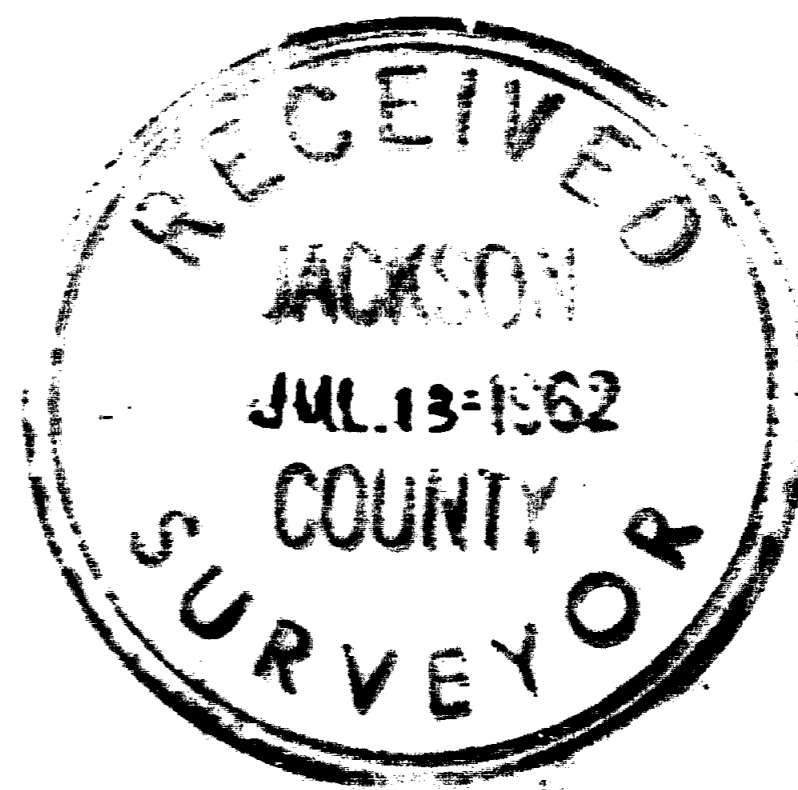

Leland P. Lovejoy
NOVEMBER 18 1962
LELAND P. LOVEJOY
262



Survey Narrative to Comply with Section 87-330
1947 Oregon State Laws

Survey for: K. W. Swartz
c/o Ed Perkins
Real Estate Broker
1236 1/2 N. Riverside Ave.
Medford, Oregon

Purpose of Survey: To establish boundaries of
property sold.

Survey Location: D. L. C. 42, Township 37 South,
Range 2 West, Willamette
Meridian, Jackson County, Oregon.

Survey Procedure: Found D. L. C. corners and other
survey points and used as basis
for survey control. Set 5/8" pins
as shown on map.

Leland P. Lovejoy
Registered Land Surveyor

Work completed June 15, 1962

