

Calc. C.S. 1/16 Cor.
(Re: FS 17347)

PI 173+29.73
Fd. 2.5"
Alum cap

MEASUREMENT DATA
L1 = N89°57'50"W 42.50' S89°48'30"E 965.44' (R1 = S89°45'44"E)

**MAP of SURVEY
PROPERTY LINE ADJUSTMENT
CITY OF MEDFORD**

LOCATED IN:
SE 1/4 Section 36, T36S, R2W W.M.
Jackson County, Oregon
May 15, 2007

Narrative

Purpose: To survey and map the property line adjustment as approved by City of Medford Planning file # 2007-196 PLA

Procedure: Used S/N 17347 as a basis for control. Monumented the new property line as directed by our client and prepared legal descriptions accordingly to complete the property line adjustment process.

Basis of Bearing: FS 17347

S. bndry V.85 P.380 D.R. } Determine by previous
N. bndry V.285 P.414 D.R. } monuments as shown

Adjusted T.L. 1300 (±35.93)
Adjusted by CONSOLIDATION
(Re: Doc No. 2007-036848 O.R.)

W. bndry. V. 351, P. 492, D.R.
(450.00' E of N-S C/L Sec. 36)

APPROVED
City Of Medford
Planning Department


[Signature]

**** RECEIVED ****
DATE 10-8-07 BY SB
This survey consists of:
1 sheet(s) Map
2 page(s) Narrative
JACKSON COUNTY
SURVEYOR

Survey For:
Jackson County Airport Authority
3650 Biddle Road #13
Medford, OR 97504
(541) 776-7222
attn: Marcy Black

Survey By:
Hardey Engineering & Assoc., Inc.
By: Richard L. Bath, L.S. 1069
P.O. Box 1625
Medford, OR 97501-0124

- Legend**
- = SET 5/8" X 24" IRON REBAR WITH ORANGE PLASTIC CAP STAMPED "HARDEY ENG. & ASSOC."
 - = Fd. 5/8" REBAR & YELLOW PLASTIC CAP STAMPED "JACKSON CO. ROADS & PKS." PER FS 19245
 - = Fd. 5/8" REBAR & ORANGE PLASTIC CAP PER FS 17347
 - ⊙ = Fd. BRASS PLUG STAMPED "JACO" PER FS 19245
 - d.r. = DEED RECORD MEASUREMENT
 - FS = FILED SURVEY NO.
 - R1 = FS 3107
 - D.R. = DEED RECORDS, JACKSON COUNTY OREGON
 - O.R. = OFFICIAL RECORDS, JACKSON COUNTY OREGON

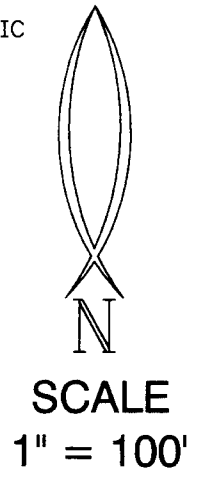

**REGISTERED
PROFESSIONAL
LAND SURVEYOR**

Richard L. Bath

OREGON
JULY 30, 1976
RICHARD L. BATH
No. 1069
RENEWS 12/31/07

Hardey Engineering & Associates, Inc.

HEA
ENGINEERING INTEGRITY

P.O. BOX 1625
MEDFORD, OREGON 97501-0063
VOICE: 541-772-6880
FAX: 541-772-9573
EMAIL: info@hea-inc.com

423-19-06\dwg\MOS_uCOAP.dwg

36-2W-36D, Tax Lots 400 & 1300