

1984

MAP OF SURVEY FOR

N.E. COR. D.L.C. # 51
T. 38 S. R. 1 W. W.M.

3/4" I.P.
REESTAB.2 BTs


R. B. FOWLER, RT. 4, BOX 427C, MEDFORD, ORE.
LOCATED IN SEC. 18 § D.L.C. #51, T. 38 S. R. 1 W. W.M.
JACKSON COUNTY, ORE.

DATE: 8-1-62

SCALE: 1" = 200'

SOLAR BEARINGS

SURVEYED BY L.E. AGER, REG. PROF. SURVEYOR '21
63 GRESHAM ST. ASHLAND, ORE.

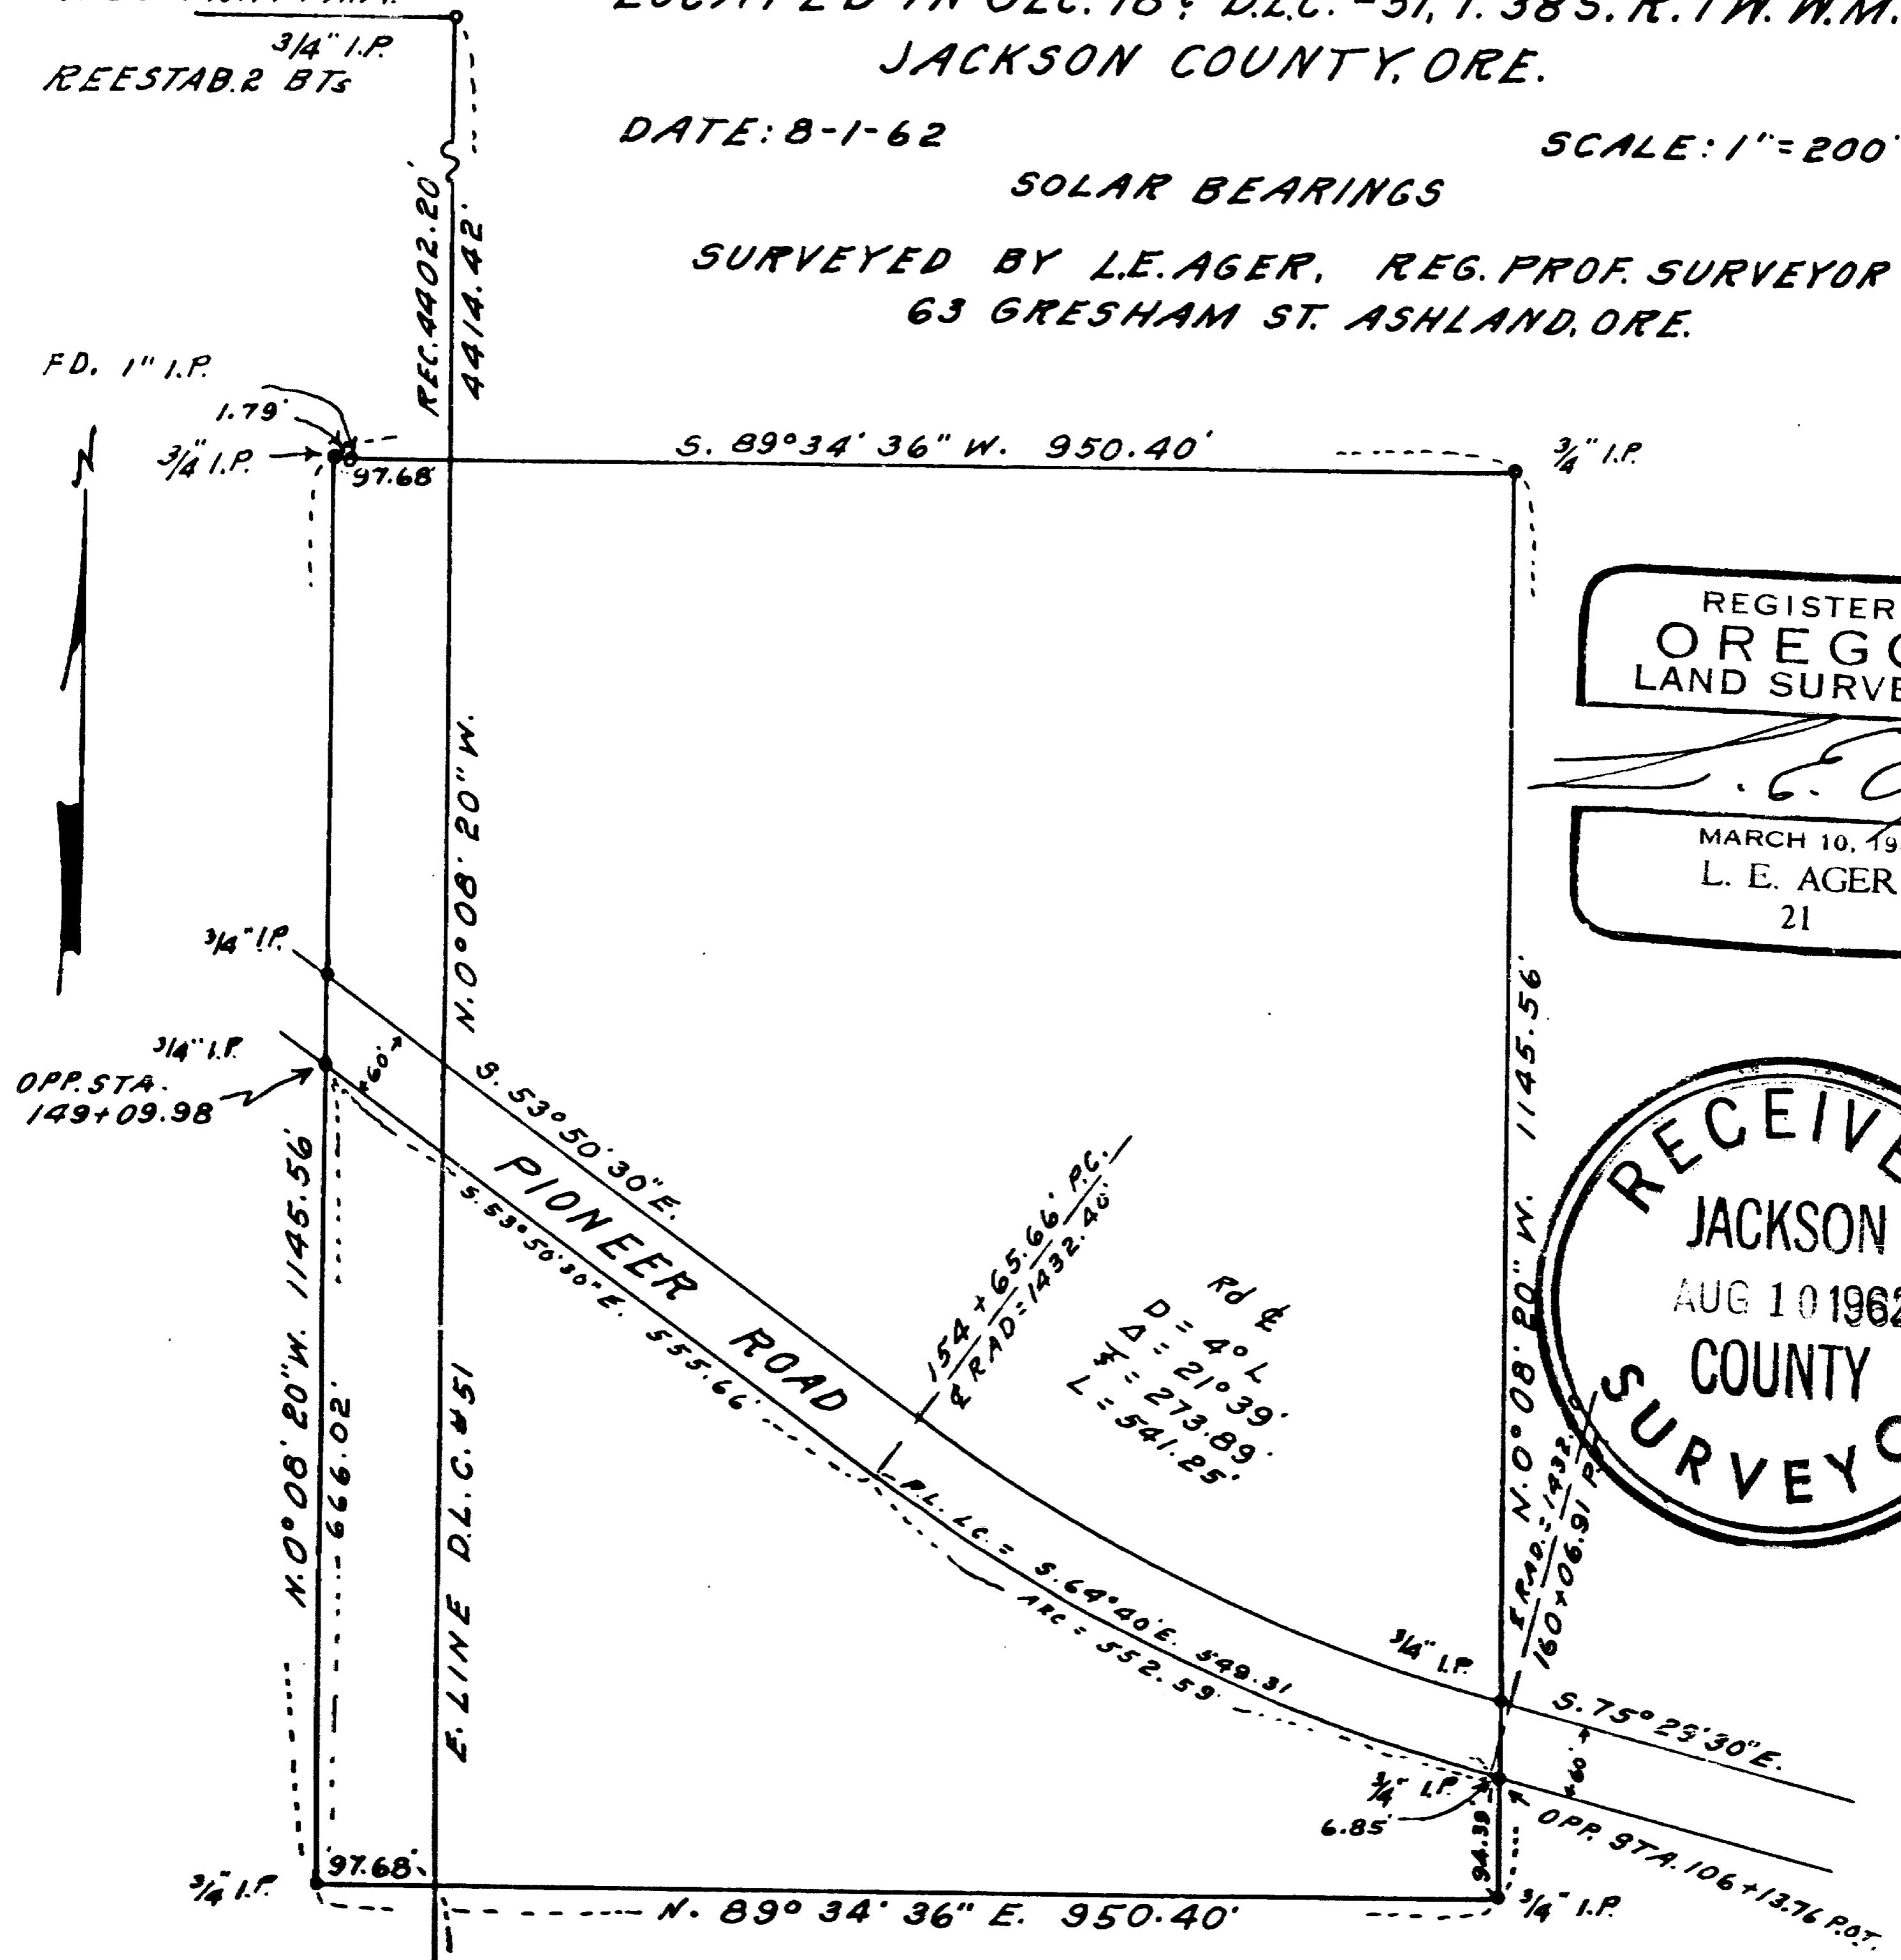

1984

S.W. COR. SEC. 18
T. 38S. R. 1W. W.M.

1" CAPPED PIPE 8.
2744.88 5 1/4 COR.
1" IRON ROD
REF STAB

**S.E.COR.DLC. #51
1" IRON ROD
REESTAB.**

1802.57
N. 89° 34' 36" E.
SEC. COR. TO SEC. COR.: 5384.18
RECORD: 5385.60

12" X 12" ?
STONE WITH + |
SE. COR. SEC. |
18, T. 38 S. R. 1 W.

For: R. B. Fowler, Rt. 4, Box 427 C, Medford, Oregon.
 Purpose: To establish corners of tract shown on map.
 Procedure: Traversed South line of Section 18 to determine position of S.E. corner of D.L.C. # 51 and S. $\frac{1}{4}$ corner of Sec. as no evidence of these corner locations as originally set. Found 12" + 12" + ? stone with + on top for S.E. cor. and a 1" capped pipe for the S.W. corner of the Section. Found the distance as measured between corners to be 1.42 feet short of the record distance so I prorated the measured distance and set a 1" iron rod on true line on the South line of the Section for the S.E. cor. of D.L.C. # 51 and also a 1" iron rod on same line for the $\frac{1}{4}$ cor. I set reference points for the S.E. corner of D.L.C. # 51 as follows:
 Set a 3/4" iron pipe on S. fence line which bears S. $0^{\circ} 59'$ E. 24.30 feet from cor.; a spike in S. face of a 20" yellow pine, 4' up from ground bears N. $0^{\circ} 59'$ W. 76.14 feet.
 References for S. $\frac{1}{4}$ corner of Sec.; a 3/4" iron pipe bears S. $0^{\circ} 22'$ E. 21.54 feet (this pipe on E.W. fence line); A bent spike in N. face of a 14" B.O. bears S. $72^{\circ} 15'$ E. 82.13 feet; the most southerly and westerly 12" pear tree in orchard bears N. $20^{\circ} 38'$ W. 56.2 feet to center of tree. From the relocated S.E. corner of D.L.C. # 51, I traversed to the N.E. corner of said Claim; The iron pipe set by Co. Surveyor on reestab. has been plowed out, I set a 3/4" iron pipe in place from the reestab. B.T.s.; Rec. dist. between corners 4402.20 feet, measured distance 4414.42 feet, over plus of 12.22 feet. From these reestab. corners I surveyed the tract as shown according to the bearings and distances set forth on map, tieing survey to relocated Pioneer Road center-line.

