

NARRATIVE

PURPOSE: To survey and mark the corners of the newly adjusted property line per Jackson County Planning file number SUB2007-00033.

PROCEDURE: From previous control set on filed survey number 19575, I set monuments on the adjusted property line as shown. Legal descriptions were prepared and deeds were recorded with their recording numbers shown hereon.



LEGEND

- SET 5/8" X 30" REBAR WITH PLASTIC CAP MARKED "TEMPLIN LS2359"
- 5/8" X 30" REBAR WITH PLASTIC CAP MARKED "TEMPLIN LS2359" PER FILED SURVEY #19575
- ⊕ FD. STANDARD BLM PIPE AND BRASS CAP MONUMENT
- ⊙ FD. BRASS CAP MONUMENT PER F.S. # 8681
- FD. BRASS CAP MONUMENT PER JACKSON COUNTY REESTABLISHMENT
- △ INDICATES CALCULATED POSITION
- () INDICATES RECORD DATA PER FS 8681
- FS INDICATES FILED SURVEY

BASIS OF BEARING: THE WEST LINE OF SW 1/4 OF SECTION 8 PER F.S. 8681

APPROVED BY JACKSON COUNTY PLANNING.

Robert M. Knott
 RIVY, Planner I
 DATE: November 30, 2007
 JACKSON COUNTY PLANNING FILE NUMBER SUB2007-00033 PLA

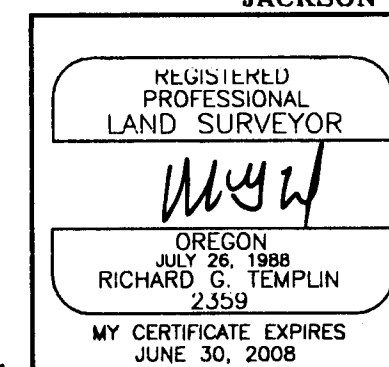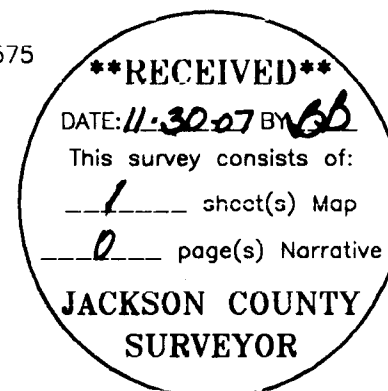

RICHARD TEMPLIN LAND SURVEYING
 P.O. BOX 1946 899-2032 JACKSONVILLE, OREGON

PROPERTY LINE ADJUSTMENT SURVEY
 LOCATED IN
 IN THE SE 1/4 OF THE SW 1/4 OF SECTION 8,
 T.40S., R.3W., W.M., JACKSON COUNTY, OREGON

For: Retta Knott
 P.O. Box 430
 Jacksonville, Or. 97530
 DATE: SEPT. 25, 2007