
Jackson County Assessors Map No: 36 2E, Tax Lots 4800 & 4900

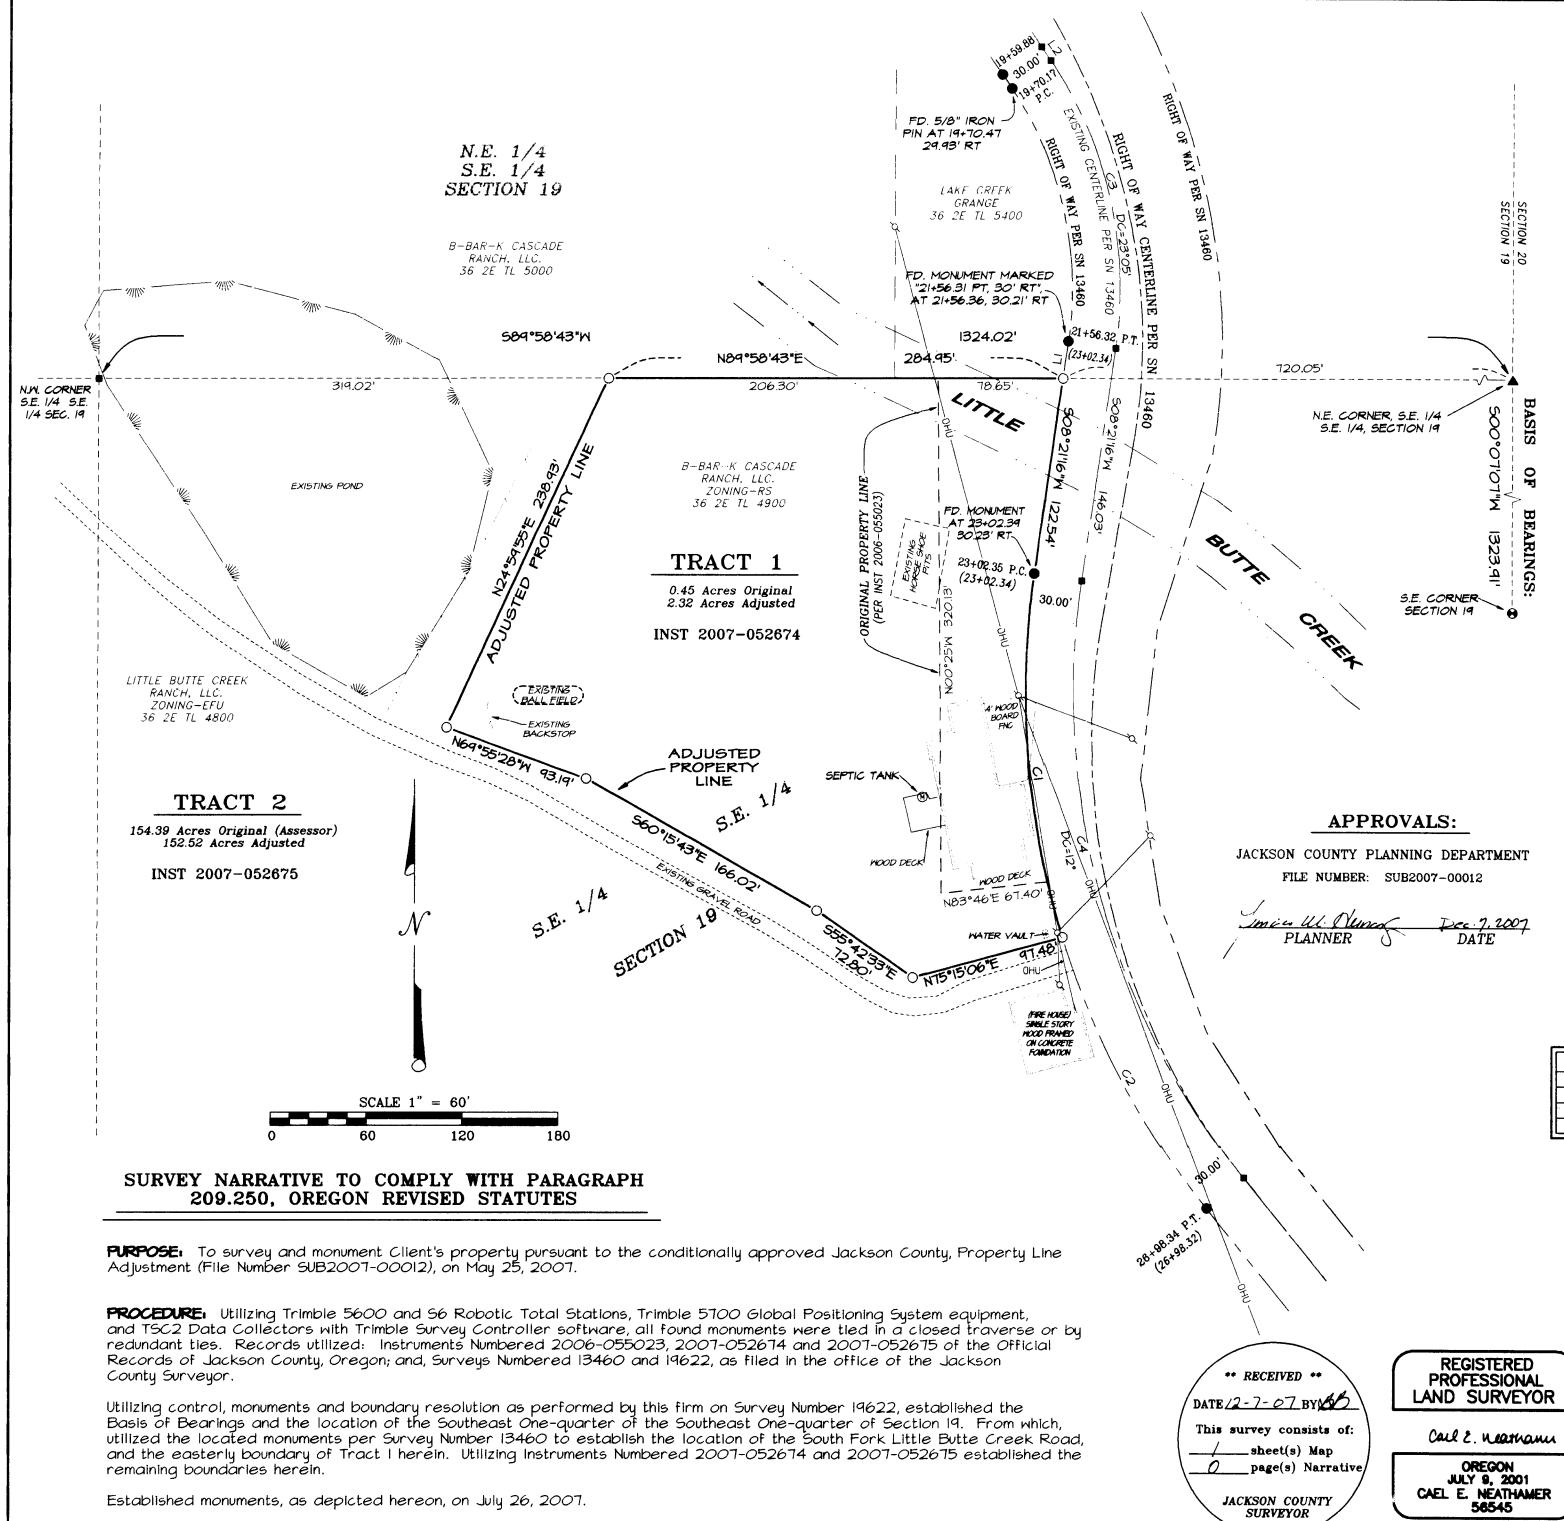

N:\NSI Projects\Cascade Ranch\O612O-A B-Bar-K\PLA-Map of Survey.pro

MAP OF SURVEY

A Property Line Adjustment located in the Southeast One-quarter of the Southeast One-quarter of Section 19, Township 36 South, Range 2 East of the Willamette Meridian, Jackson County, Oregon.

PREPARED FOR:

B-BAR-K CASCADE RANCH, LLC. P.O. BOX 558 EAGLE POINT, OR 97524

LEGEND:

- O Indicates a set 5/8-inch diameter by 24-inch long iron pin with an orange plastic cap marked "NEATHAMER SURVEYING"
- ▲ Indicates a found 5/8-inch diameter iron pin with plastic cap marked "NEATHAMER SURVEYING" per SN 19622.
- Indicates a found 5/8-inch diameter iron pin with plastic cap marked "AA SURVEYING, INC", per SN 13460.
- Indicates a found brass cap marking the Southeast Corner of Section 19.
- Indicates a computed position, nothing found or set.
 - Indicates an existing power pole.
- ----- Indicates overhead utilities.
 - SN Indicates a survey filed by number in the office of the Jackson County Surveyor.
 - SF Indicates the number of square feet within a closed area such as a tract of land.
- DC Indicates a Degree of Curve.
- -x— Indicates the centerline of an existing fence line.

LINE TABLE

| LINE | BEARING | DISTANCE | | | |
|------|-------------|----------|--|--|--|
| LI | 508°21'16"W | 23.49' | | | |
| L2 | 534°36′53″E | 10.29' | | | |

CURVE TABLE

| CURVE # | DELTA | RADIUS | ARC | CHORD BEARING | CHORD |
|---------|-----------|---------|---------|---------------|---------|
| Cl | 25°48'30" | 507.48' | 228.59' | 504°32'59"E | 226.66' |
| C2 | 21°42'32" | 507.481 | 192.281 | 528°18'30"E | 191.13' |
| C3 | 42°58'09" | 248.22' | 186.151 | 513°07'49"E | 181.82' |
| C4 | 47°31'02" | 477.48' | 395.99' | 515°24'15"E | 384.73' |

BASIS OF BEARINGS:

Geodetic North based on WGS 84 Datum, established by Global Positioning System observations by this firm on Survey Number 19622, as filed in the office of the Jackson County Surveyor. Basis applied to the East Line of the Southeast One-quarter of the Southeast One-quarter of Section 19, as depicted hereon.

PREPARED BY:

Renewal Date 12/31/08

Neathamer Surveying, Inc. 3132 State St., Suite 110 Medford, Oregon 97501 P.O. BOX 1584 Phone (541) 732-2869 FAX (541) 732-1382

PLOT DATE: December 4, 2007

PROJECT NUMBER: 06120-A

Sheet | of | ©