
38 1W 23D, TL 1900, TL 1901, TL 1902

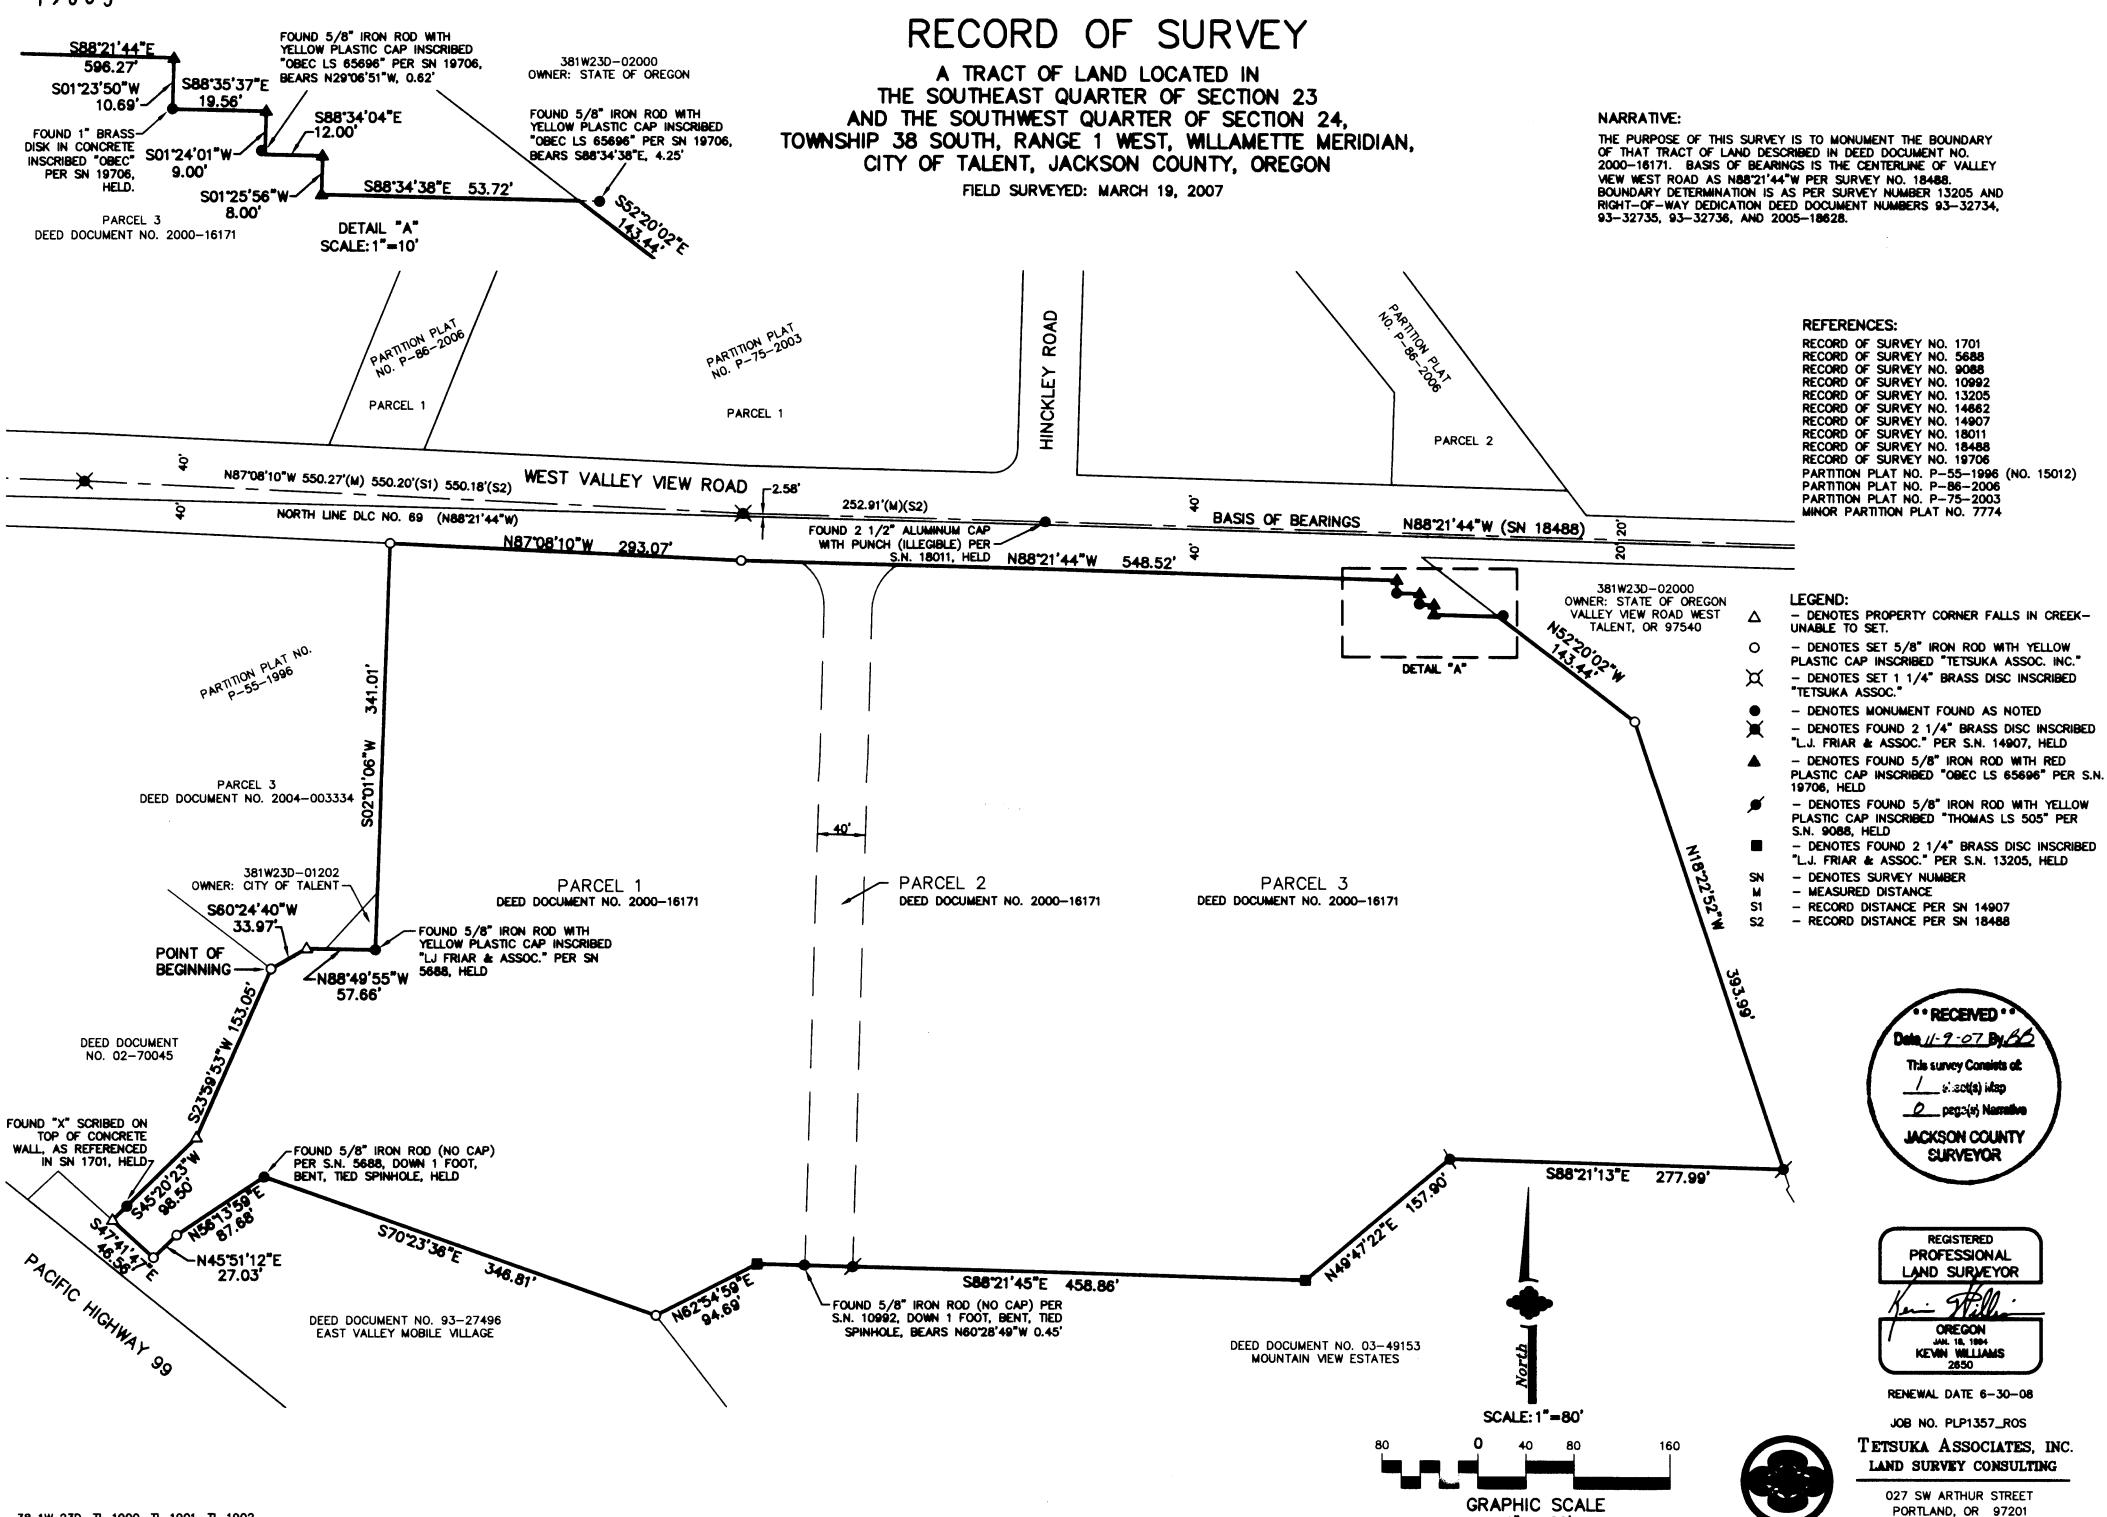

PH: 503.517.0682 FAX: 503.445.1300

1" = 80'