


SURVEY IN S.E. 1/4 OF N.W. 1/4 SEC. 1.T.37S.,R2W., W.M.

FOR
E. HOLMES
6-9

BY EDWARD Mc GINTY
MEDFORD OREGON
MAY 1962

SCALE 1"=100'
● = 1/2" I. PIN
○ = 5/8" I. PIN

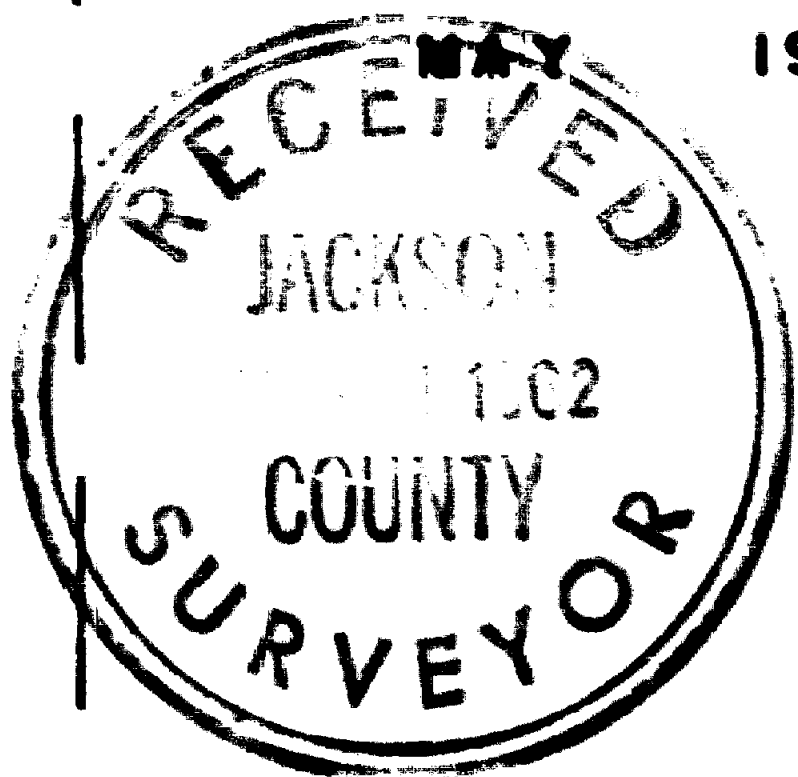

Edward A. McGinty
 JULY 10, 1953
 EDWARD A. MCGINTY
 301

Survey No. 2001

Survey Narrative to comply with O.R. S. 209-250.

Survey for: Eldon Holmes



Survey by: Edward A. McGinty, L.S. 7/11/62

BASIS OF BEARING: Previous survey of record

PRECEDENCE OF SURVEY:

Found a iron pins along northerly line. Found iron pin on West line on tract north of this survey, this line was projected southerly for the West line of this survey.

Iron pins were set at clients request.

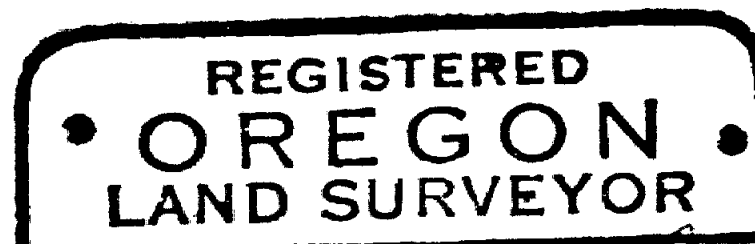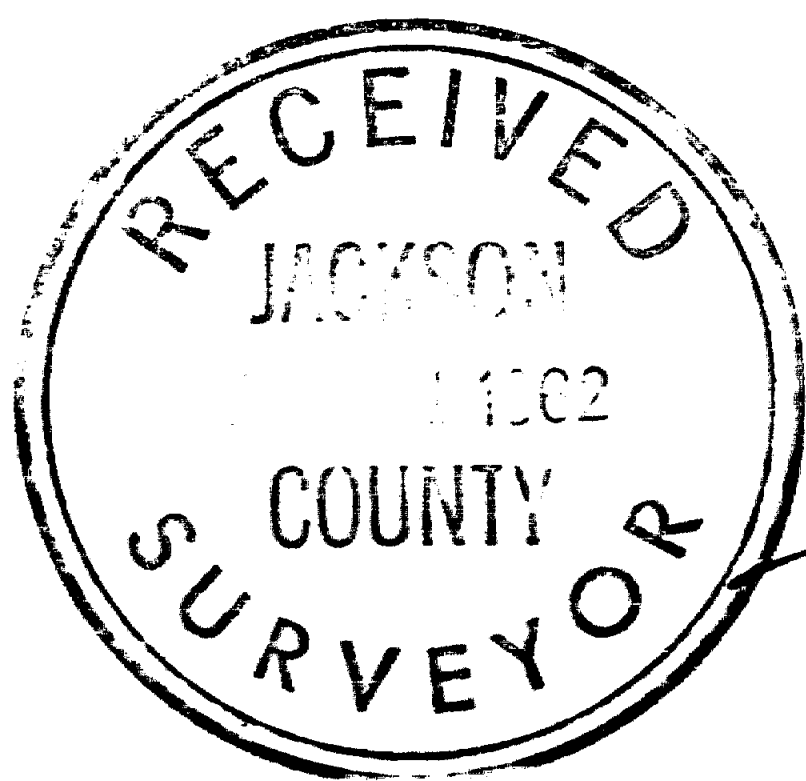

Edward A. McGinty
JULY 10, 1962
EDWARD A. MCGINTY
301