

MAP OF SURVEY

FOR

R.E. VANVLEET, 1450 SISKIYOU BLVD
ASHLAND, OREGON

LOCATED: SEC. 24, 25 & D.L.C. #55, T. 39 S. R. 1 E. W.M.

DATE: AUG. 1962

SCALE: 1"=200'

SURVEY BY

L.E. AGER, 63 GRESHAM ST.
ASHLAND, ORE.

SOLAR DATUM

REGISTERED
OREGON
LAND SURVEYOR



L.E. Ager

MARCH 10, 1944
L. E. AGER
21

Survey narrative to comply with ORS 209.250, Oregon State Law

For: R. E. Van Vleet, 1450 Siskiyou Boulevard Ashland, Ore.
Purpose: To survey and describe the boundaries of tracts shown on accompanying map.

Proceedure: Set iron pipes on the right-of-way lines of Highway 99 and Interstate 5 where each parcel of land intersects same between iron pins and pipes set by the Highway commision identifying the boundaries of said right-of-way, also 3/4" iron pipes set at angle points on the tract boundarys and at the point of intersection of the Irrigation District canal. No. pipes set at the angle points of the canal traverse. Tract surveys tied to N. 1/4 corner of Sec. 25 as well as all D. L. C. corners shown on the accompanying plat.

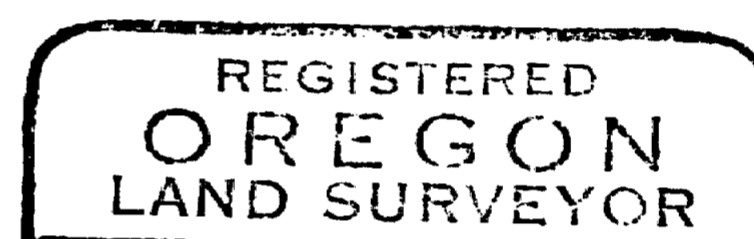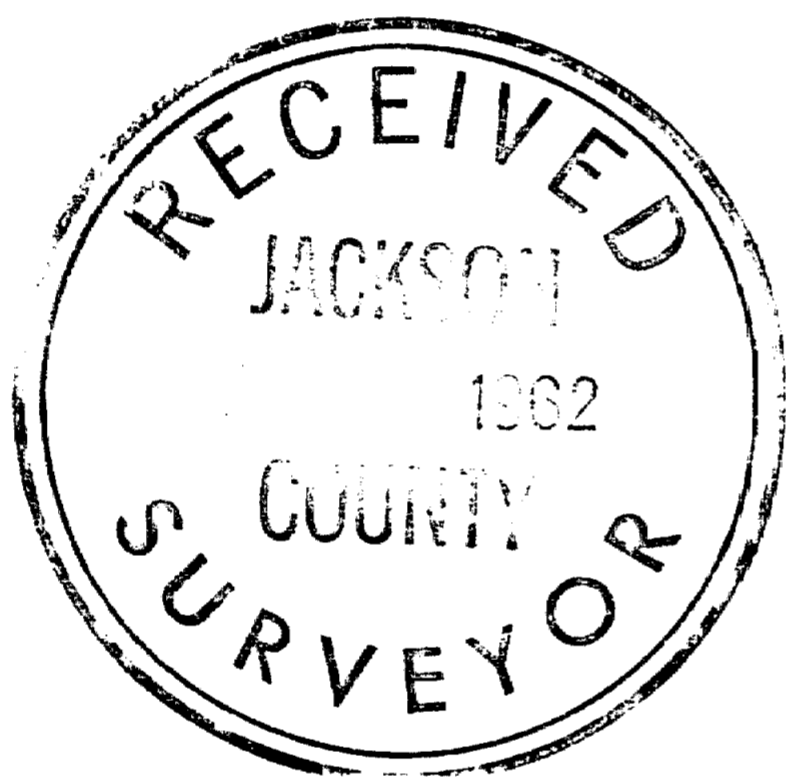

L. E. Ager

