



**AFFIDAVIT OF MONUMENTATION
FOR
DEFERRED MONUMENTS**

I, Christine Walker, County Clerk for Jackson County, Oregon, certify that the instrument identified herein was recorded in the Clerk records.
Christine Walker - County Clerk

20080

KNOW ALL MEN BY THESE PRESENTS, that I, David M. Minneci, a duly Registered Professional Land Surveyor in the State of Oregon, do hereby affirm that I have established with proper monuments as required by law those monuments shown as deferred on the Official Plat of **BELLA VISTA HEIGHTS, PHASES 1 & 2** as recorded in Volume 33 of Plats, Page 10 of Records in Jackson County, Oregon.

(See Exhibit "A" attached)

This Affidavit is to comply with Chapter 92.070 of the Revised Statues of the State of Oregon.

In Witness Hereof, signed this 8th day of APRIL, 2008.



David M. Minneci




Expires 12/31/08

STATE OF OREGON) ss.
County of Jackson)

On this 8 day of April, 2008, personally appeared the above named David M. Minneci, a Registered Professional Land Surveyor, and acknowledged the foregoing instrument to be his voluntary act and deed.

Before me:

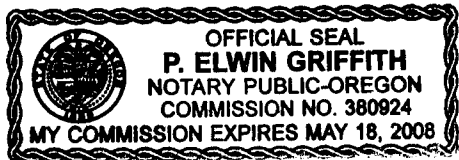

[Signature]

Notary
6/12/08
Date


Approved: _____
Medford City Surveyor

Examined and approved this 24th day of June, 2008.


[Signature]

Jackson County Surveyor

(Belladef.doc)
KEL C.P.M. 4/8/08

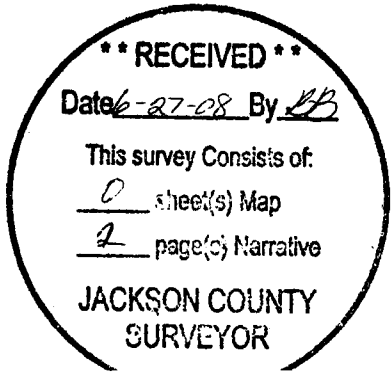


BELLA VISTA HEIGHTS
PHASES 1 AND 2

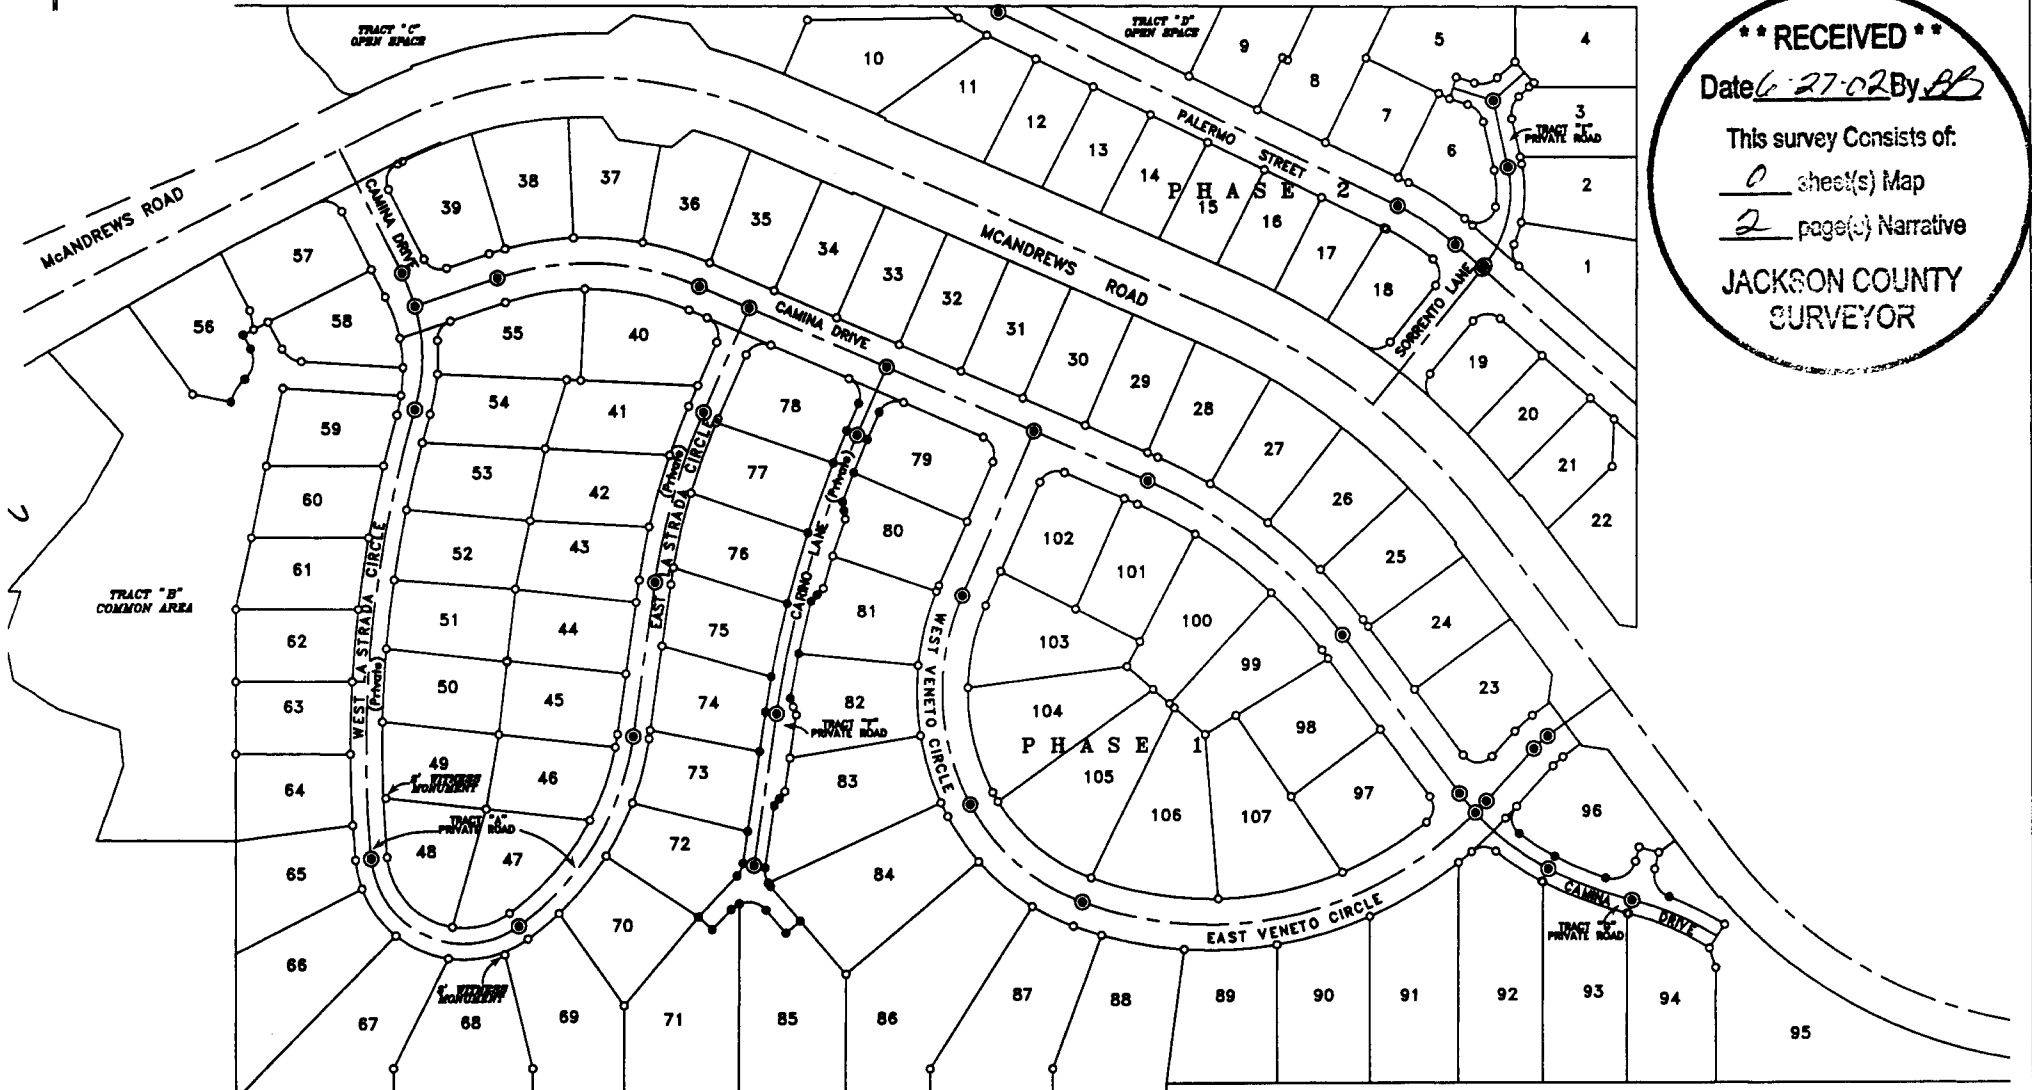

**** RECEIVED ****
 Date 6-27-08 By AB
 This survey Consists of:
0 sheet(s) Map
2 page(s) Narrative
**JACKSON COUNTY
 SURVEYOR**

REGISTERED
 PROFESSIONAL
 LAND SURVEYOR
 David M. Minnecci
 OREGON
 ACT. N. 1984
 DAVID M. MINNECCI
 2349
 EXPIRES 12-31-08

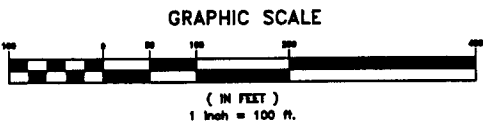

HOFFBURN & ASSOCIATES, INC.
 880 GOLF VIEW DR., STE 201 MEDFORD, OREGON
 (541) 778-4841
 BY: DAVID M. MINNECCI RPLS NO. 2349
 SCALE: 1 INCH = 100' APRIL 8, 2008

- = SET 5/8" x 24" IRON PIN WITH PLASTIC CAP STAMPED "D. MINNECCI LS 2348".
- = SET LEAD PLUG & TACK WITH METAL WASHER STAMPED "LS 2348" IN CONCRETE.
- ⊙ = SET 5/8" x 30" IRON PIN WITH ALUMINUM CAP STAMPED "LS 2348".