# MAP OF SURVEY

LOCATED IN:
THE SE 1/4 OF SECTION 8, TOWNSHIP 39 SOUTH,
RANGE 1 EAST, WILLAMETTE MERIDIAN
CITY OF ASHLAND, JACKSON COUNTY, OREGON

FOR
DAVID GILDERSLEEVE
367 LANTERN HILL DRIVE
ASHLAND, OREGON 97520

DATE: 7-31-2008
SCALE: 1"=20'

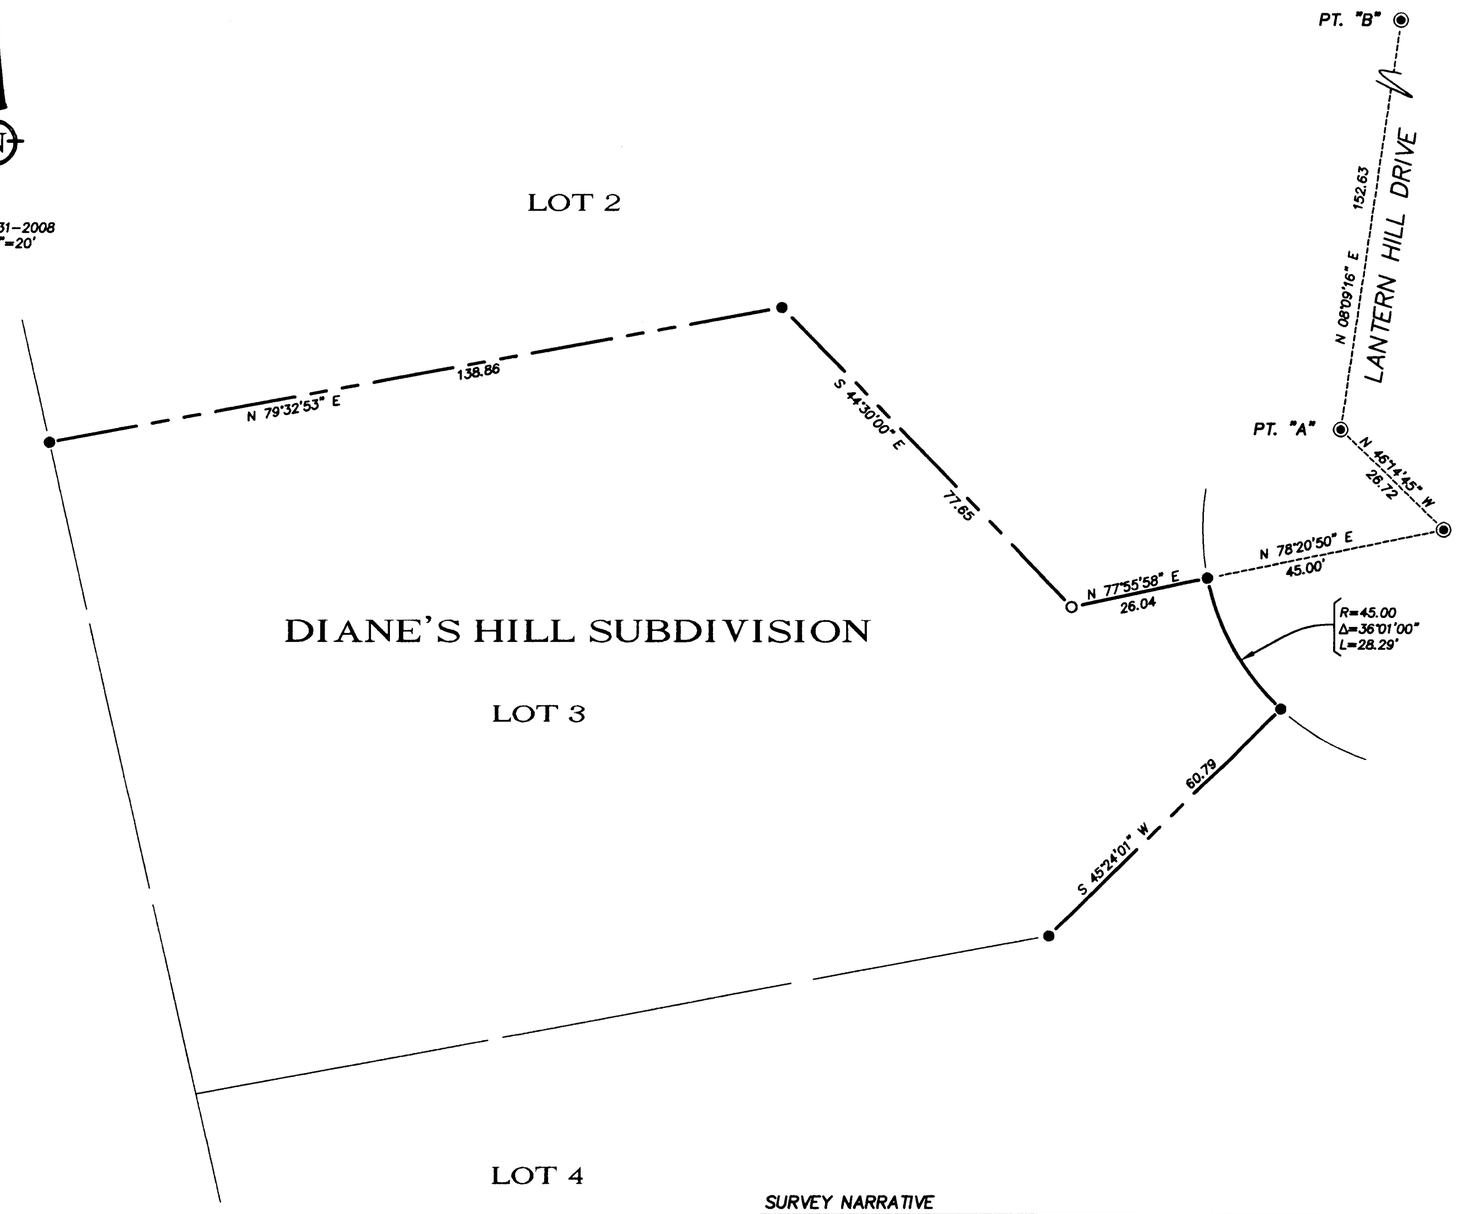


## LEGEND

| | |
|---|---|
| ——— | SURVEYED PROPERTY LINE |
| — — — | EASEMENT |
| ○ | SET 5/8" X 30" IRON PIN W/CAP STAMPED "ALSPACH PLS 2653" |
| ● | FOUND 5/8" IP W/CAP STAMPED MARQUESS & ASSOC. PER DIANE'S HILL SUBDIVISION, FS 14220 |
| ◉ | FOUND 2 1/2" BRASS DISC STAMPED PLS 2464 IN STREET MONUMENT CASE PER DIANE'S HILL SUBDIVISION, FS 14220 |
| ( ) | RECORD DATA WHEN DIFFERENT FROM MEASURED |
| IP | IRON PIN |
| FS | FILED SURVEY |
| DN | DOCUMENT NUMBER, OFFICIAL RECORDS, JACKSON COUNTY, OREGON |
| REF: | REFERENCE |
| DRJCO | DEED RECORDS JACKSON COUNTY OREGON |

ALL DISTANCES ARE IN FEET AND DECIMALS THEREOF

## SURVEY NARRATIVE

TO COMPLY WITH PARAGRAPH 209.250 OREGON REVISED STATUTES

**PURPOSE:** TO MONUMENT A CORNER ON THE NORTHERLY LINE OF LOT 3 OF THE DIANE'S HILL SUBDIVISION FOR WALL CONSTRUCTION

**PROCEDURE:** FOUND EXISTING MONUMENTS FROM THE DIANE'S HILL SUBDIVISION AS SHOWN AND SET MONUMENT HOLDING RECORD DISTANCES AND BEARINGS FROM THE TWO NEAREST FOUND MONUMENTS.

REGISTERED
PROFESSIONAL
LAND SURVEYOR
OREGON
JULY 19, 1994
RICHARD F. ALSPACH
No. 2653
Expires 12-31-2009

RECEIVED
DATE 8-4-08 BY BB
This survey consists of:
1 sheet(s) Map
0 page(s) Narrative
JACKSON COUNTY SURVEYOR

TERRASURVEY, INC.
PROFESSIONAL LAND SURVEYORS
274 FOURTH STREET
ASHLAND, OREGON 97520
(541) 482-6474
terrain@bisp.net

JOB NO. 649-08

## BASIS OF BEARING

FOUND MONUMENTS AT PT. "A" AND PT. "B" AS N 08°09'16" E, PER DIANE'S HILL SUBDIVISION, FILED SURVEY NUMBER 14220

T 39 S, R 1 E, SEC 08 DD TL 909