


20192

EXHIBIT "A"

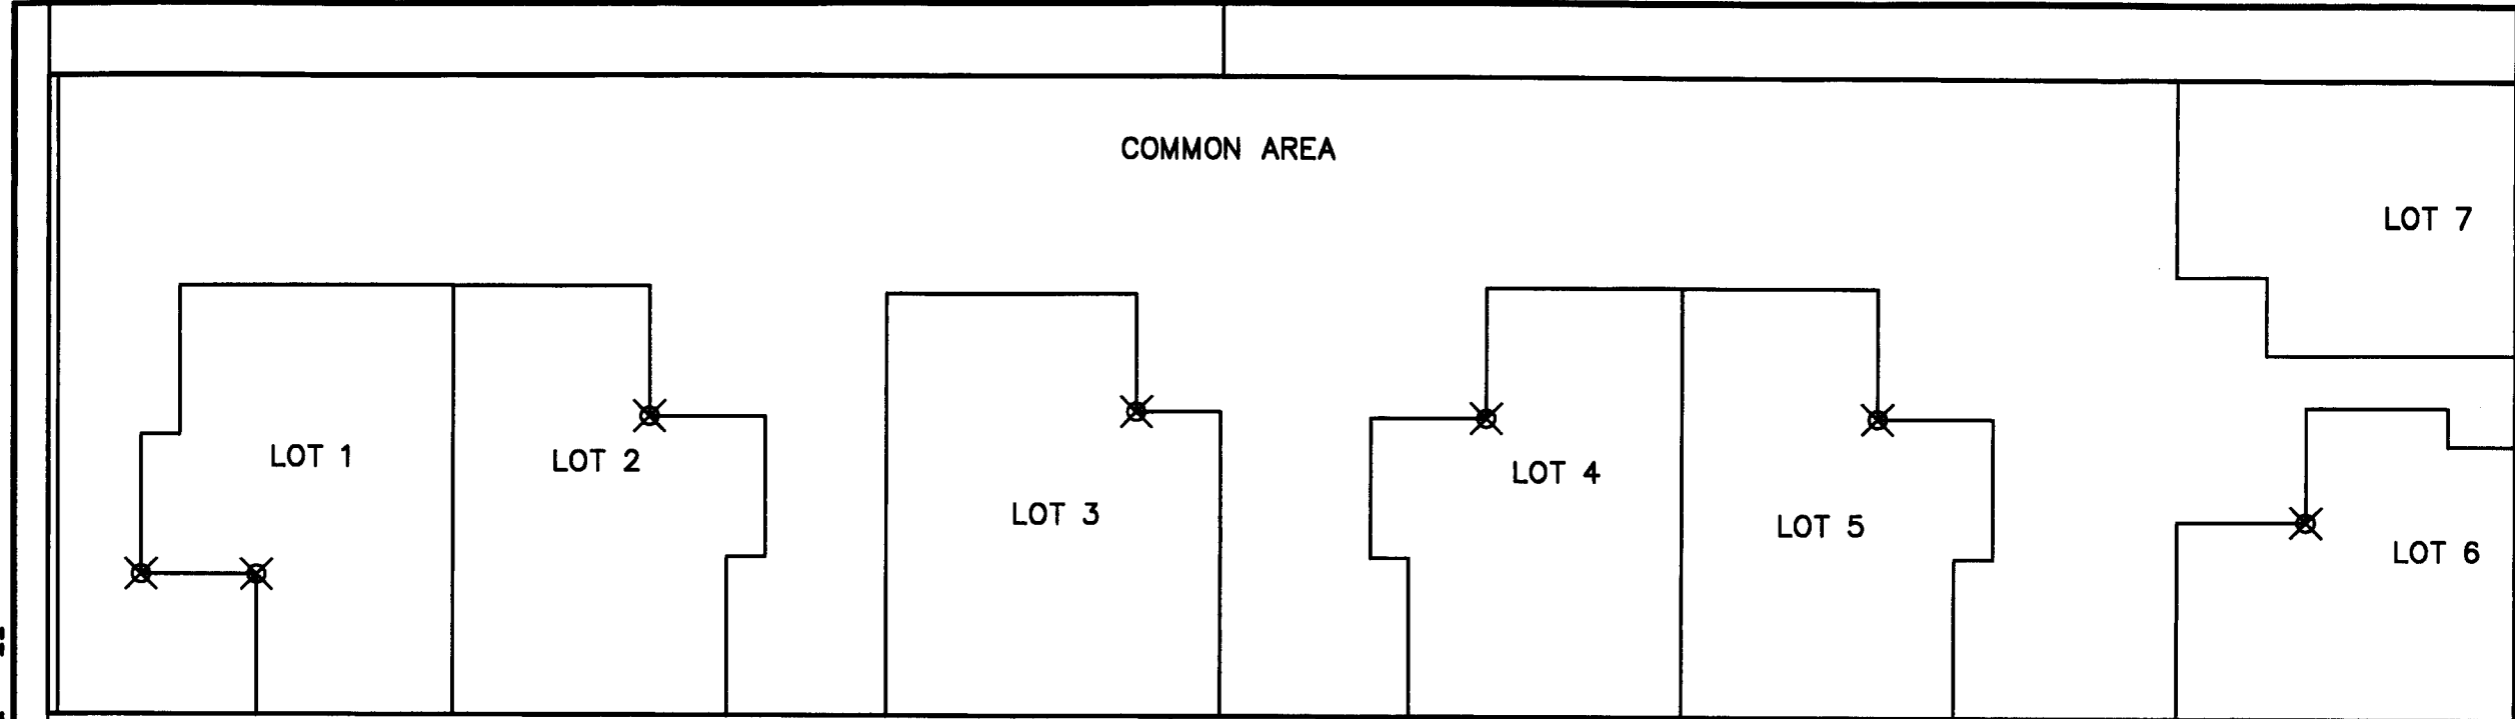

⊗ = SET BRASS TAG MKD. L.J. FRIAR & ASSOC. IN LEAD PLUG IN CONCRETE.



**** RECEIVED ****
 Date 10-20-08 By BB
 This survey Consists of:
0 sheet(s) Map
2 page(s) Narrative
JACKSON COUNTY SURVEYOR

REGISTERED PROFESSIONAL LAND SURVEYOR
James E. Hibbs
 OREGON
 JULY 17, 1986
 JAMES E. HIBBS
 2234
 RENEWAL DATE 6-30-09

TITLE: POST-MONUMENTATION EXHIBIT
SUBDIVISION: SAVANNA KAILEY SUBDIVISION
FOR: MICHAEL BREIHZOLZ
 15644 HIGHWAY 62
 EAGLE POINT, OR 97524

L.J. FRIAR & ASSOCIATES P.C.
 CONSULTING LAND SURVEYORS
 816 W. 8th St., Medford, OR 97501
 (541) 772-2782 lfriar@charter.net
 www.friarandassociates.com

DATE: 18 SEPT 2008
SCALE: 1 inch : 30 feet
DRAWN BY: JEH
CHK BY:
ORIGIN:
ROTATION: 0°
JOB#: 99314FM
 Sheet 1 of 1