
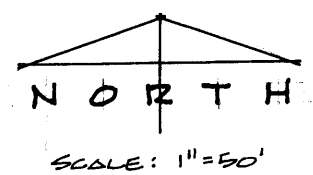


2020

SURVEY FOR
HAROLD W. SMITH
IN LOT 2,
CONSTANT TRACT
CENTRAL POINT, OREGON
BY: MARK E. BOYDEN
SEPTEMBER 1962

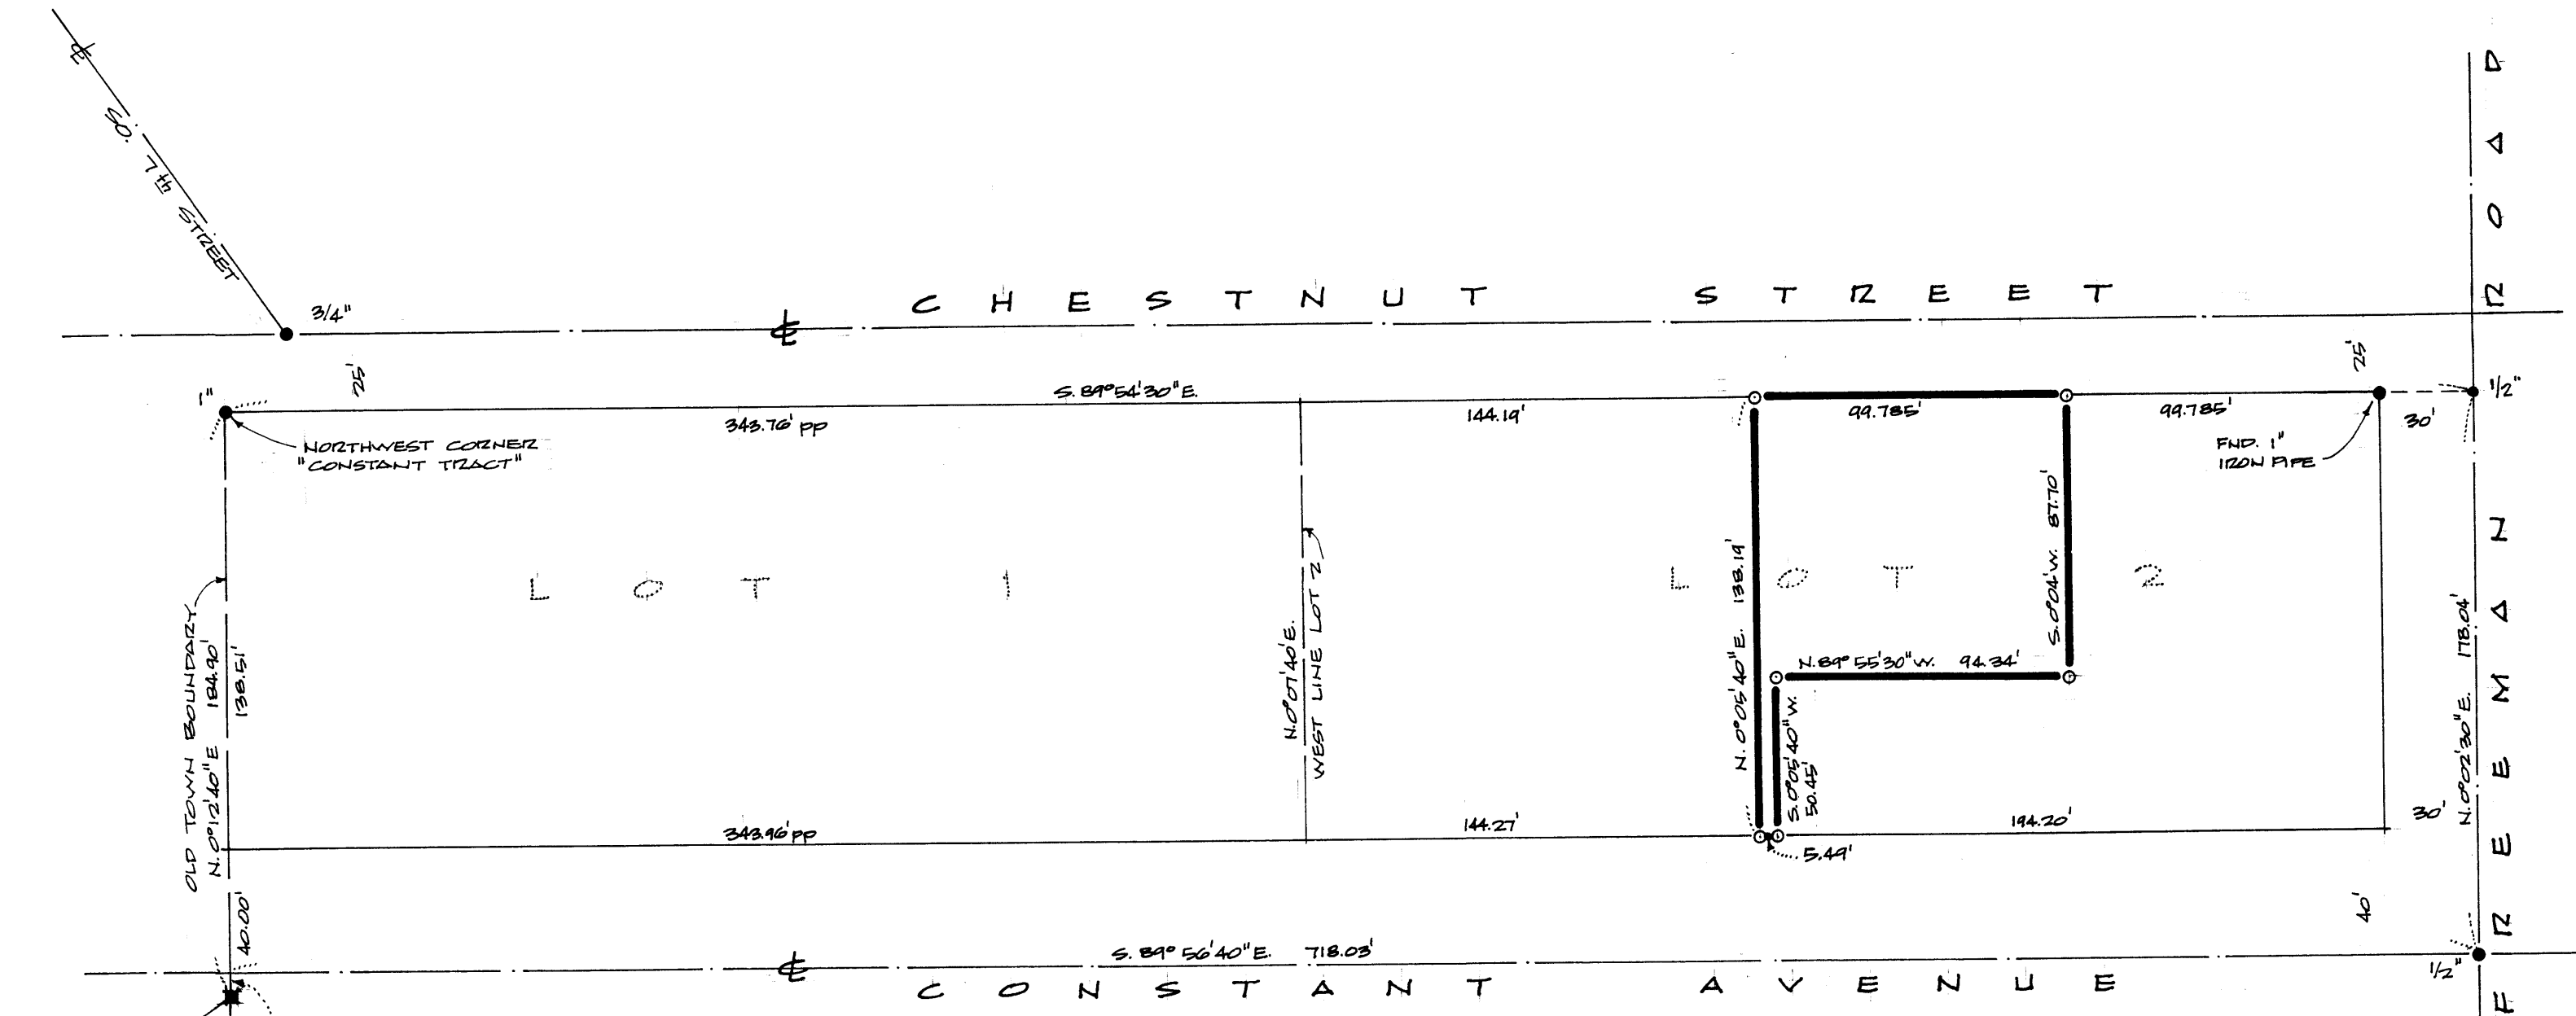

- IRON PIN FOUND
- 5/8" IRON PIN SET
- CONCRETE MONUMENT FOUND

OREGON
LAND SURVEYOR
Mark E. Boyden
SEP 1962

SURVEY NARRATIVE TO COMPLY WITH O.R.S. 209.250

FOR: Harold W. Smith
Chestnut Street
Central Point, Oregon

LOCATION: Lot 2, CONSTANT TRACT, Central Point, Oregon

PURPOSE: To monument the boundaries of the Smith
property described in Title and Trust
Company Title Insurance Policy #72012.

PROCEDURE:

Found the Block control monuments previously
set for the city of Central Point in June 1952.

In that the segregation deeds for Lot 2 have
assumed the original plat distances to be correct,
actual laps or gaps would occur at each individual
property line.

Assuming the original intent was to divide the lot
on a proportional basis, the Smith tract boundaries
were so monumented with 5/8" iron pins.

September 1962

