


Map of Survey

LOCATED IN THE
THE SOUTHWEST 1/4 OF SECTION 2, THE SOUTHEAST 1/4 OF SECTION 3,
AND THE NORTH EAST 1/4 OF SECTION 10, TOWNSHIP 37 SOUTH, RANGE 2 WEST,
WILLAMETTE MERIDIAN, CITY OF CITY OF CENTRAL POINT, JACKSON COUNTY, OREGON

SURVEY FOR: CITY OF CENTRAL POINT
140 SOUTH 3RD STREET
CENTRAL POINT, OREGON 97502

LEGEND

- - FOUND BRASS CAP MONUMENT (UNLESS OTHERWISE NOTED)
- - FOUND 5/8" IRON PIN (UNLESS OTHERWISE NOTED)
- ▲ - FOUND 3" BRASS CAP STAMPED "LS 2271" PER FS 20144
- ⊙ - SET 3" BRASS DISC IN MONUMENT CASE STAMPED "LS 2271"
- FS - FILED SURVEY NUMBER
- () - RECORD PER SURVEY NUMBER
- JCGN = JACKSON COUNTY GEODETIC NETWORK

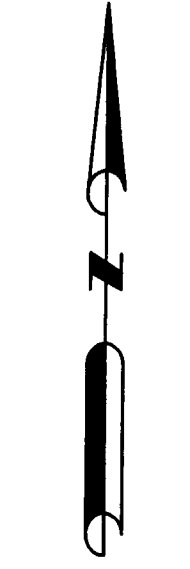


SCALE 1"=200'

BASIS OF BEARING FROM PREVIOUS GPS SURVEY
WORK (WGS 84)

NARRATIVE

A WILD T-1000 TOTAL STATION WAS USED TO TIE FOUND CENTERLINE MONUMENTS IN A CONTROL TRAVERSE. USING SAID FOUND MONUMENTS AND RECORD INFORMATION FROM FILED SURVEYS SHOWN HEREON, MONUMENTS WERE SET AS SHOWN AND THE MAP PREPARED. THIS SURVEY WORK WAS DONE IN CONJUNCTION WITH A STREET CENTERLINE MONUMENT REFERENCING AND REPLACEMENT PROJECT BY THE CITY OF CENTRAL POINT. A MAP WAS NOT FILED AT THE TIME OF THE SURVEY WORK, DUE TO CONFUSION RELATED TO A MUNICIPALITY'S AUTHORITY TO SET AND REPLACE CITY STREET MONUMENTS WITHOUT THE REQUIREMENT TO FILE A MAP. THE CURRENT COUNTY SURVEYOR HAS REQUESTED A MAP BE FILED REGARDLESS, AND WE AGREE.

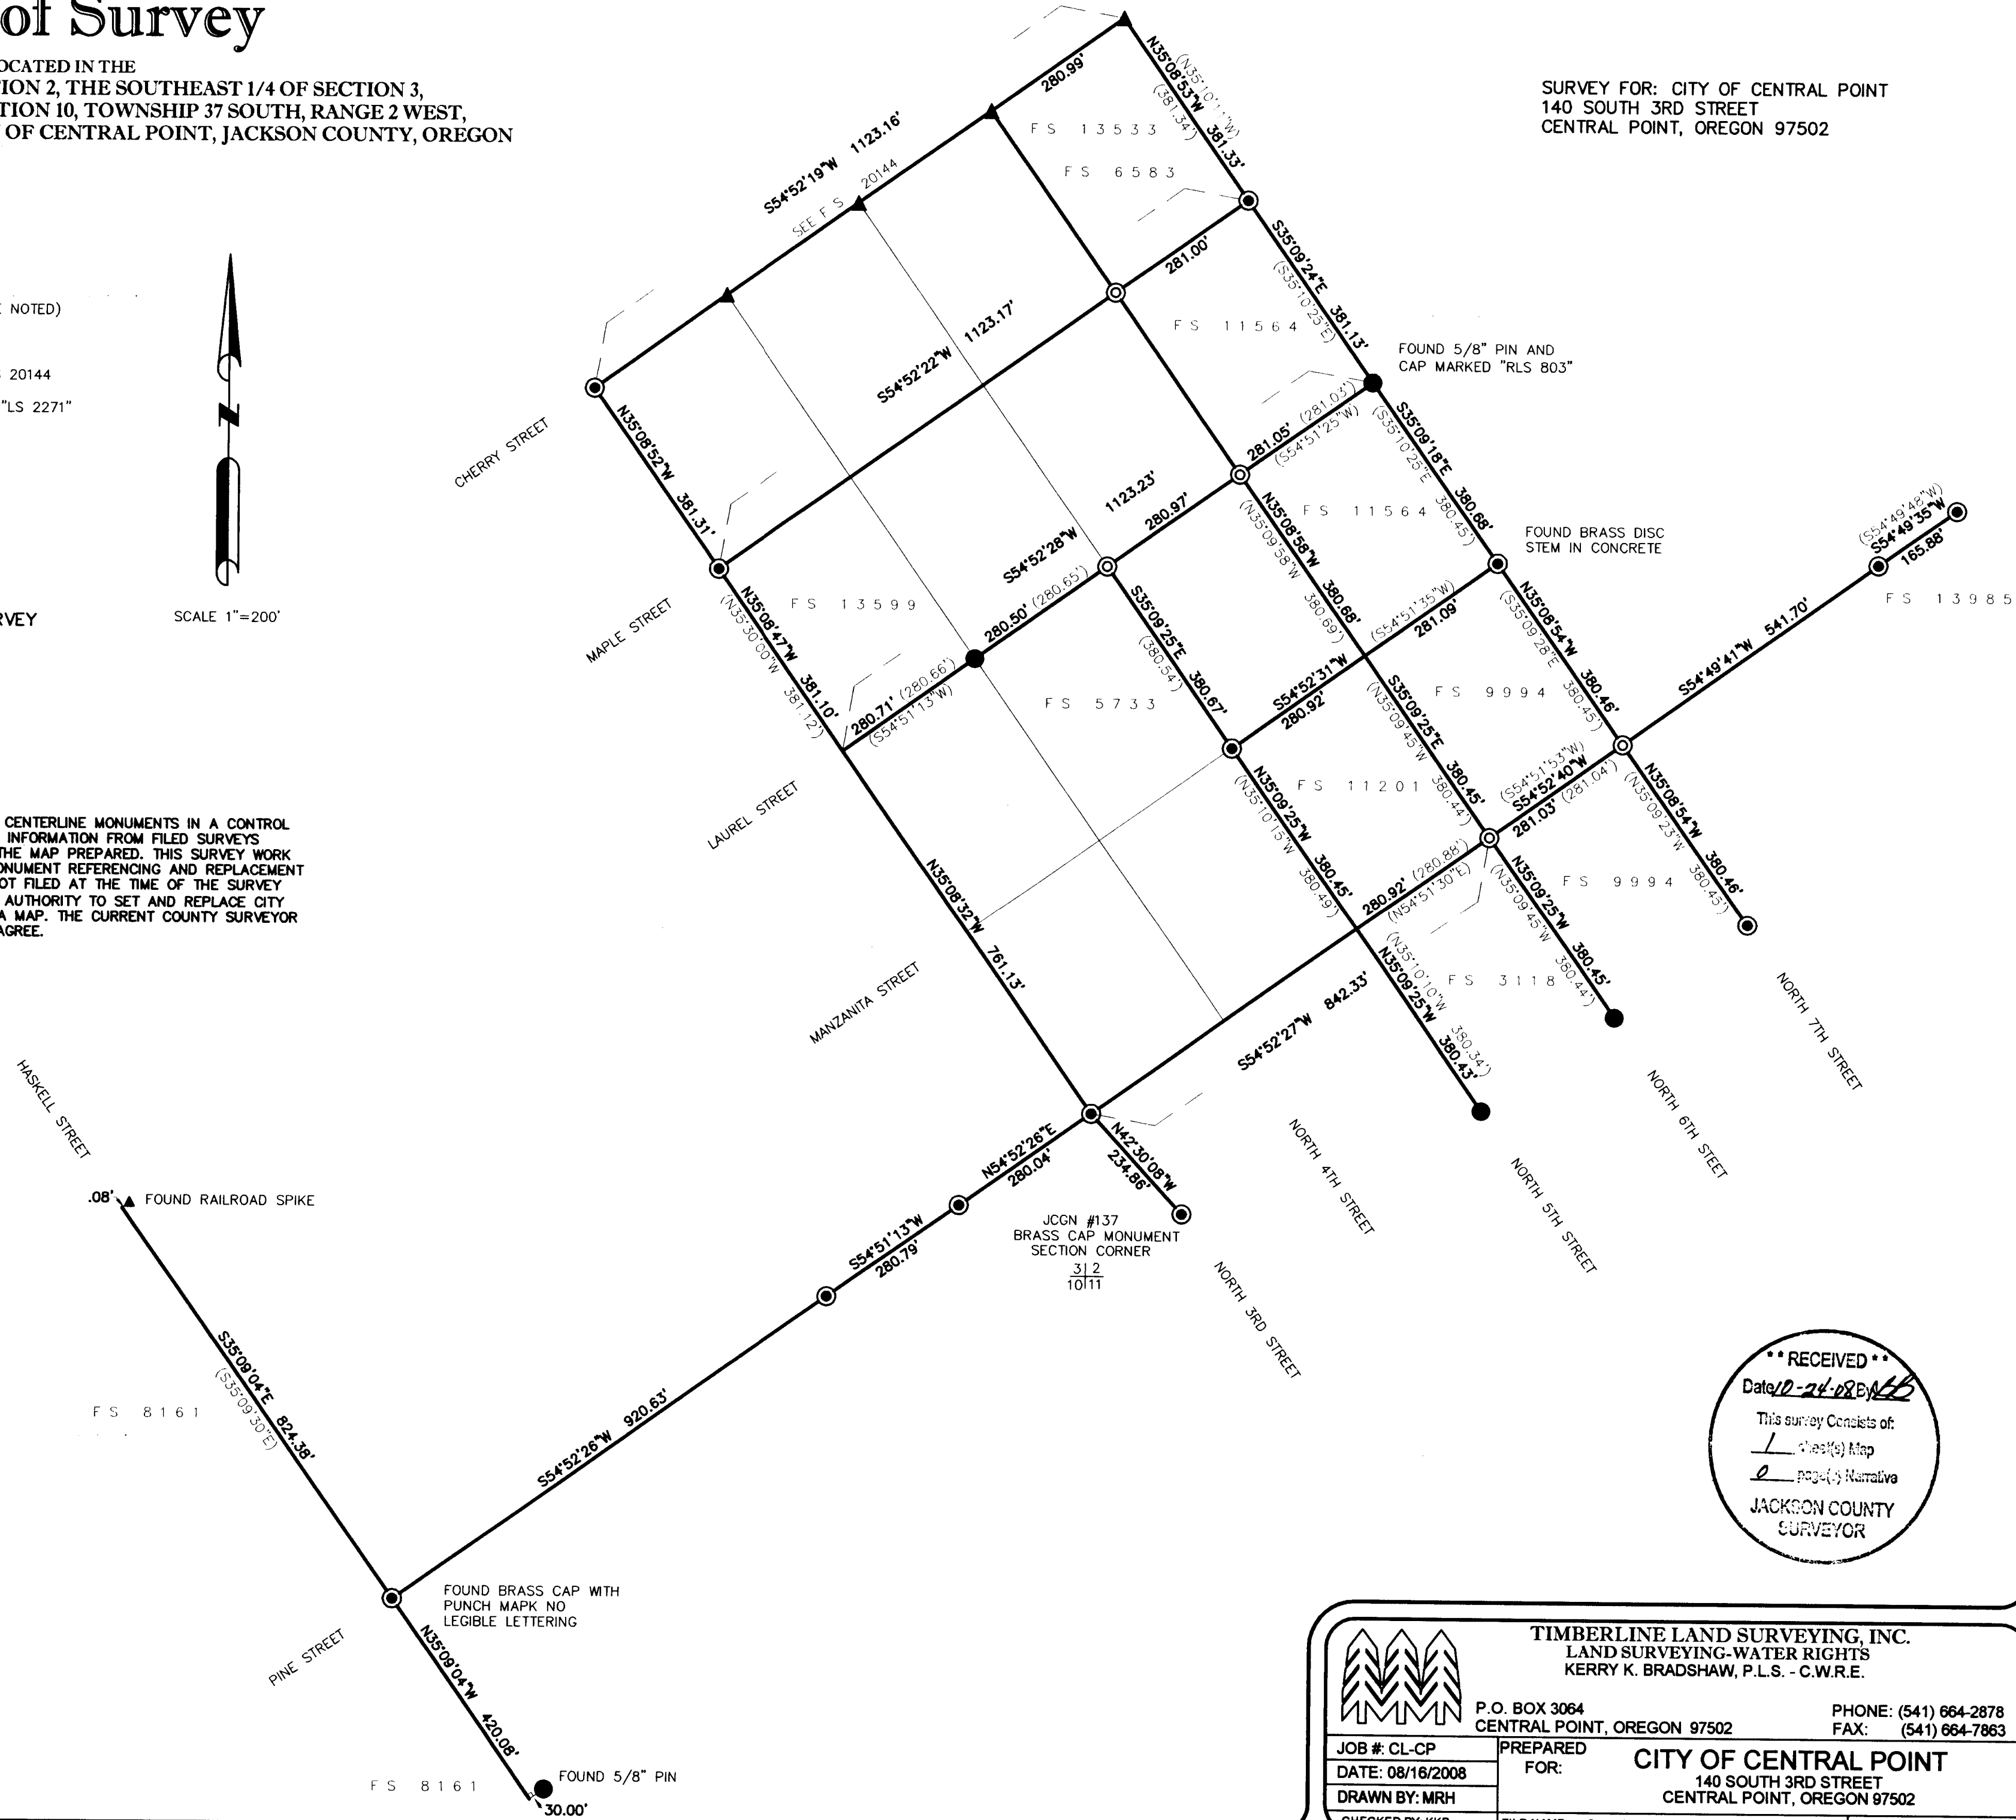

REGISTERED
PROFESSIONAL
LAND SURVEYOR

Kerry K. Bradshaw

OREGON
JULY 16, 1987
KERRY K. BRADSHAW
2271

EXP. 12-31-09

RECEIVED

Date 10-24-08 By *MRH*

This survey consists of:
1 sheet(s) Map
0 page(s) Narrative

JACKSON COUNTY
SURVEYOR

TIMBERLINE LAND SURVEYING, INC.
LAND SURVEYING-WATER RIGHTS
KERRY K. BRADSHAW, P.L.S. - C.W.R.E.

P.O. BOX 3064
CENTRAL POINT, OREGON 97502

PHONE: (541) 664-2878
FAX: (541) 664-7863

| | | |
|------------------|---|--|
| JOB #: CL-CP | PREPARED FOR: | CITY OF CENTRAL POINT 140 SOUTH 3RD STREET CENTRAL POINT, OREGON 97502 |
| DATE: 08/16/2008 | FOR: | |
| DRAWN BY: MRH | | |
| CHECKED BY: KKB | FILE NAME: Centerline-Map of Survey-Central Point.dwg | SHEET 1 OF 1 |