


SURVEY FOR :
 NORTHWEST PACIFIC DEVELOPMENT CORP.
 Located in Block 4, Galloway's Add.
 Medford, Oregon
 By : Mark E. Boyden
 April, 1962

2021

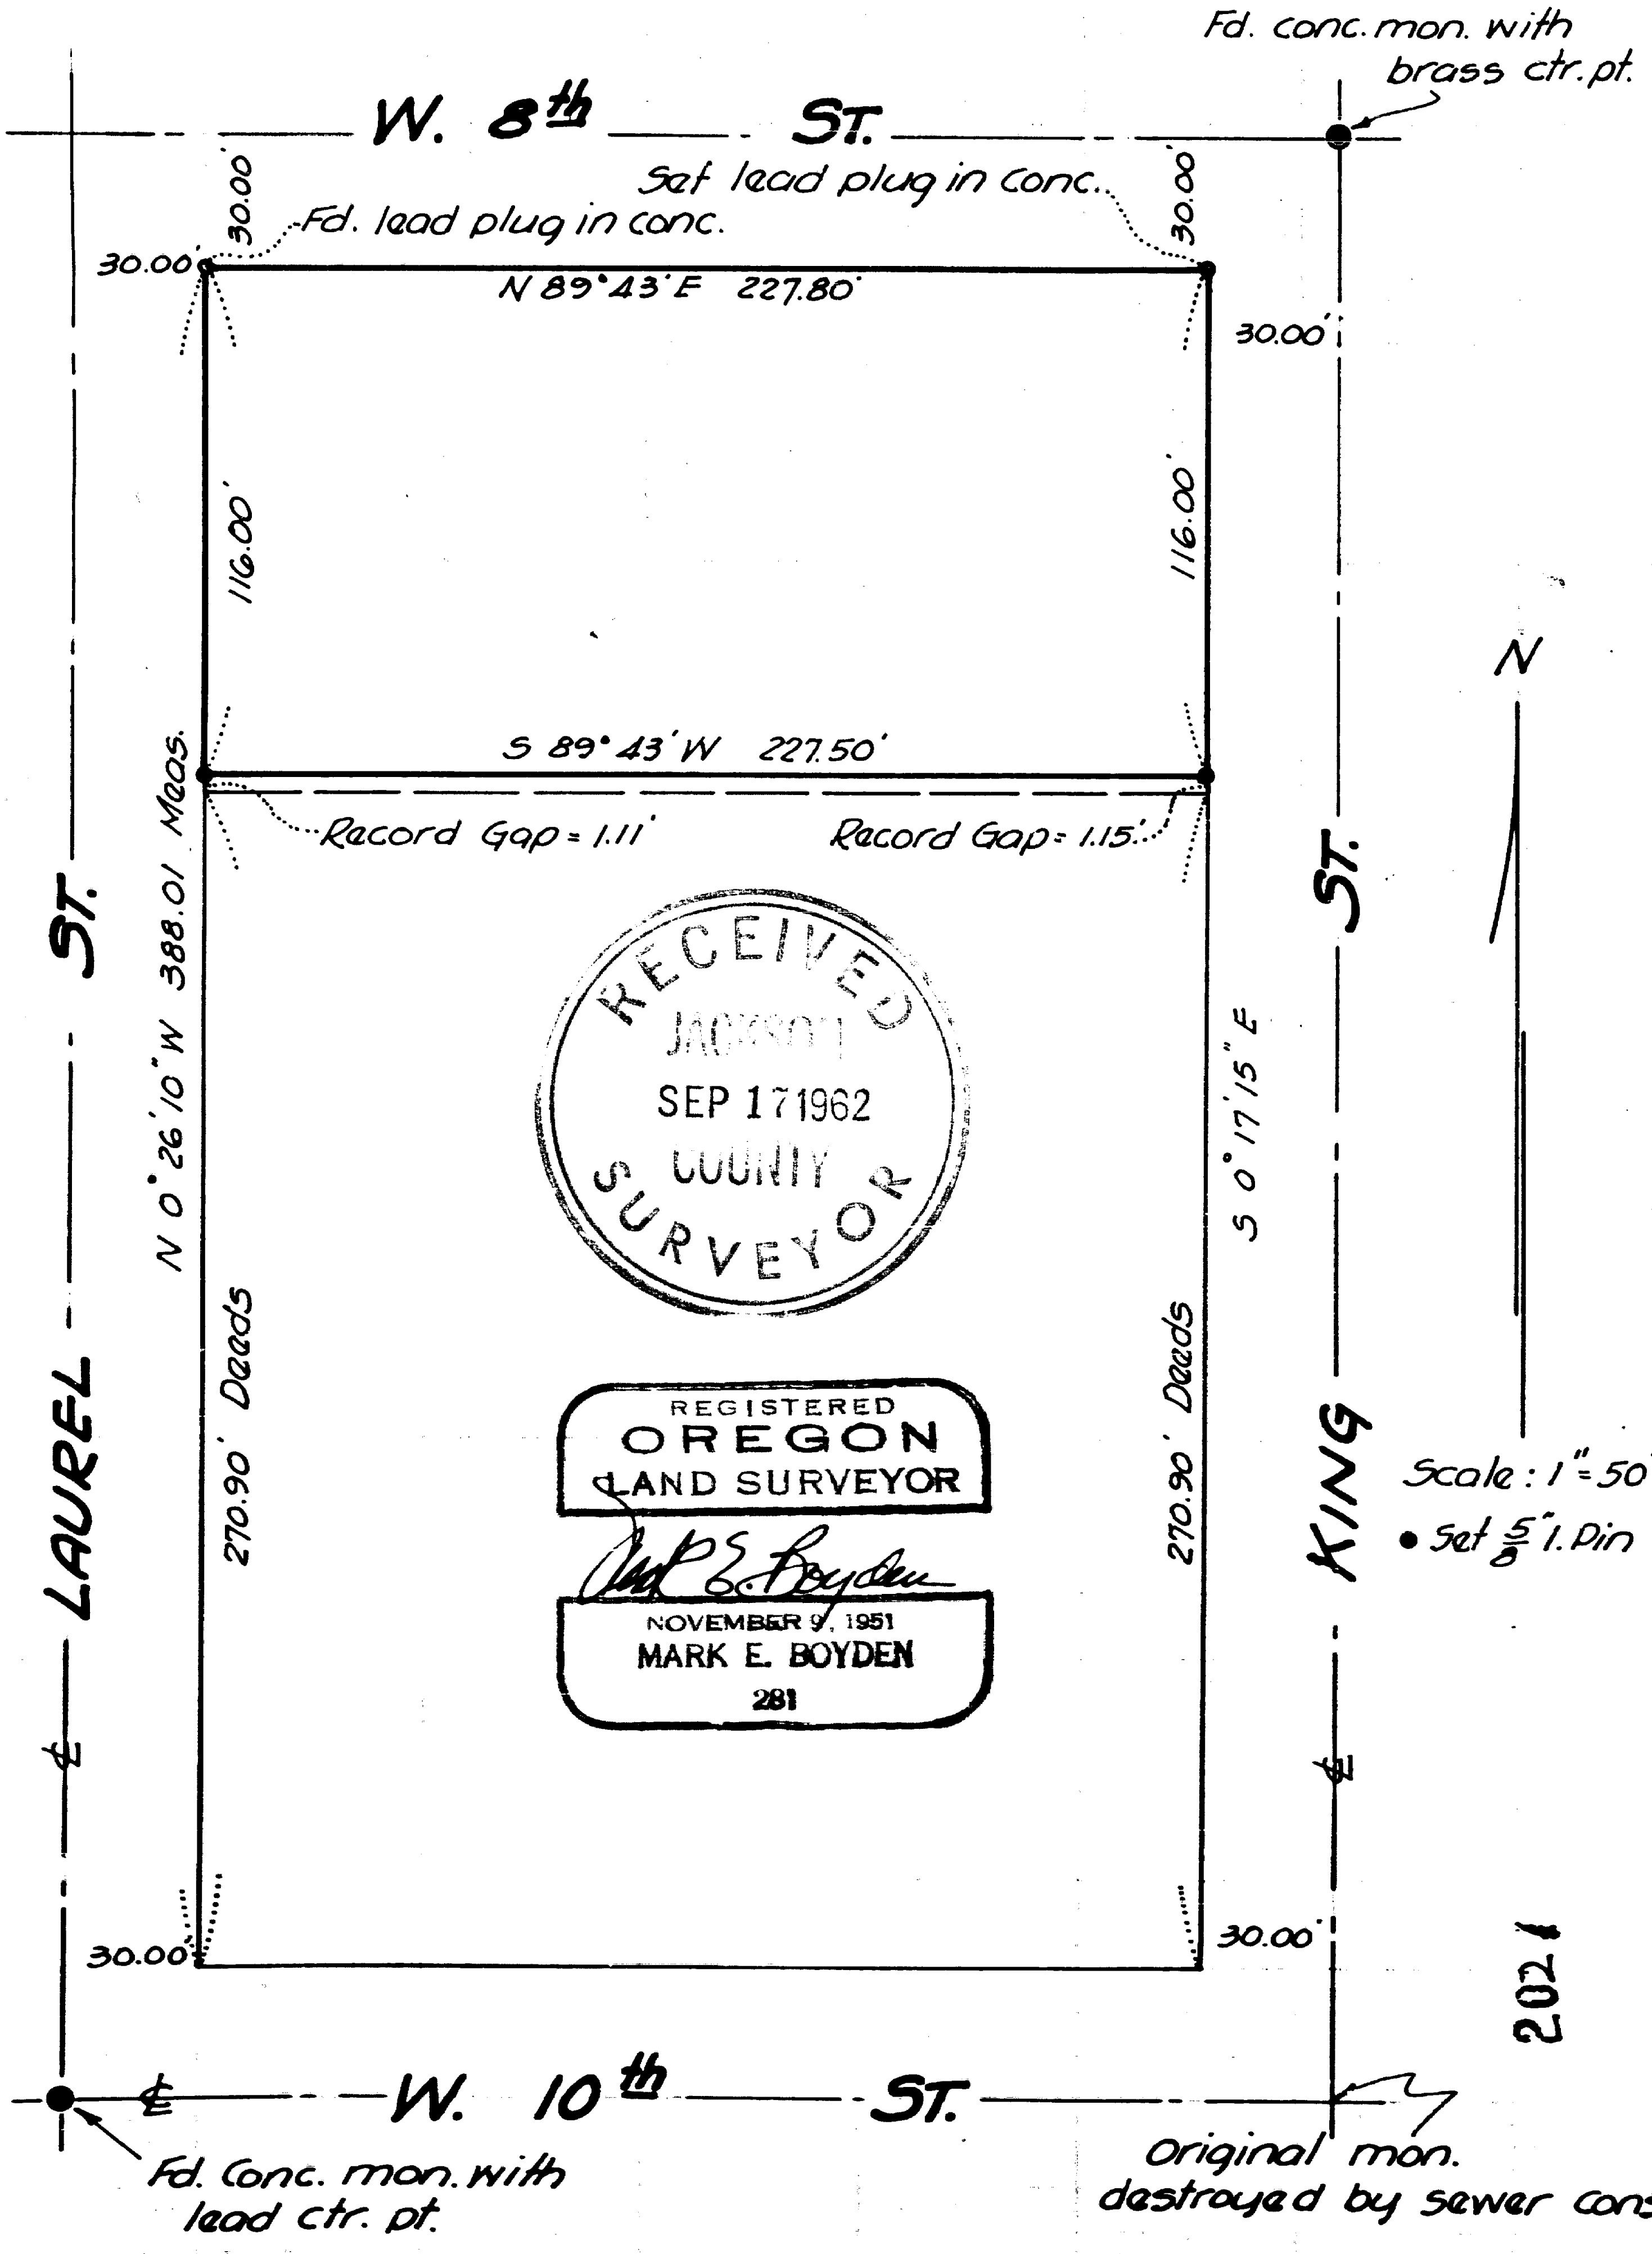

REGISTERED
 OREGON
 LAND SURVEYOR

Mark E. Boyden
 NOVEMBER 9, 1951
 MARK E. BOYDEN
 281



Scale: 1" = 50'
 • Set 5/8" Pin

2021

SURVEY NARRATIVE TO COMPLY WITH O.R.S. 209.250

FOR: Northwest Pacific Development Corp.
1 King Street
Medford, Oregon

LOCATION: Block 4, GALLOWAY'S ADDITION

PURPOSE: To monument the outside boundary of those tracts described in Jackson County Title Co. Title Insurance Policy Nos. 79270, 79271, and 79090.

PROCEDURE:

Previous surveys by C. Z. Boyden (See Recorded Survey Nos. 98 & 113) established the Block control and monumented the West parcel.

In that no record could be found of the present ownerships having acquired title to the deed record gap as shown, the tracts were monumented according to deed record distance South from the present South boundary of West Eighth Street.

September 1962

