

**SURVEY NARRATIVE  
TO COMPLY WITH O.R.S. 209.250**

PURPOSE: TO SURVEY AND MONUMENT THIS PROPERTY LINE ADJUSTMENT AS APPROVED BY THE CITY OF JACKSONVILLE PLANNING DEPARTMENT.  
PROCEDURE: UTILIZING CONTROL ESTABLISHED DURING SURVEY 17796 I MONUMENTED THE NEW BOUNDARY AS SHOWN HEREON.

REGISTERED  
PROFESSIONAL  
LAND SURVEYOR  
*Herbert A. Farber*  
OREGON  
JULY 26, 1985  
HERBERT A. FARBER  
2189  
RENEWAL DATE 12-31-09



~~TENTATIVE PLAN~~  
**PROPERTY LINE ADJUSTMENT**

located in the  
SOUTHEAST ONE-QUARTER OF SECTION 31 AND  
THE SOUTHWEST ONE-QUARTER OF SECTION 32,  
TOWNSHIP 37 SOUTH, RANGE 2 WEST,  
WILLAMETTE MERIDIAN, CITY OF JACKSONVILLE,  
JACKSON COUNTY, OREGON

for  
**MICHAEL MATHEWS**

P.O. BOX 1768  
JACKSONVILLE, OREGON 97530

and

**EARNEST & LILLIAN STEDMAN**

P.O. BOX 846  
JACKSONVILLE, OREGON 97530

**LEGEND**

- = SET 5/8" IRON PIN, WITH YELLOW PLASTIC CAP "FARBER PLS. 2189"
  - = FOUND 1/2" IRON PIN, S/N 17492
  - = FOUND 5/8" IRON PIN, S/N 10515
  - = FOUND 5/8" IRON PIN, S/N 3949
  - ▽ = FOUND 1/2" IRON PIN, S/N 3949
  - = FOUND 5/8" x 24" IRON PIN w/ YELLOW PLASTIC CAP MARKED "FARBER PLS 2189" PER S/N 17796
  - S/N = RECORD FILED SURVEY NUMBER
  - D.R. = DEED RECORD
- BASIS OF BEARING IS TRUE NORTH, NAD 83/91 DATUM, AS DERIVED BY GLOBAL POSITIONING SYSTEM OBSERVATIONS.  
- RECORD SURVEY DATA IS SHOWN IN PARENTHESIS ADJACENT TO MEASURED SURVEY DATA WHERE APPLICABLE.  
- INST. No. = INSTRUMENT NUMBER AS RECORDED IN THE OFFICIAL RECORDS OF JACKSON COUNTY, OREGON.

STRAWBALE VILLAGE  
VOLUME 31, PAGE 3  
PLAT RECORDS  
S/N 18961


PARCEL No. 1  
P-59-2002  
S/N 17492

TAX LOT 2002  
37-2W-32CC TL2002

PARCEL NO. 1,  
INSTRUMENT NUMBER 2008-38909

EXAMINED AND APPROVED BY JACKSONVILLE PLANNING ADMINISTRATION

BY: *[Signature]* DATE: 11/20/2008

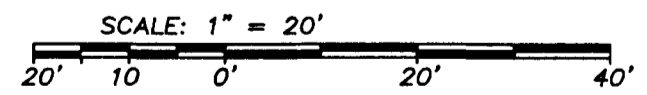

STRAWBALE VILLAGE

37-2W-31DD TL300  
INST. NO. 2008-38910  
AREA 23306 Sq.ft.

STRAWBALE VILLAGE

\*\* RECEIVED \*\*  
DATE 11-25-08 BY *AB*  
This survey consists of:  
1 sheet(s) Map  
2 page(s) Narrative  
JACKSON COUNTY  
SURVEYOR