



I, Christine Walker, County Clerk for Jackson County, Oregon, certify that the instrument identified herein was recorded in the Clerk records. Christine Walker - County Clerk

**AFFIDAVIT OF MONUMENTATION  
FOR  
DEFERRED MONUMENTS**



20289

**KNOW ALL MEN BY THESE PRESENTS**, that I, David M. Minneci, a duly Registered Professional Land Surveyor in the State of Oregon, do hereby affirm that I have established with proper monuments as required by law those monuments shown as deferred on the Official Plat of **HILLCREST OFFICE PARK** as recorded in Volume 34 of Plats, Page 29 of Records in Jackson County, Oregon.

(See Exhibit "A" attached)

This Affidavit is to comply with Chapter 92.070 of the Revised Statutes of the State of Oregon.

In Witness Hereof, signed this 29<sup>th</sup> day of DECEMBER, 2008.

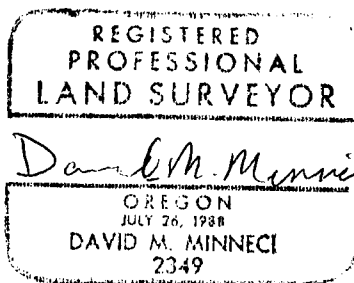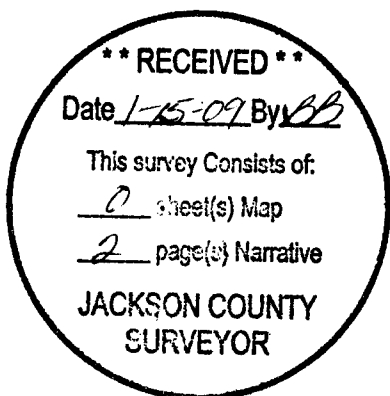


Expires 12/31/10

STATE OF OREGON ) ss.  
County of Jackson )

On this 29 day of December, 2008, personally appeared the above named David M. Minneci, a Registered Professional Land Surveyor, and acknowledged the foregoing instrument to be his voluntary act and deed.

Before me:

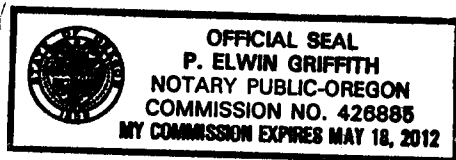

P. Elwin Griffith

Notary

Approved: \_\_\_\_\_

Medford City Surveyor

[Signature]

1/5/08  
Date

Examined and approved this 12 day of January, 2009.

Kerry K. Bradsher  
Jackson County Surveyor


20289

EXHIBIT "A"

HILLCREST OFFICE PARK

POST MONUMENT MAP

Located in:  
the Northeast 1/4 of Section 28,  
Township 37 South, Range 1 West, W.M.,  
In the City of Medford,  
Jackson County, Oregon

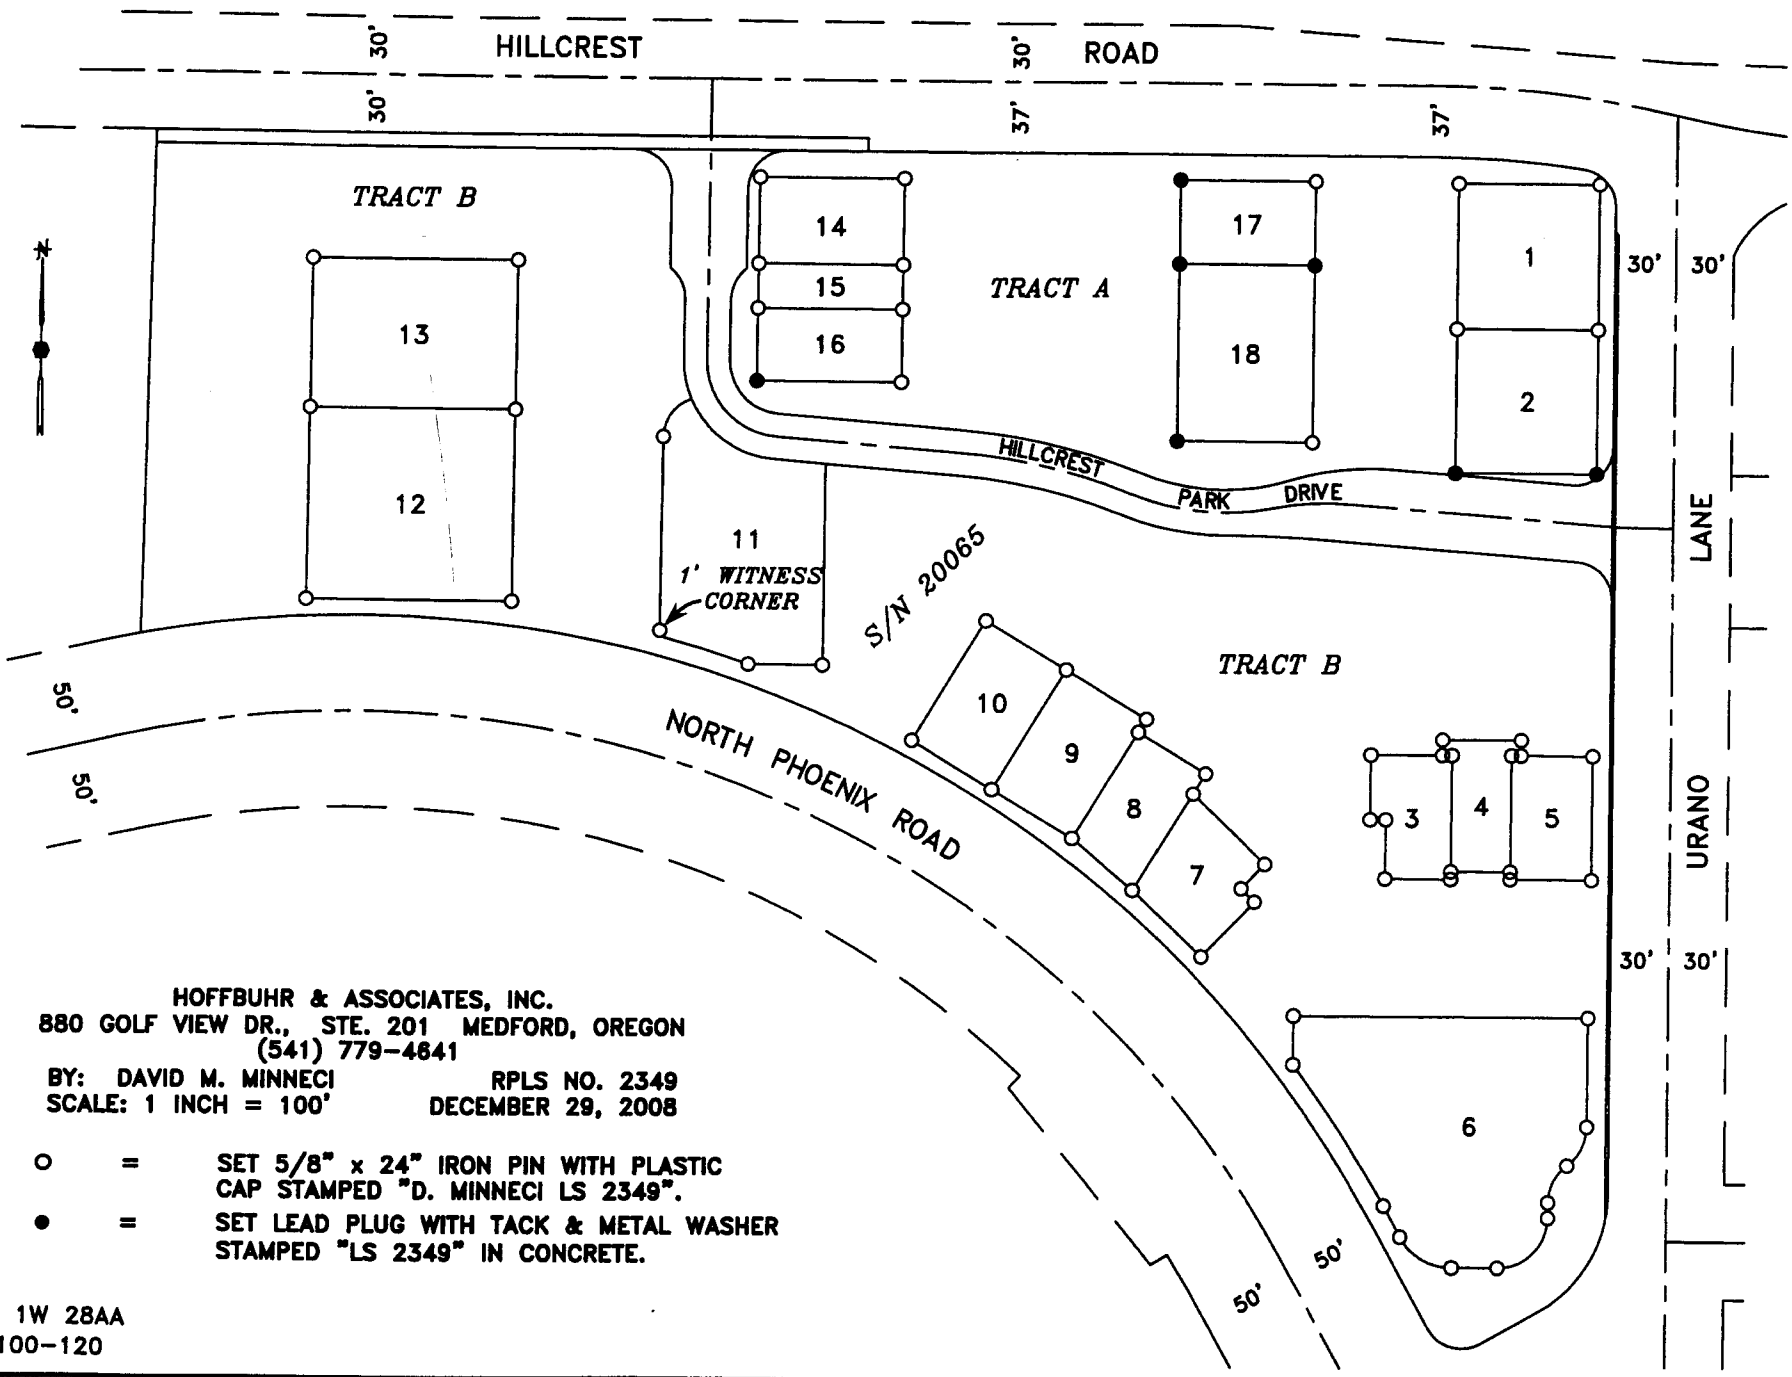

**\*\* RECEIVED \*\***  
Date 1-15-09 By BB  
This survey consists of:  
0 sheet(s) Map  
2 page(s) Narrative  
JACKSON COUNTY  
SURVEYOR

HOFFBUHR & ASSOCIATES, INC.  
880 GOLF VIEW DR., STE. 201 MEDFORD, OREGON  
(541) 779-4841

BY: DAVID M. MINNECI RPLS NO. 2349  
SCALE: 1 INCH = 100' DECEMBER 29, 2008

- = SET 5/8" x 24" IRON PIN WITH PLASTIC CAP STAMPED "D. MINNECI LS 2349".
- = SET LEAD PLUG WITH TACK & METAL WASHER STAMPED "LS 2349" IN CONCRETE.

REGISTERED  
PROFESSIONAL  
LAND SURVEYOR

*David M. Minnici*

OREGON  
JULY 29, 1988  
DAVID M. MINNECI  
2349

EXPIRES 12/31/10

37S 1W 28AA  
TL 100-120

(06052DEF.DWG)

2

20289