

FD. STONE W/X  
SEC. COR.  
33/34  
4/3

S 89°46'00"E 1334.09' (REC. S 89°26'E 1320.0')  
40' WIDE CAMERON ROAD  
S 89°46'00"E 1334.09' ±

FD. 1" IRON PIN W/PUNCH  
WEST 1/16 SEC. COR.

FD. IRON PIN

13.50  
SOUTH

30' 30"

PARCEL "A"  
12.645' AC. ±

S 27°53'50"W 281.4  
(REC. S 28°19'30"W)

REC. POSITION  
N 1/16 LINE

REC. POSITION OF N-S SECTION LINE  
NORTH 433.0'  
NORTH 498.91'

WITNESS CORNER

N 89°46'00"W 1168.79' ±  
1118.79'

FD. 3/4" IRON BOLT, R/W

L=234.26 R=984.93  
LC. S 16°32'30"W 233.71  
LC S 25°37'35"W 78.05  
L=780.8



PARCEL "B"  
12.625 AC. ±

30' 30" FD 3/4" IRON, BOLT, R/W  
P.T.

S 9°43'40"W 278.41'  
(REC. S 10°10'W)  
APPLEGATE ROAD

WITNESS CORNER

N 89°46'00"W 1005.21'  
1055.21' ±

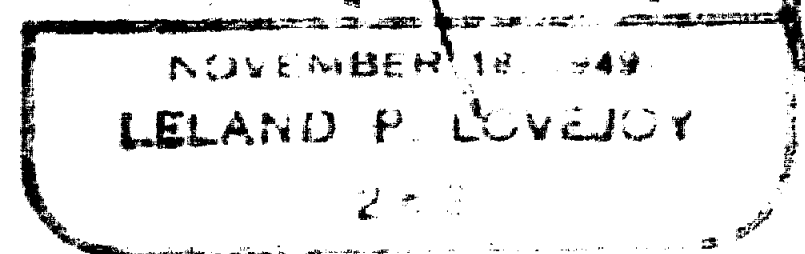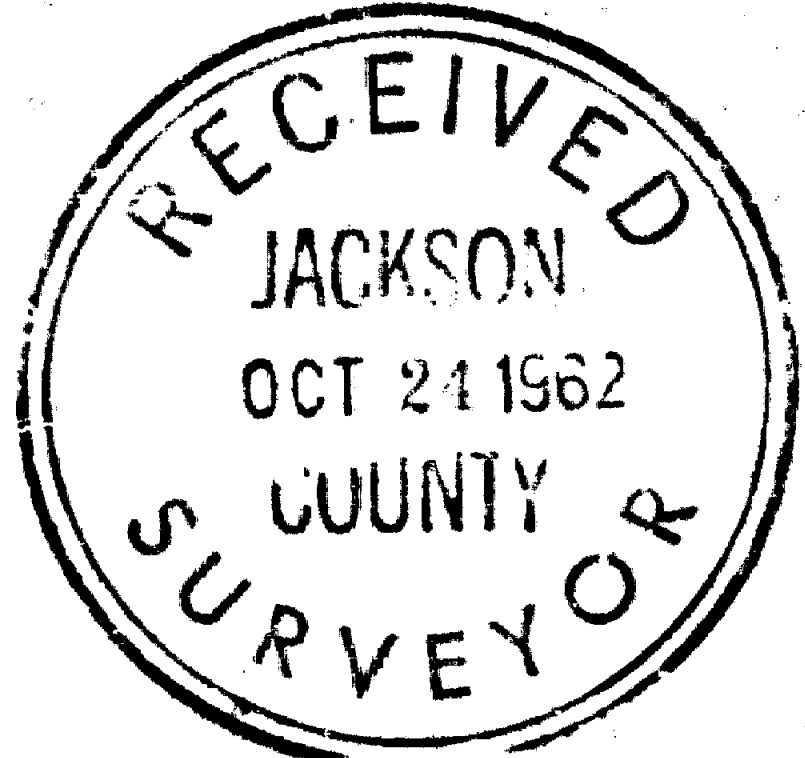

LOCATION OF PROPERTY  
SITUATED IN  
NW 1/4 OF NW 1/4 SEC. 3, T39S,  
R 3W, W.M., JACKSON COUNTY, ORE.  
FOR  
L.R. LOVEJOY L.S. MEDFORD, ORE.  
SCALE: 1"=100' 10-5-62  
BEARINGS BY PREVIOUS SURVEY  
○ = SET 5/8" IRON PIN

Survey Narrative to Comply with Section 87-3301947 Oregon State Laws

Survey For: Orval L. Shores  
Route 2, Box 114  
Jacksonville, Oregon

Purpose of Survey: To establish property boundaries of  
land sold.

Survey Location: Northwest Quarter (1/4), Section 3,  
Township 39 South, Range 3 West,  
Willamette Meridian, Jackson County,  
Oregon.

Survey Procedure: Found One-Sixteenth, Section, and other  
survey corners and road right-of-way  
monuments, etc., and used as a basis  
of survey control. Set 5/8" steel pins  
as shown on map.

Leland P. Lovejoy  
Registered Land Surveyor

Work Completed October 5, 1962

