

SURVEY IN SEC. 34 T. 33 S., R. 1 E., WM.
 FOR
 JOE HENDERSON
 58-21

BY EDWARD MC GINTY
 MEDFORD OREGON
 SEPT 1962

SCALE 1"=100'
 ● 5/8" I. PIN
 ○ 1. PIPE

REGISTERED
 OREGON
 LAND SURVEYOR

Edward G. McGinty

JULY 10, 1953
 EDWARD G. MCGINTY
 301

2 huc

2043

Survey No. 2043

Survey Narrative to comply with O.R.S. 209-250.

Survey for: Joe Henderson
S.R. 3, Box 1292, Trail

Survey by: Edward A. McGinty, L.S.
11/27/62

BASIS OF BEARING: Solar Observation, Previous Survey.

PRECEDENCE OF SURVEY:

West line of survey, Big Butte Creek.



South line, determined at request of client.

On East line, surveyed down existing County Road, set iron pins at P.I. due to the possible re-location of the road by the Co. Engineers ofc. no final location was attempted on this survey.

Description was prepared by lines surveyed, then excluded any portion which may lie within the Co. Road.

The north line was determined from monuments found that were set on Survey No. 275 of Co. Survey records.

Client was informed and is aware of the possible conflict in this line as to Sur. No. 275, also Deed conflicts which may exist were prepared from Sur. No. 275.

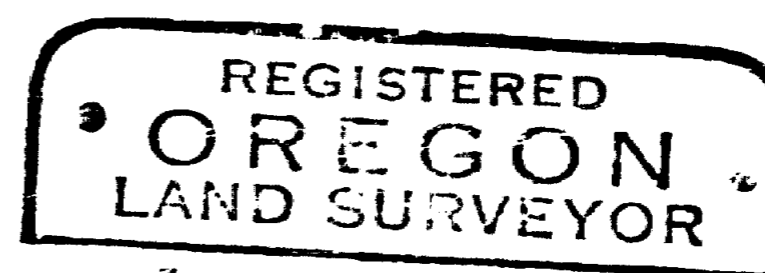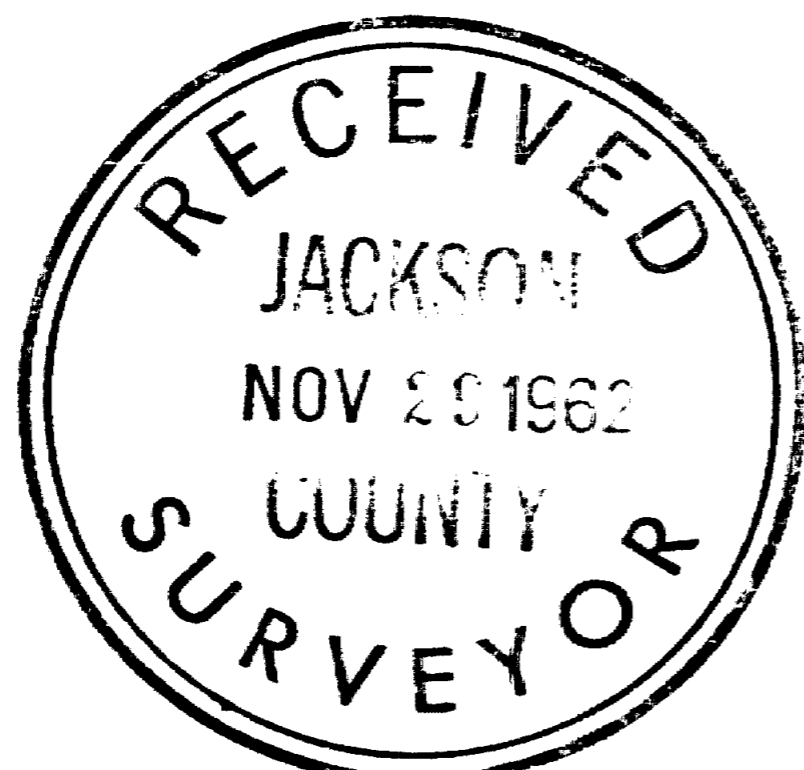

Edward A. McGinty
EDWARD A. MCGINTY
331