


DETAIL "A"
NOT TO SCALE

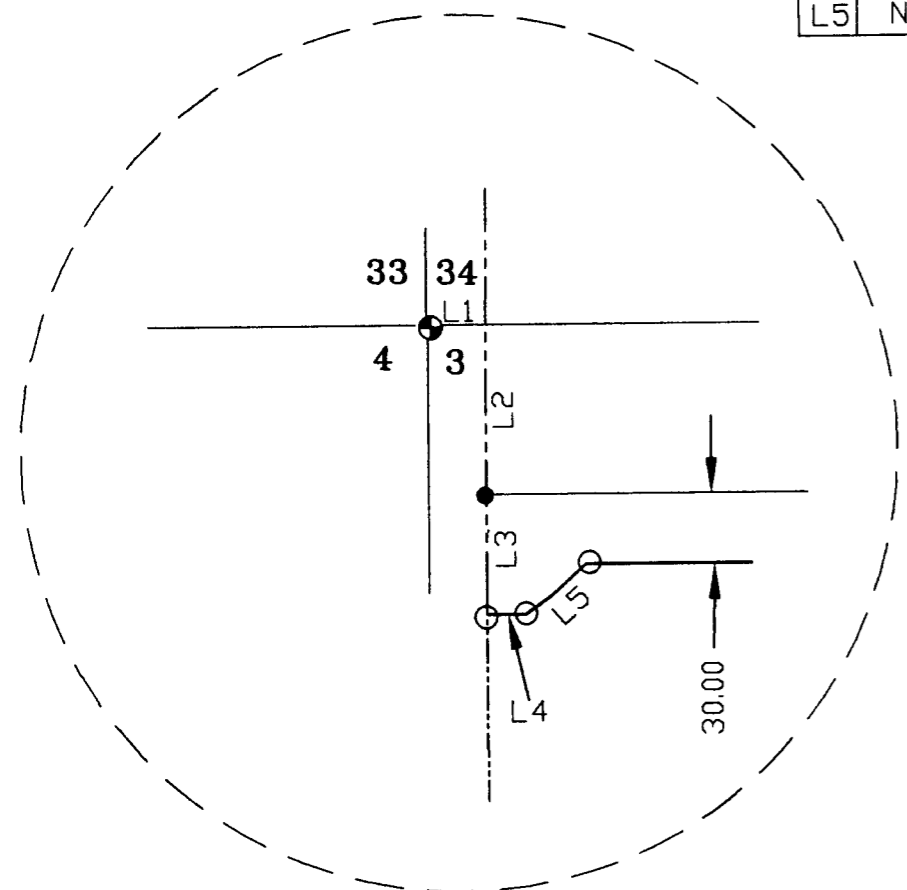

COURSE DATA

PT	BEARING	DISTANCE
L1	N 89°54'37" E	30.00
L2	S 00°28'00" E	65.00
L3	S 00°28'00" E	40.00
L4	N 89°55'26" E	20.00
L5	N 45°00'00" E	14.16

SURVEY NARRATIVE

PURPOSE: To monument the adjusted lines between my client's two tax lots per their request and approved Jackson County Planning file number SUB-2009-00021.

PROCEDURE: Utilizing a Trimble R8 receiver and a Nikon DTM 522 total station, I tied monuments set and found on filed survey number 12552 and Section and Quarter corners, as shown. I set monuments along the newly adjusted property line as requested by my client and as approved by Jackson County Planning file number SUB-2009-00021.

The exterior boundaries were not surveyed.

LEGEND

- SET 5/8" X 30" REBAR WITH PLASTIC CAP MARKED 'TEMPLIN LS2359'
- FD. 5/8" IRON ROD WITH PLASTIC CAP PER FS 12552
- ⊕ FD. JACKSON COUNTY MONUMENT PER RE-ESTABLISHMENT
- △ INDICATES CALCULATED POSITION
- < > INDICATES RECORD DATA PER FS 12552
- [] INDICATES RECORD DATA PER FS 3164
- FS INDICATES FILED SURVEY

BASIS OF BEARING: WEST LINE OF SECTION 3, PER FILED SURVEY NUMBER 12552

FILE: 'Nature31la.dwg'

****RECEIVED****
 DATE: 7-21-09 BY: *RB*
 This survey consists of:
 1 sheet(s) Map
 0 page(s) Narrative
JACKSON COUNTY SURVEYOR

REGISTERED PROFESSIONAL LAND SURVEYOR
Richard G. Templin
 DREGON JULY 26, 1998
 RICHARD G. TEMPLIN 2359
 MY CERTIFICATE EXPIRES JUNE 30, 2010

RICHARD TEMPLIN LAND SURVEYING
 P.O. BOX 1946 899-2032 JACKSONVILLE, OREGON

MAP OF SURVEY

LOCATED IN SECTION 3, T.36S., R.2 W., W.M. JACKSON COUNTY, OREGON

FOR: Malcolm Beech Investments, LLC.
 11161 Table Rock Road Central Point, Or. 97502 DATE: July 7, 2009