

JACKSONVILLE HWY. (OREGON STATE HIGHWAY NO. 238)

FD. 1 1/2" I. PIPE

S 87° 59' 40" E 240.12'  
180.09' (REC. S 89° 47' 00" E 178.88')

FD. 1 BOLT  
N.W. COR.  
LOT 6

60.00'

N 0° 05' 55" E 298.71'

CLOVER LANE (PUBLIC ROAD)

N 0° 05' 55" E 296.36' (REC. N 0° 06' 00" W 298.31')

10' EASEMENT  
S 0° 05' 55" W 289.32' (REC. S 0° 08' 00" E 296.18')  
W/L O. HARBAUGH'S SUBDIVISION

O. HARBAUGH'S SUBDIVISION LOT 6

60.00'


S 89° 45' 55" W 179.99'  
(REC. S 89° 32' 00" W 169.09')

SOUTH 1783.75'

FD. 1" I. PIPE  
S.W. COR. LOT 6

WEST 1783.75'

S.W. COR. D.L.C. NO. 76  
T. 37 S., R. 2 W., W.M.  
FD. STONE W/CROSS

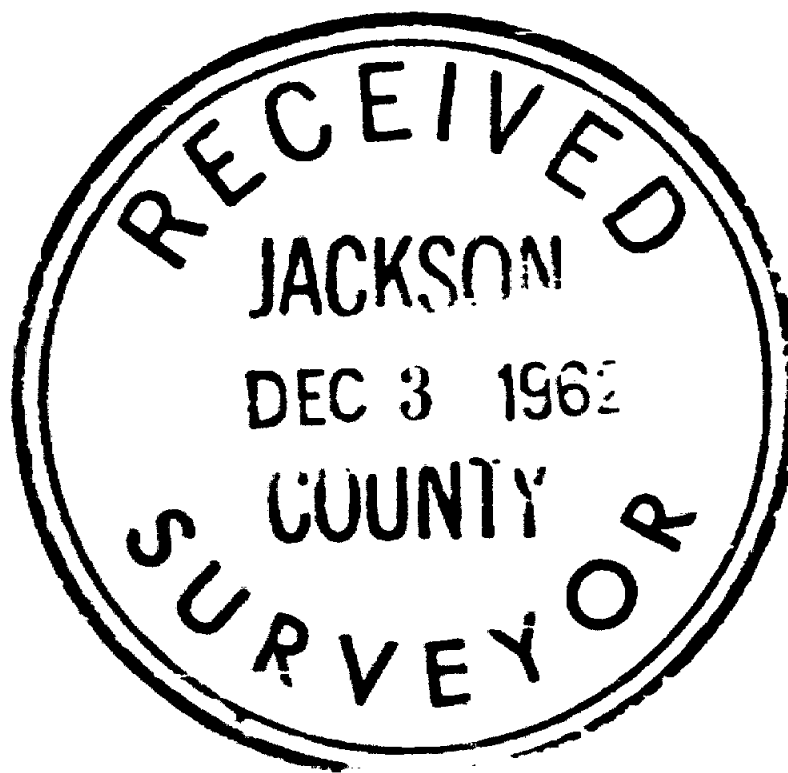

BOUNDARY SURVEY OF PROPERTY  
SITUATE IN  
D.L.C. NO. 76 T. 37 S., R. 2 W., W.M.  
JACKSON COUNTY, OREGON  
FOR  
ERNEST R. & RUTH KENNEDY  
L.P. LOVEJOY L.S. MEDFORD ORE  
SCALE: 1" = 50' 10-29-62  
BEARINGS BY PREVIOUS SURVEY  
O = SET 5/8" IRON PIN

REGISTERED  
OREGON  
LAND SURVEYOR

*Leland P. Lovejoy*

NOVEMBER 18, 1949  
LELAND P. LOVEJOY  
262

2053

Survey Narrative to Comply with Section 87-3301947 Oregon State Laws

Survey for: Ernest R. and Ruth Kennedy  
1432 East Main Street  
Medford, Oregon

Purpose of Survey: To establish property boundaries.

Survey Location: D. L. C. No. 76, Township 37  
South, Range 2 West, Willamette  
Meridian, Jackson County, Oregon.

Survey Procedure: Found southwest corner D. L. C.  
No. 76 and other survey corners  
and points as shown on map and  
used as basis for survey control.  
Set 5/8" iron pins as shown.

Leland P. Lovejoy  
Registered Land Surveyor

Work completed October 31, 1962

