

20596

REMONUMENTATION SURVEY NARRATIVE

REPLACEMENT OF DESTROYED SURVEY MONUMENTS, PER RECOVERY SURVEY,
FILED AS SURVEY NUMBER 20535, BY THIS OFFICE.

ALONG HALE WAY, (WHITE CITY) JACKSON COUNTY, OREGON

SE 1/4 SEC 17 T36S R1W WM
NE 1/4 SEC 20 T36S R1W WM

* * RECEIVED * *

DATE 1-28-10 BY SB

This survey consists of:
0 sheet(s) Map
1 page(s) Narrative

JACKSON COUNTY
SURVEYOR

THIS SURVEY WAS MADE AT THE REQUEST OF JACKSON COUNTY AND THE OREGON DEPARTMENT OF TRANSPORTATION (ODOT), IN SUPPORT OF A RESURFACING PROJECT FOR JACKSON COUNTY, OREGON, LOCATED IN WHITE CITY.

THE PURPOSE OF THIS SURVEY IS TO RE-ESTABLISH THE LOCATION OF TEN FOUND MONUMENTS DESTROYED BY ROAD CONSTRUCTION ALONG HALE WAY. UTILIZING THE CONTROL AND RECOVERED MONUMENT POSITIONS PER FILED SURVEY NUMBER 20535, THE DESTROYED MONUMENTS WERE RESET AS DESCRIBED BELOW.

THE SURVEY EQUIPMENT CONSISTED OF ONE TRIMBLE R8 GPS RECIEVER AND ONE TRIMBLE TSC2 DATA COLLECTOR.


THIS SURVEY WAS PERFORMED ON JANUARY 15, 2010.

#1004 - RESET MAG NAIL AND WASHER AS FOUND AT ORIGINAL LOCATION.

#S 1007, 1009, 1011, 1014, 1020, 1024, 1027, 1028 AND 1029 WERE REPLACED WITH THE 3-1/4" BRASS CAP AS SEEN IN THE DETAIL BELOW. CAP IS SET FLUSH WITH SURFACE IN CONCRETE.

ALL OTHER FOUND CONCRETE NAILS WERE NOT RESET DURING THIS SURVEY, NO ORIGINAL RECORD OF THESE NAILS WAS EVER FOUND.

SET MONUMENT DETAIL
UNLESS NOTED OTHERWISE
3-1/4" BRASS CAP MARKED

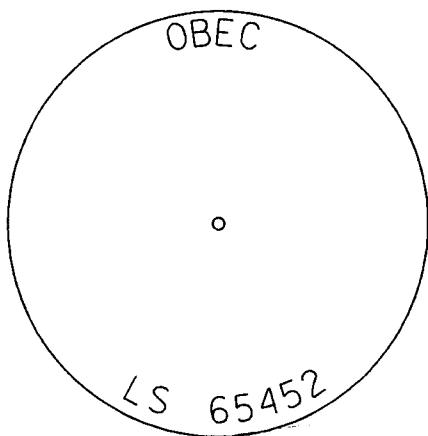

REGISTERED
PROFESSIONAL
LAND SURVEYOR

[Signature]

OREGON
JULY 12, 2005
LOGAN MILES
65452

RENEWAL: DEC. 31, 2010

ODOT REGION 3
KEY NO. 16479
JOB NO. 19-84.46
JACKSON COUNTY
(WHITE CITY)



Corporate Office: 920 COUNTRY CLUB ROAD, SUITE 100B EUGENE, OREGON 97401-6089, 541-683-6090
 2235 MISSION STREET SE, SUITE 100 SALEM, OREGON 97302-1295, 503-589-4100
 831 O'HARE PARKWAY MEDFORD, OREGON 97504-4005, 541-774-5590
 5005 SW MEADOWS ROAD, SUITE 120 LAKE OSWEGO, OREGON 97035, 503-620-6103

JANUARY, 2010

SHEET 1 OF 1

20596