

MAP OF SURVEY

Property Line Adjustment
 Located in
 South Half of Section 35, T36S, R1W, W.M.
 and
 Section 2, T37S, R1W, W.M.
 Jackson County, Oregon
 for

Dry Creek Landfill Inc.
 Oakleaf Properties LLC
 8001 Table Rock Road
 Central Point, OR. 97502

Pacificorp
 825 Multnomah St.
 Portland, OR. 97232

April 2010

AGENT: CSA Planning, Ltd.
 4497 Brownridge, Ste. 101
 Medford, OR. 97504

SURVEYOR: Richard L. Bath, PLS No. 1069
 Hardey Engineering & Assoc., Inc.
 P.O. Box 1625
 2870 Nansen Drive
 Medford, OR. 97501-0124

APPROVAL:

Examined and approved by the Jackson County
 Development Services this 4th day of May, 2010.

Re: SUB 2008-00060 SUB 2010-00009
 -00065 -00010
 -00066
 -00089
 -00090
 -00091



Richard L. Bath
 County Planner

NARRATIVE:

Purpose: To survey, describe, and map the new property line shown herein as approved by six Jackson County files: SUB 2008-00060, 00065, 00066, 00089, 00090, & 00091, SUB 2010-00009 & 00010




Procedure: Located and tied in all Government corners shown herein. The new property line for this project was to be at least 500' easterly of the transmission centerline. The plat for ELEVEN-EIGHTY ORCHARD TRACT, recorded in 1910, was analyzed and found not to close mathematically for a number of reasons. The lot lines for the Tracts herein were determined by proration and are approximate only. Legal descriptions were then developed to properly describe the location of the new adjusted boundary. Witness monuments were set along the new adjusted boundary to honor the uncertain locations of the prorated lot lines.

Basis of Bearings: Perpetuated the Dry Creek Landfill Network (created prior to 2002) by another firm. The Dry Creek Network can be rotated 0°23'48" clockwise to True North by GPS observations.

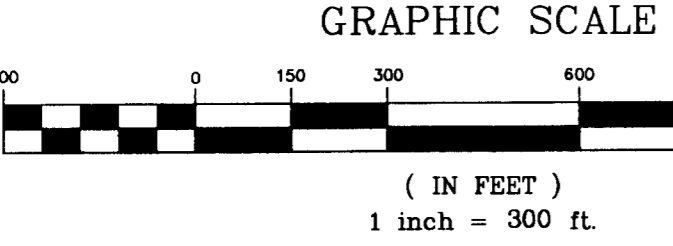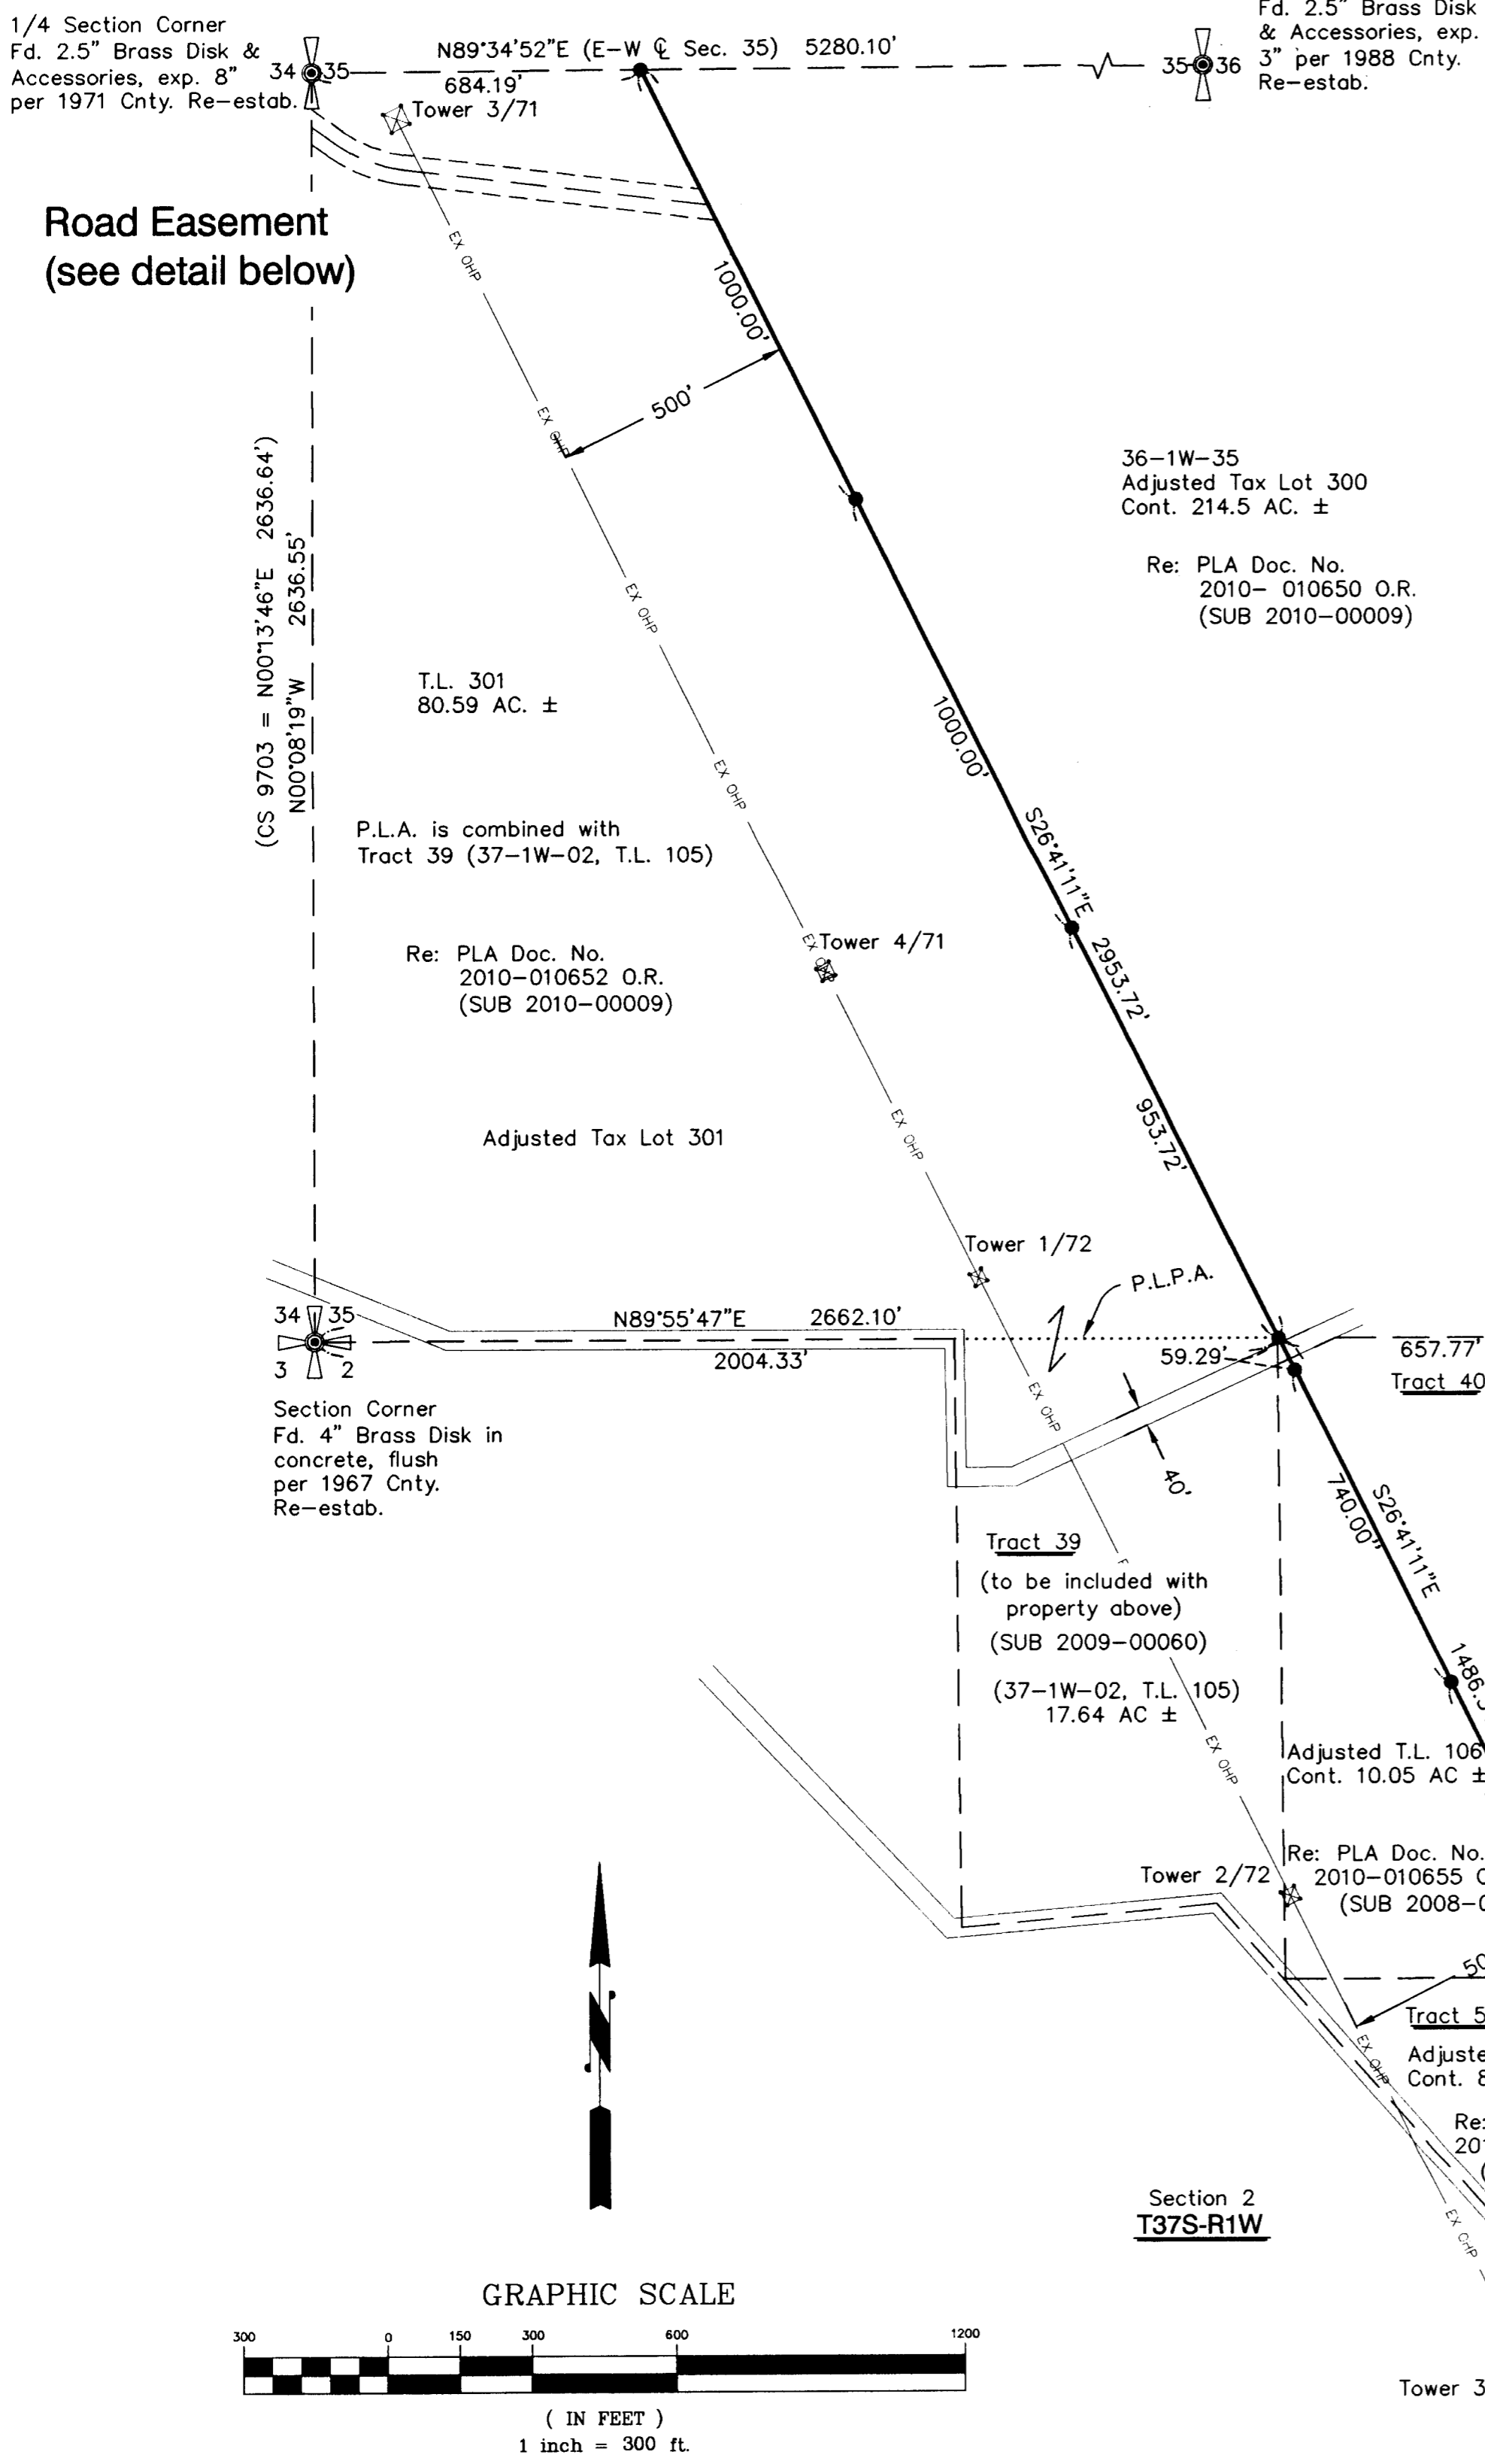

LEGEND

- = Found Brass Disk Monument as noted
- = Set 5/8" x .24" rebar w/orange plastic cap stamped "HARDEY ENG. & ASSOC."
- (N21°13'56"W 712') = Record measurement per CS 12373
- P.L.P.A. = Property Line Prior to Adjustment
- P.L.A. = Property Line Adjustment
- Doc. = Document
- C.S. = County Surveyor's number of filed survey
- Cont. = Containing

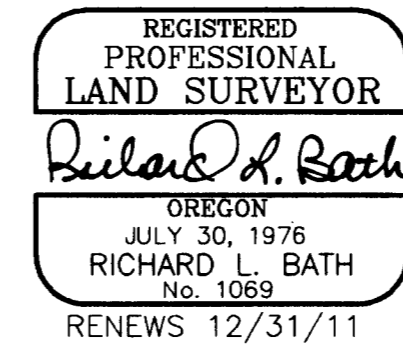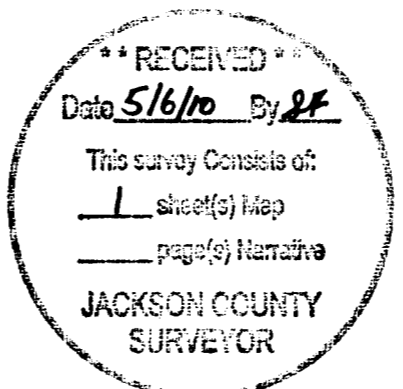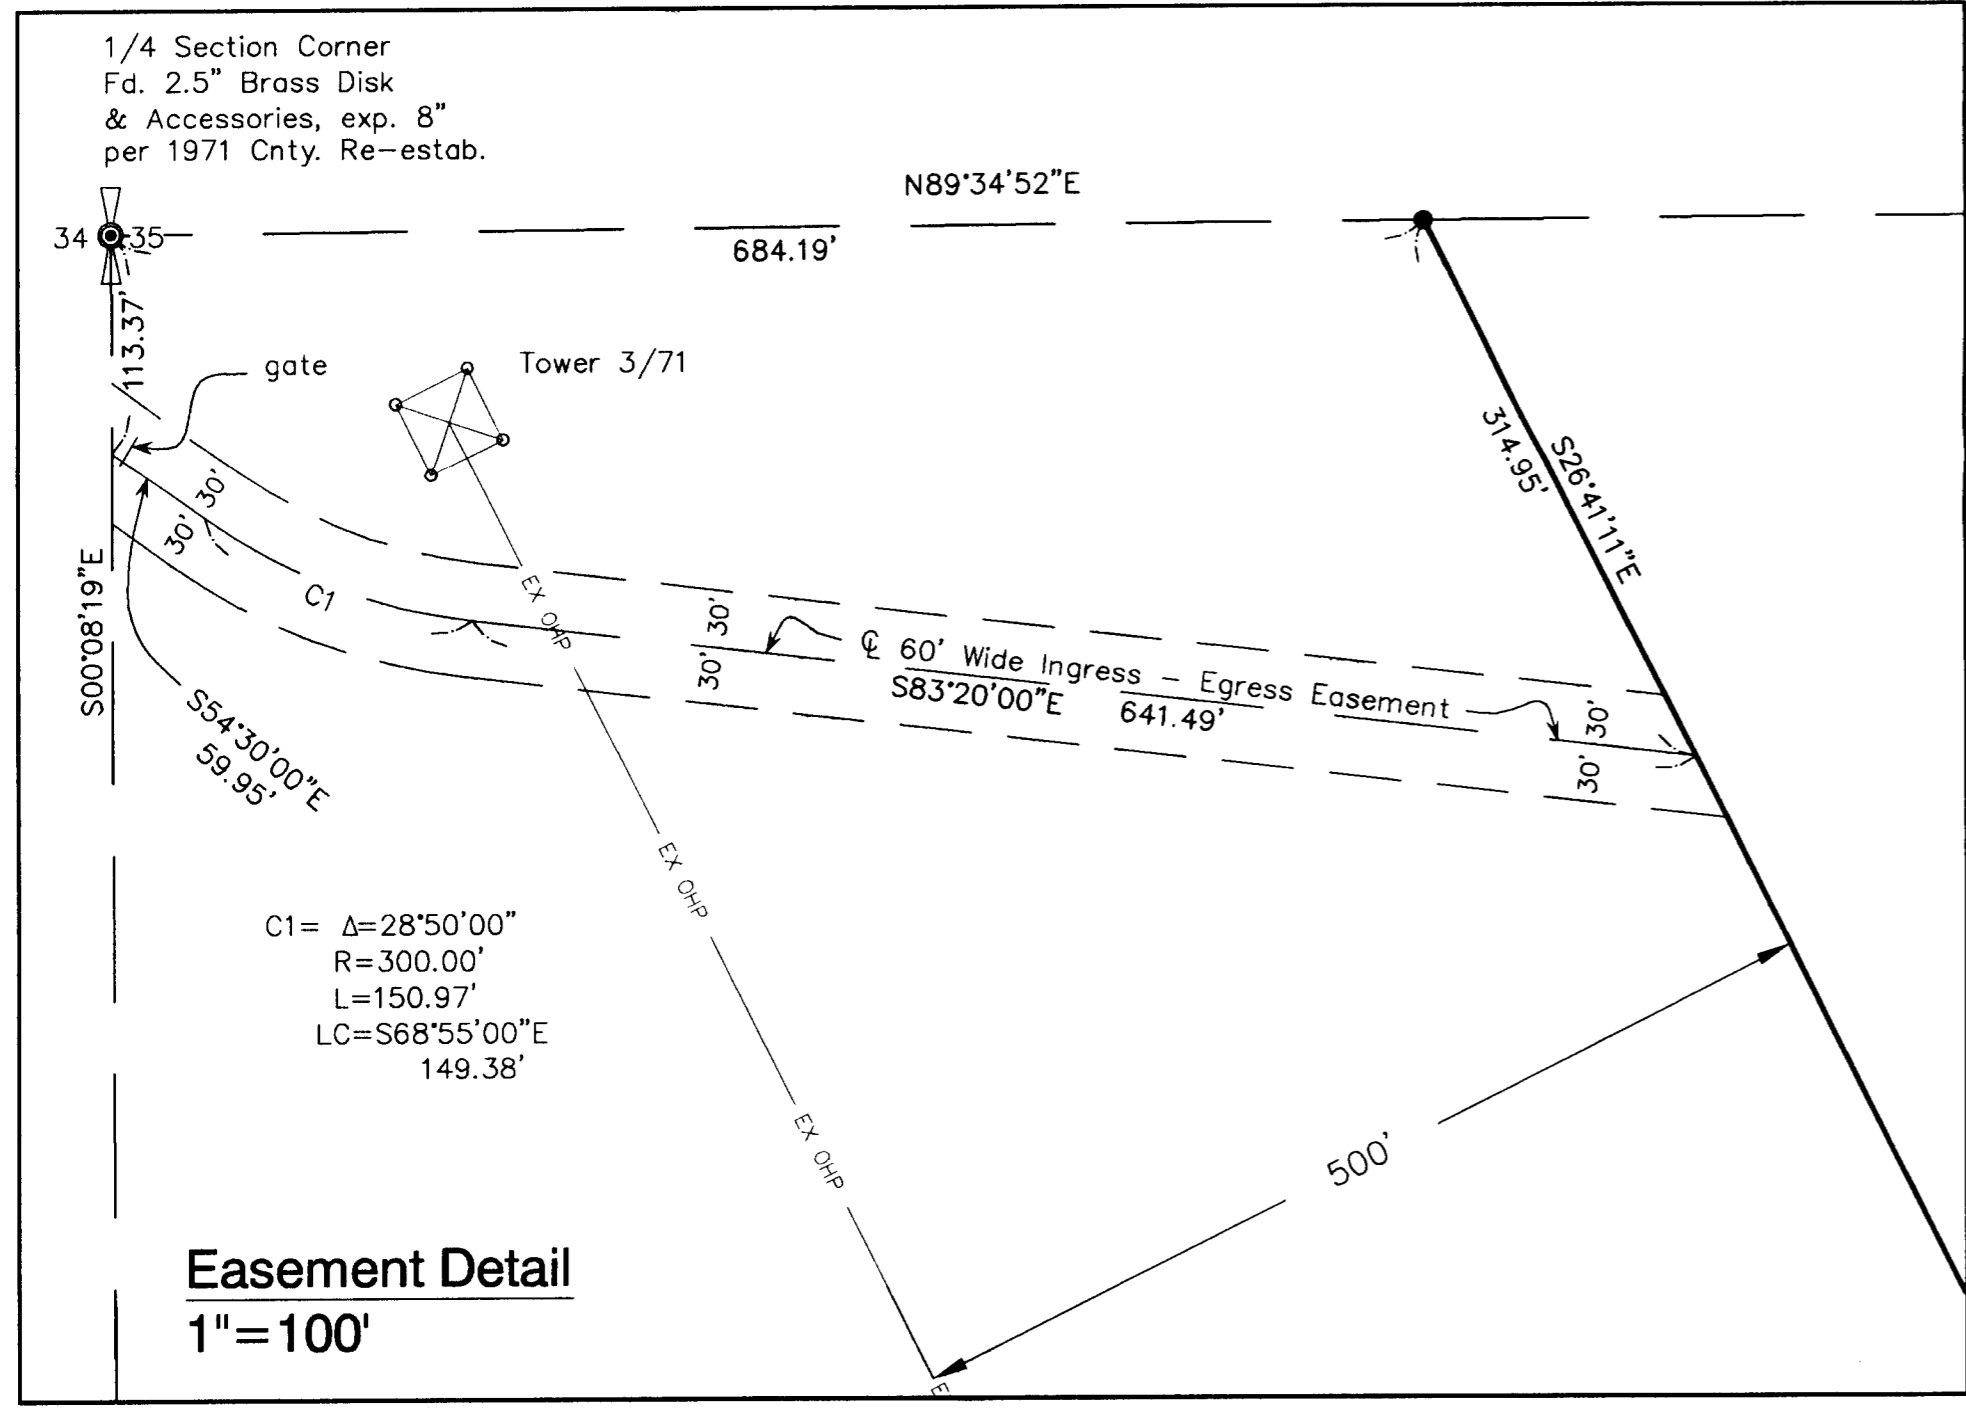

Hardey Engineering & Associates, Inc.

P.O. BOX 1625
 MEDFORD, OREGON 97501-0063
 VOICE: 541-772-6880
 FAX: 541-772-9573
 EMAIL: info@hea-inc.com

36-1W-35, T.L. 300
 37-1W-02, T.L.'S 105,106,107,117,118,121,122,123 & 200