

Corner References


South-South One-Sixty Fourth Corner
Sections 35 and 36
SE Cor DLC 55 Bears N1°59'30"E, 99.48'

South One-Sixteenth Corner
Sections 35 and 36
5/8"x24" Iron Pin w/Yellow Plastic Cap Marked:
"CENTER+LS 1071" Bears N0°21'57"E, 25.00'
5/8"x24" Iron Pin w/Yellow Plastic Cap Marked:
"CENTER+LS 1071" Bears S1°18'36"E, 23.72'

Center-South One-Sixteenth Corner
12" Dia. White Oak N86°04'E, 11.20'
Scribed CS1/16-BT
15" Dia. White Oak N36°08'W, 9.80'
Scribed X-BT

South-West One-Sixteenth Corner
8" Dia. White Oak S51°17'E, 31.24'
Scribed X-BT
6" Dia. White Oak N7°30'W, 28.00'
Scribed SW1/16-BT

MAP OF SURVEY
FOR
BUDGET TRUCK STOP
PROFIT SHARING AND MONEY PURCHASE
PENSION PLAN
GARY D. HALL AND LINDA C. HALL, TRUSTEE
2391 TERRI DRIVE
MEDFORD, OR 97504
SITUATED IN
SECTION 36, T.37S., R.1W., W.M.
JACKSON COUNTY, OREGON
JUNE 28, 2010

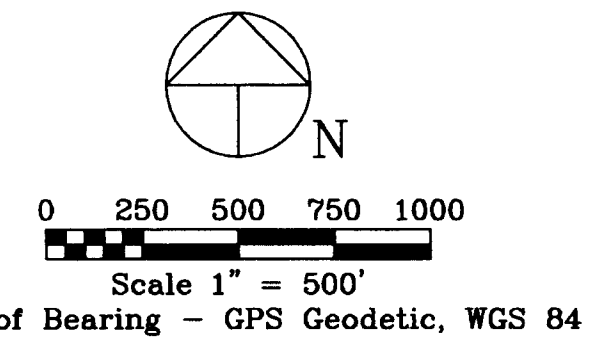

- LEGEND**
- Found Jackson County Surveyor Monument and Accessories
 - Found 1" Dia. x 30" Long Galvanized Iron Post w/1-1/2" Dia. Metal Cap Marked: "CENTER + LS 1071"
 - Set 1" Dia. x 30" Long Galvanized Iron Post w/1-1/2" Dia. Metal Cap Marked: "CENTER + LS 1071". See "Corner References" For Accessories To Corner
 - △ Computed Point, No Monument Set
 - SN Filed Survey Reference Number
 - () Denotes GLO/DLC Survey Record
 - [] SN 5243, SN 5461 Record
 - { } SN 19253 Record
 - Denotes Fence Line

Survey Narrative To Comply With Paragraph 209.250 Oregon Revised Statutes

Purpose: To survey and monument the boundary of the lands described within Deed Document 2009-003001.

Procedure: Recovered previously established monuments and survey control from filed survey No. 19253. From this data I performed a traverse survey and established the corner points as shown.

Equipment Utilized This Survey: Nikon DTM 420 Electronic Total Station and related equipment.

****RECEIVED****
Date 7-6-11 By HS
This Survey Consists of:
1 sheet(s) Map
2 page(s) Narrative
JACKSON COUNTY
SURVEYOR

REGISTERED
PROFESSIONAL
LAND SURVEYOR
Harold L. Center
OREGON
JULY 30, 1976
HAROLD L. CENTER
1071
Expires: 12/31/11

SURVEYOR
HAROLD L. CENTER
2604 David Lane
Medford, OR 97504
Phone 541-535-6108
Oregon Certificate No. 1071
Cert. Renewal Date: 12/31/11

Project 10-7 (GDHALL)
37 1W 36 400