


2072

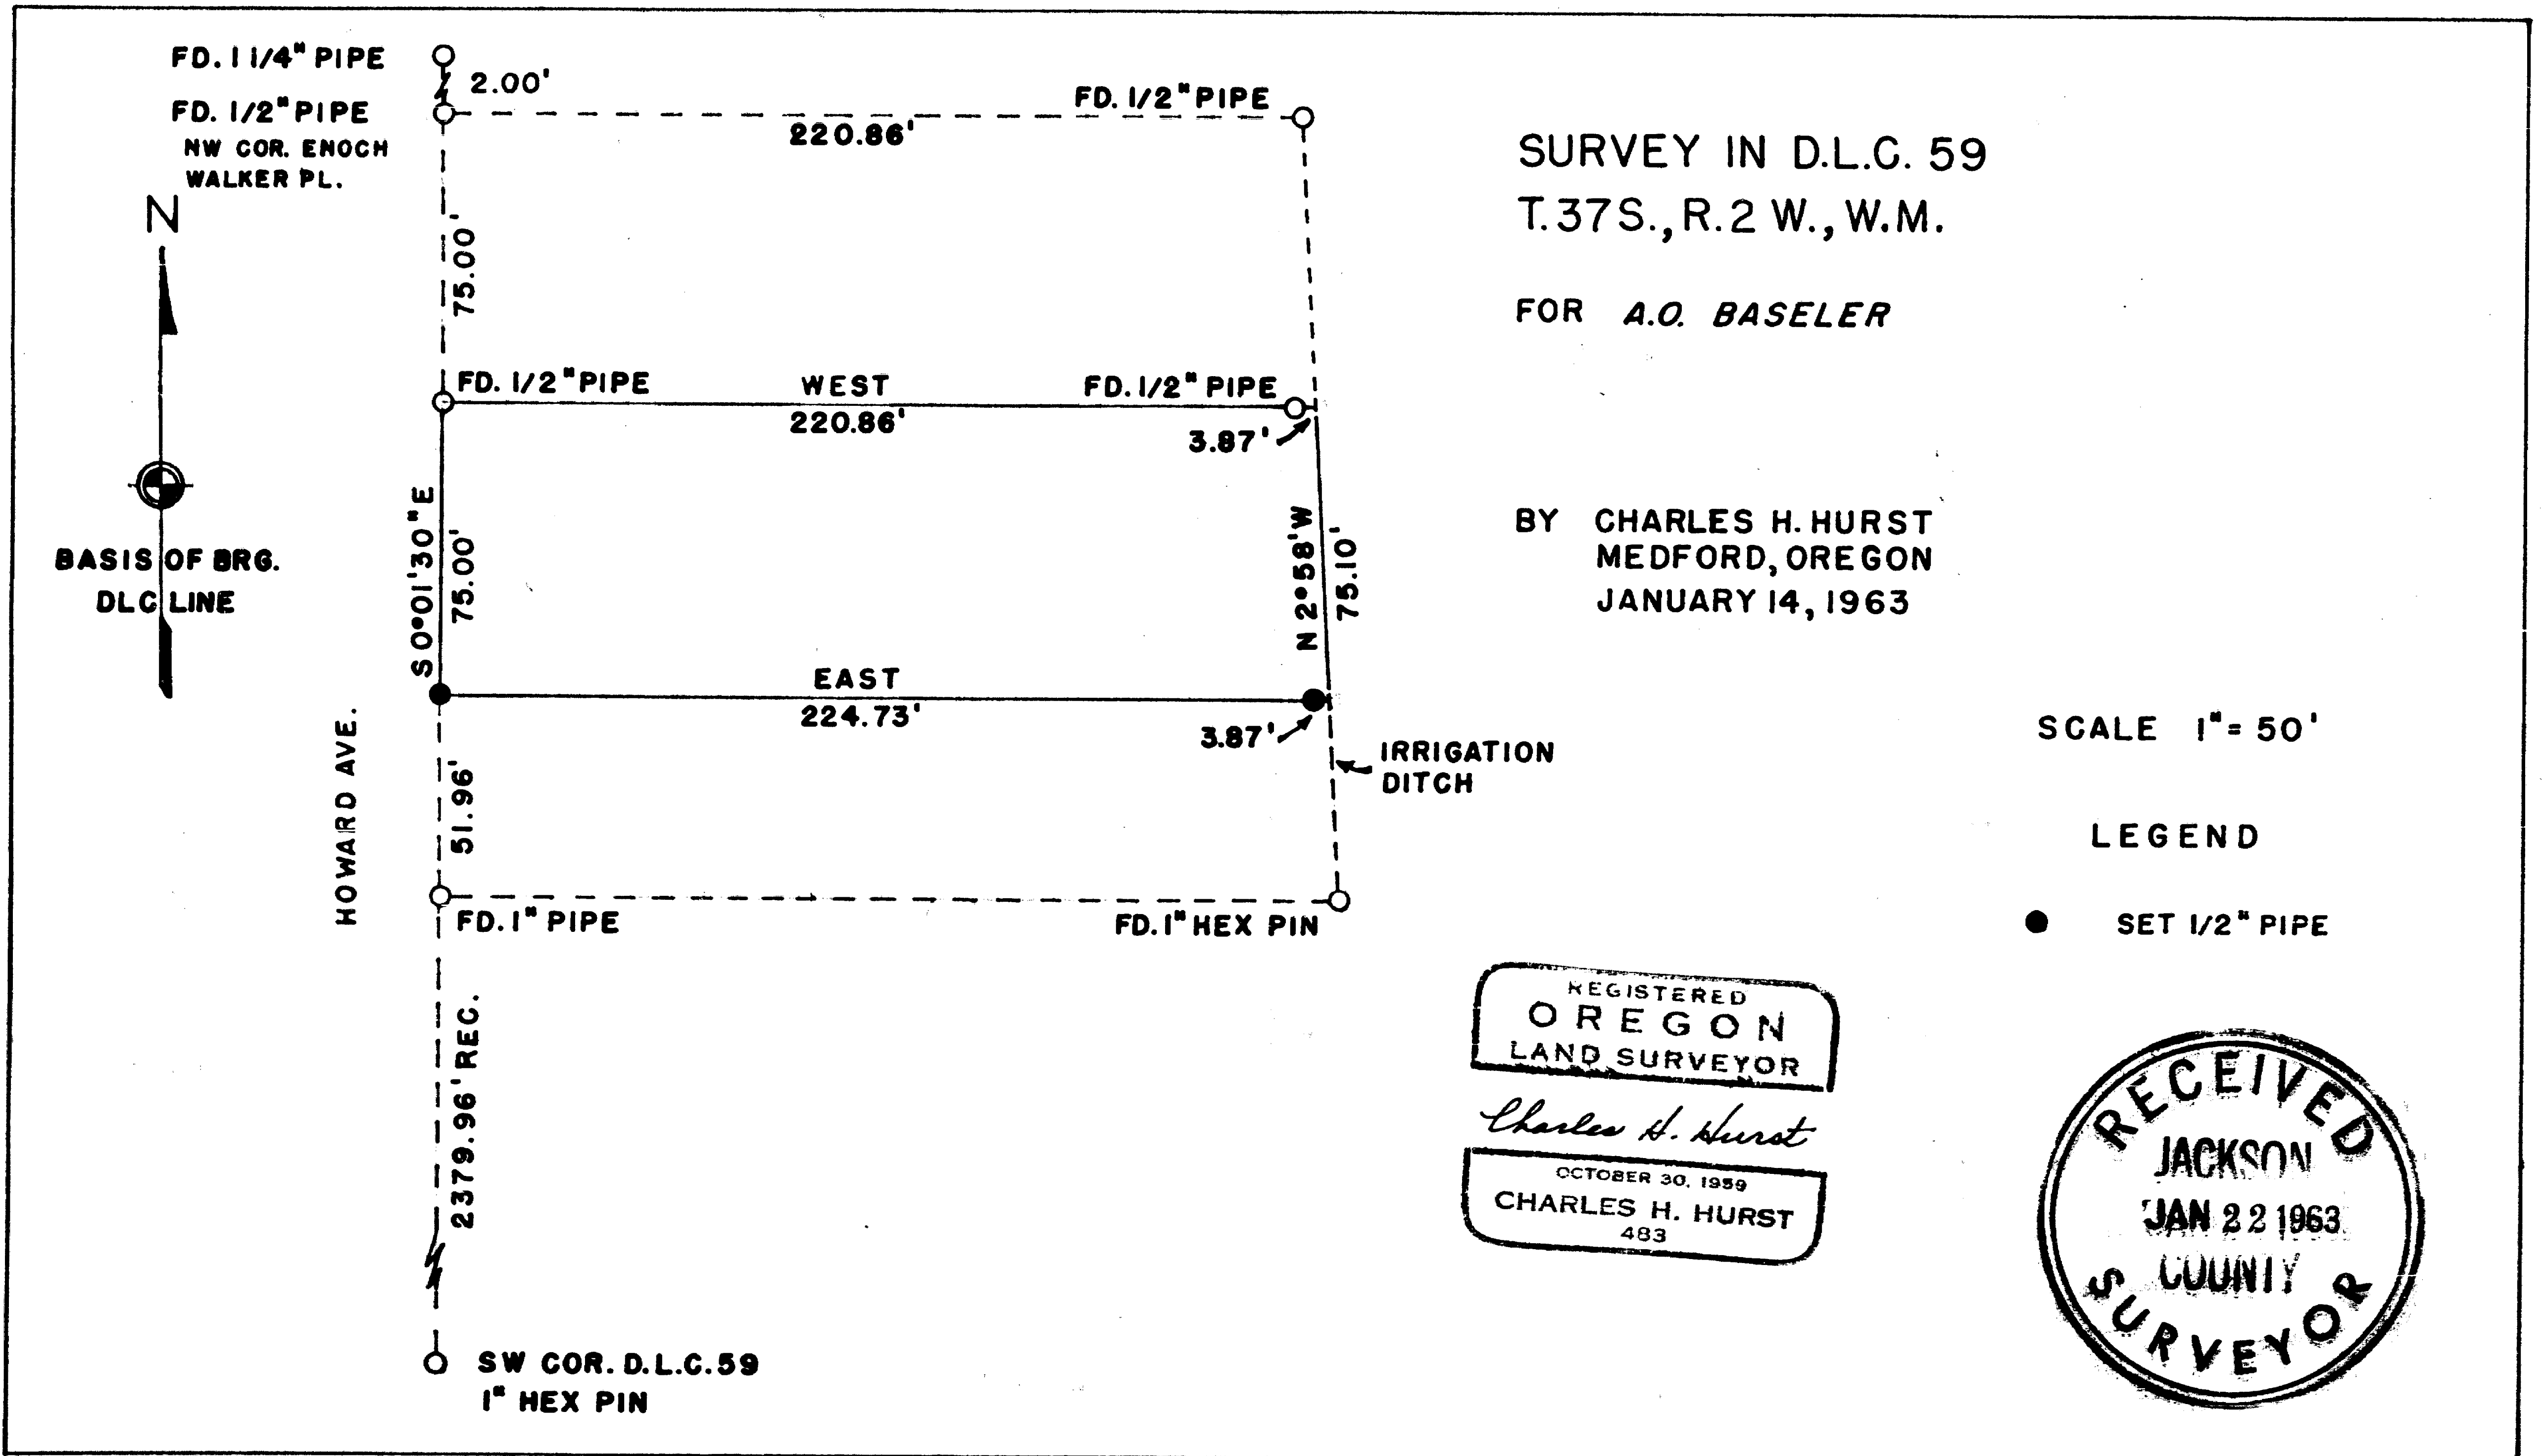

2072

Survey No. 2072

Survey narrative to comply with ORS 209.120 and 209.250

Survey for: A.O. Baseler
2882 Howard Ave.
Medford, Oregon

Survey by : Charles H. Hurst
765 Sunrise Ave.
Medford, Oregon

Basis of bearing: West boundary DLC 59 (Record)

Precedence of survey: To separate the tract of land shown for
the purpose of sale.

Reference is made to the survey of January 14, 1961
performed for the same client adjacent to the tract shown.
Said survey is recorded in the office of the County
Surveyor, Jackson County.

Charles H. Hurst
January 14, 1963

