
ASSESSOR'S MAP NO.: 36-3W-28 TL 605

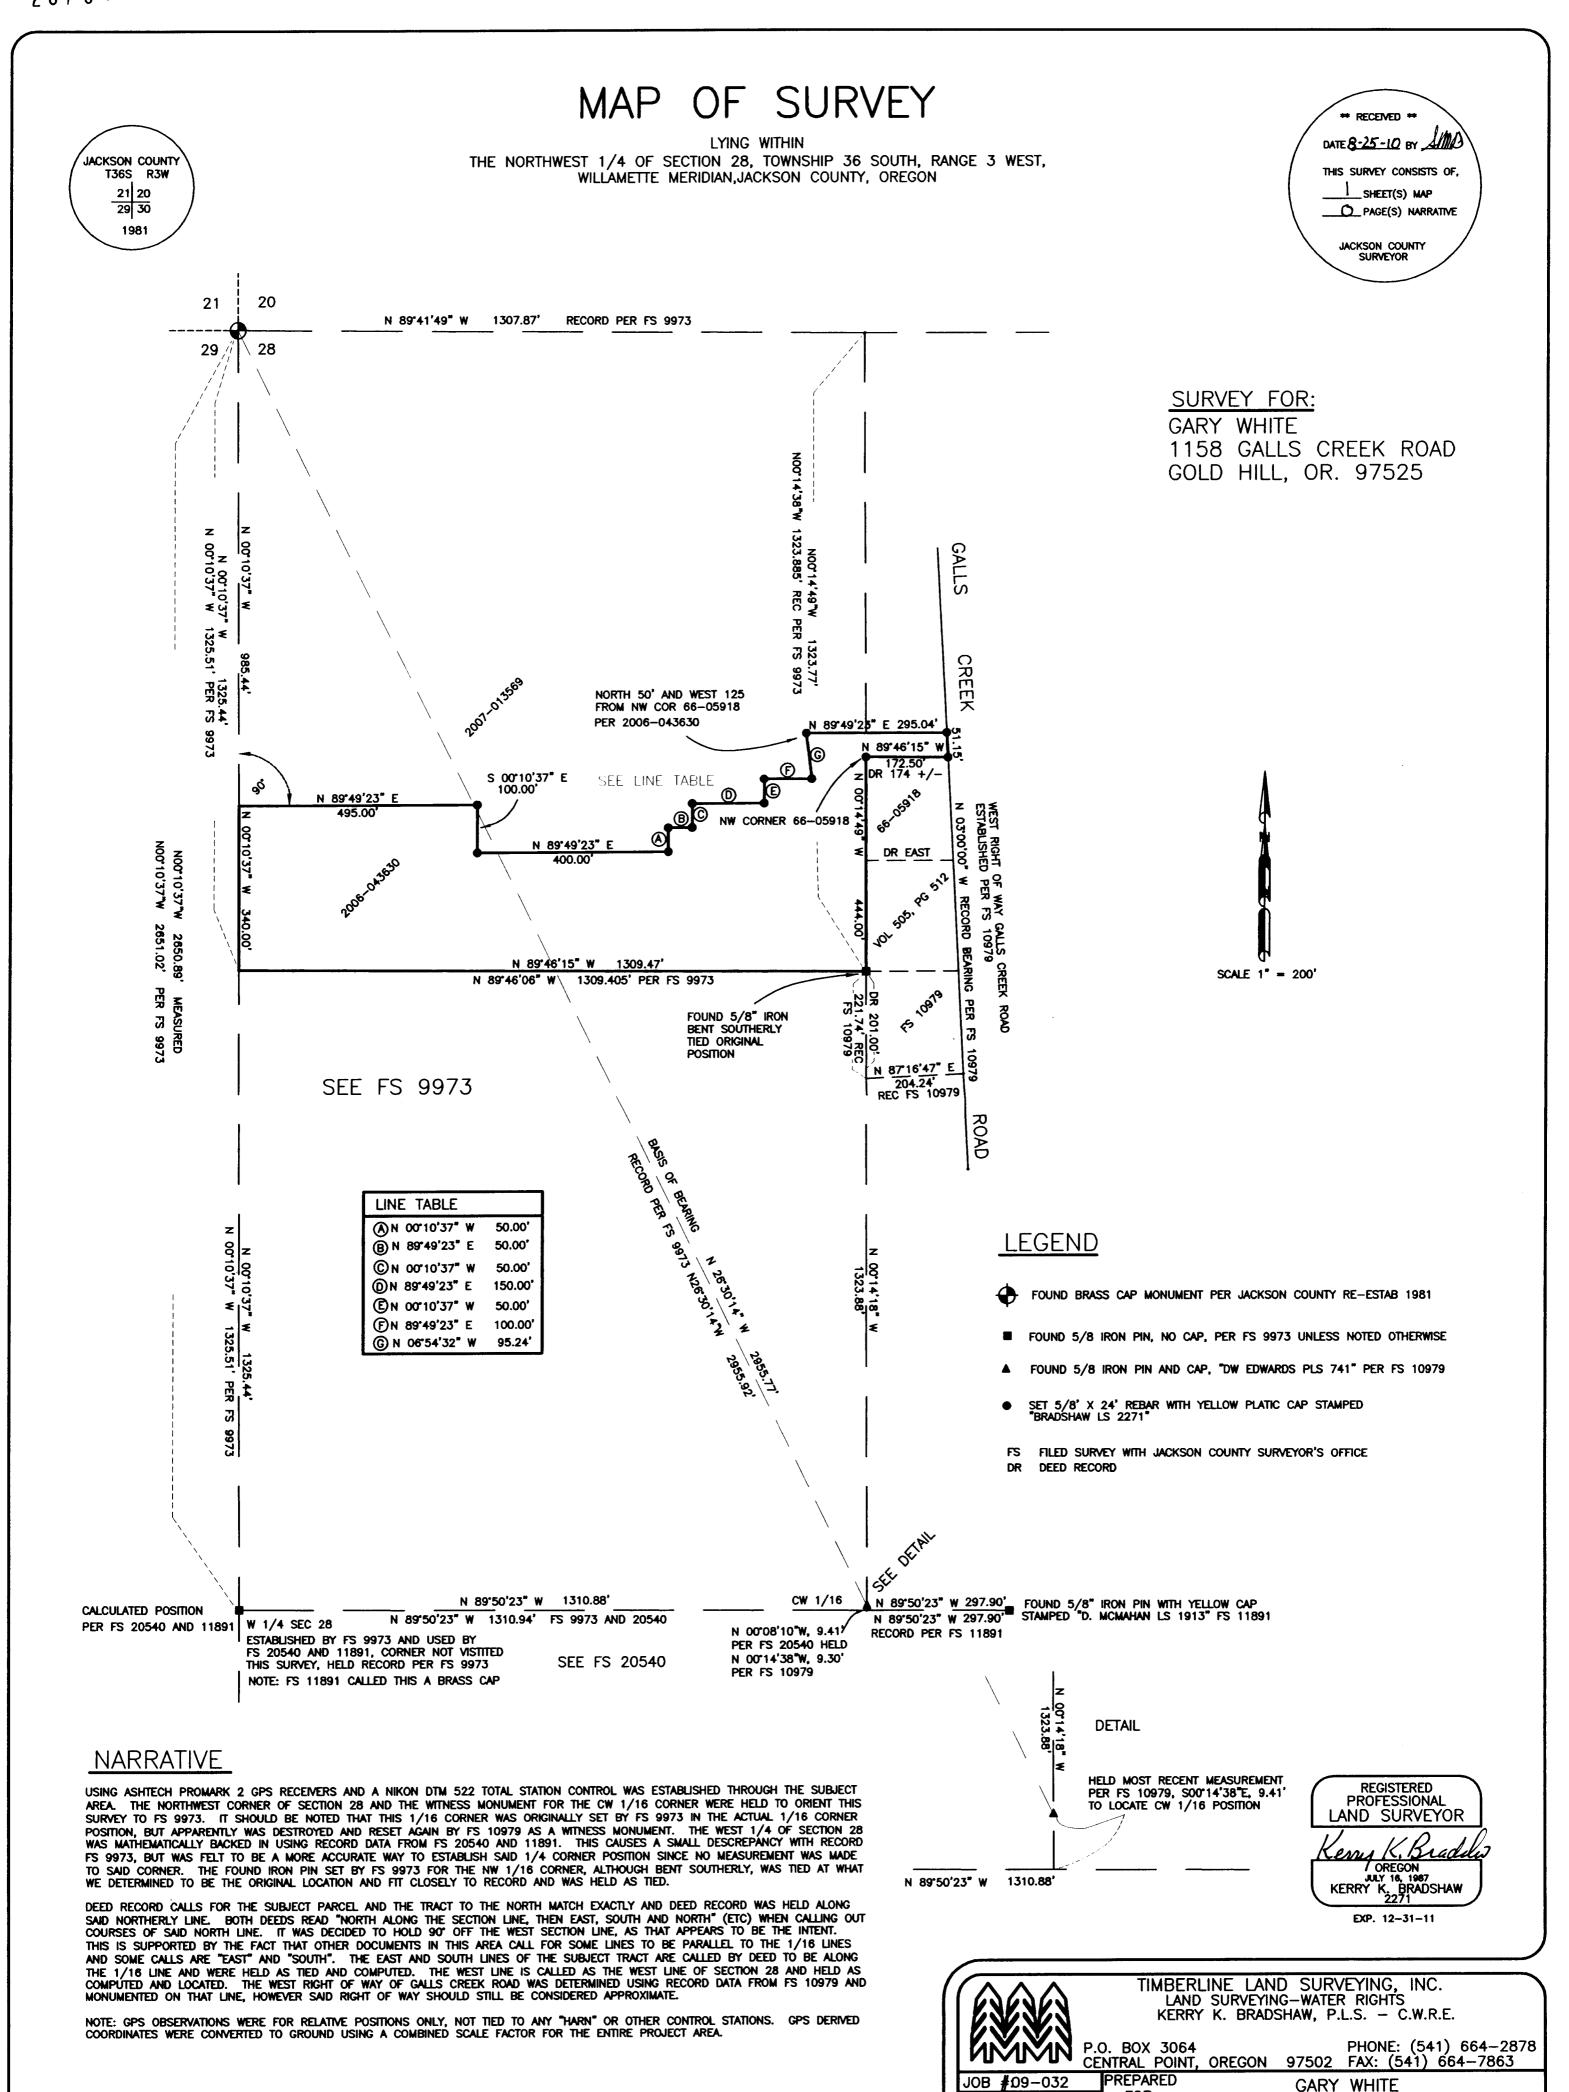

SHEET 1 OF 1

1158 GALLS CREEK ROAD GOLD HILL, OR. 97525

FOR:

FILE NAME: WORK/PROJECTS/2000/00-032 GARY WHITE

DATE: 2/15/2010

DRAWN BY: KKB