

PROPERTY LINE ADJUSTMENT
 LOCATED IN
 SOUTHWEST QUARTER SECTION 9, WEST HALF AND THE
 NORTHWEST QUARTER OF THE NORTHEAST QUARTER
 OF SECTION 16
 T.35S., R.1E., W.M.
 JACKSON COUNTY, OREGON
 FOR
 JOHN A. DUKE TRUST
 JOHN A. DUKE AND MARILYN R. DUKE, TRUSTEES
 P.O. BOX 430, ROGUE RIVER, OR 97537

Survey Narrative To Comply With Paragraph 209.250
 Oregon Revised Statutes


Purpose: To survey and monument the adjusted property line according to clients direction and approved planning action by the Jackson County Development Services, Reference File No. SUB 2009-00065.

Recovered previously established monuments and established new corner monuments as shown.

Equipment Utilized This Survey: Nikon DTM 420 Electronic Total Station and related equipment.

APPROVAL

Jackson County Development Services
 Approval *Jencia* Date *6-17-2010*
 Jackson County Planning Director
 Planning Action File No. SUB 2009-00065

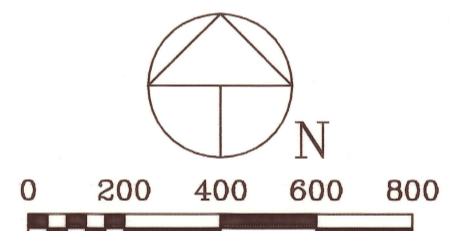

Basis of Bearings - Geodetic North - WGS-84 Datum
 Distances Shown Are Terrestrial Ground

LEGEND

- Found Jackson County Surveyor Monument
- ⊙ Found Monument Established By A.R. Rambo, P.L.S. No. 1086, Reference Filed Survey No. 11233
- Set 5/8" Dia., 24" Long Iron Pin With Metal Cap Marked: "CENTER + LS 1071"
- ⦿ Set 5/8" Dia., 24" Long Iron Pin With Metal Cap Marked: "CENTER WIT. + COR. LS 1071"
- Denotes Previous Lot Line
- △ Computed Point - No Monument Set
- [] Denotes G.L.O. Survey Record
- () Denotes Filed Survey No. 11233 Record Data
- (()) BLM Easement Survey No. OR 54451PT-(Duke)

****RECEIVED****
 Date *8-26-10* By *JMC*
 This Survey Consists of:
 1 sheet(s) Map
 0 page(s) Narrative
 JACKSON COUNTY SURVEYOR

****RECEIVED****
 Date _____ By _____
 This survey Consists of:
 _____ sheet(s) Map
 _____ page(s) Narrative
 JACKSON COUNTY SURVEYOR

REGISTERED PROFESSIONAL LAND SURVEYOR

Harold L. Center
 OREGON
 JULY 30, 1976
 HAROLD L. CENTER
 1071

Expires: 12/31/11

SURVEYOR

HAROLD L. CENTER
 2604 David Lane
 Medford, OR 97504
 Phone 541-535-6108
 Oregon Certificate No. 1071
 Cert. Renewal Date: 12/31/11



01524502201200118170010011

I, Christina Walker, County Clerk for Jackson County, Oregon, certify that the instrument identified herein was recorded in the Clerk records.

Christine Walker - County Clerk

No Grantee

20736

AFFIDAVIT OF CORRECTION

I, Harold L. Center, being duly sworn, depose and say that I am the surveyor who surveyed the property as depicted on Survey No. 20736, Jackson County Surveyor Records, Jackson County, Oregon. The following correction is necessary and is as follows:

On the Map of Survey the acreage for Tax Lot 4000 was incorrectly drafted to read 88.3+/- acres. The correct acreage should read 90.3 +/- acres.

HAROLD L. CENTER
Registered Professional Land Surveyor
Oregon Certificate No. 1071
Certificate Renewal Date: is 12/31/2013
2604 David Lane
Medford, Oregon 97504



NOTARY CERTIFICATE

State of Oregon)


ss

County of Jackson)

Subscribed and sworn to before me this 18th day of April 2012

Notary Public for the State of Oregon

Seal

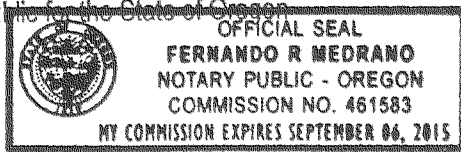

COUNTY SURVEYOR APPROVAL

I, Kerry K. Bradshaw, Jackson County Surveyor, do hereby certify that said Affidavit of Correction for Survey No. 20946 has been examined by me and that it complies with ORS 209.255.

Kerry K. Bradshaw Date 4-18 2012
Kerry K. Bradshaw, Jackson County Surveyor

