

REMONUMENTATION SURVEY NARRATIVE

REPLACEMENT OF DESTROYED SURVEY MONUMENTS, PER RECOVERY SURVEY
FILED AS SURVEY NUMBER 20508, BY THIS OFFICE.
ALONG INTERSTATE 5, JACKSON COUNTY, OREGON

NE 1/4 SEC 33 T36S R2W WM
NW 1/4 SEC 34 T36S R2W WM
SW 1/4 SEC 34 T36S R2W WM
SE 1/4 SEC 34 T36S R2W WM
NE 1/4 SEC 3 T37S R2W WM

* * RECEIVED * *
DATE 11-15-10 BY BB
This survey consists of:
-- 1 -- sheet(s) Map
-- 0 -- page(s) Narrative

JACKSON COUNTY
SURVEYOR

THIS SURVEY WAS MADE AT THE REQUEST OF JACKSON COUNTY AND THE OREGON DEPARTMENT OF TRANSPORTATION (ODOT), IN SUPPORT OF A GREENWAY TRAIL AND BIKE PATH PROJECT FOR JACKSON COUNTY, OREGON.

THE PURPOSE OF THIS SURVEY IS TO RE-ESTABLISH THE LOCATION OF 6 OF THE FOUND MONUMENTS DESTROYED BY PATH AND PARKING LOT CONSTRUCTION. UTILIZING THE CONTROL AND RECOVERED MONUMENT POSITIONS PER FILED SURVEY NUMBER 20508, THE DESTROYED MONUMENTS WERE RESET AS DESCRIBED BELOW.

THE SURVEY EQUIPMENT CONSISTED OF ONE TRIMBLE S6 TOTAL STATION AND ONE TRIMBLE TSC2 DATA COLLECTOR.


THIS SURVEY WAS PERFORMED ON NOVEMBER 1, 2010.

*6 -ORIGINAL NETWORK CONTROL POINT WAS DESTROYED AND NOT RESET.


*S 1002, 1008, 1009, 1010, 1011 AND 1019 WERE REPLACED WITH THE 5/8"X30" IRON ROD AS SEEN IN THE DETAIL BELOW. CAP IS SET FLUSH WITH SURFACE OF THE GROUND.

ALL OTHER FOUND MONUMENTS ON SAID SURVEY NUMBER 20508 WERE FOUND TO BE IN PLACE AS OF THIS POST CONSTRUCTION SURVEY.

SET MONUMENT DETAIL
UNLESS NOTED OTHERWISE
5/8"X30" IRON ROD WITH AN
ORANGE PLASTIC CAP MARKED

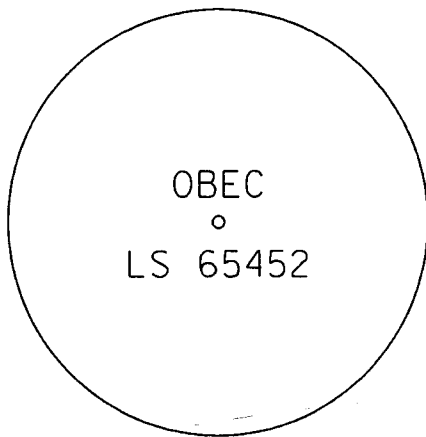

REGISTERED
PROFESSIONAL
LAND SURVEYOR


OREGON
JULY 12, 2005
LOGAN MILES
65452

RENEWAL: DEC. 31, 2010

ODOT REGION 3
KEY NO. 15482
JOB NO. 19-84.86
JACKSON COUNTY



Corporate Office: 920 COUNTRY CLUB ROAD, SUITE 100B EUGENE, OREGON 97401-6089, 541-683-6090
2235 MISSION STREET SE, SUITE 100 SALEM, OREGON 97302-1295, 503-589-4100
831 O'HARE PARKWAY MEDFORD, OREGON 97504-4005, 541-774-5590
5005 SW MEADOWS ROAD, SUITE 120 LAKE OSWEGO, OREGON 97035, 503-620-6103

NOVEMBER, 2010

SHEET 1 OF 1