

Butte Falls, Oregon  
January 18, 1963

County Surveyor  
Jackson County Court House  
Medford, Oregon

Dear Sir;

Please record the following information pertaining to the surveys of the United States Public Lands.

Section 4, T34S, R2E, W.M.


I, Duane A. Smeltzer, on or about 12-62 diligently searched for the South  $\frac{1}{4}$  corner, common to Sections 4&9. Found SW & SE section corners (BTs) and some original blazes near these corners, but could find no evidence in the proximity of the  $\frac{1}{4}$  corner.

Ran transit and chain random line from SW to SE corners to establish South  $\frac{1}{4}$  corner. Set  $\frac{1}{4}$  corner midway between corners on line. Computed section line bearing from sun-shots.

Began South random line at SW corner (2BTs) pipe, ran East to SE corner stone  $\frac{4}{9/3}$  (BTs) and mound of stones.

Bearing of true line (by sun-shots) N4°15'E.

0.0	feet	began ascent along South side hill slope.	
210.0	"	begin descent	
900.0	"	draw; begin ascent	
2600.0	"	" " " to $\frac{1}{4}$ corner	RS
<u>2703.6</u>	"	<u>set <math>\frac{1}{4}</math> corner; top ridge. 2"x4' pipe</u>	461
		Scribed North side----	4
	RS	10" Hemlock N2°E 3.7'	-- $\frac{1}{4}$ --
	461		9
	BT	7" W. Fir S71°E 32.3'	
3200.0	"	draw; side hill, South slope	
4600.0	"	" ascend to flat ridge top	
5250.0	"	" " " Section Corner	
5407.1	"	SE corner stone (BTs)	

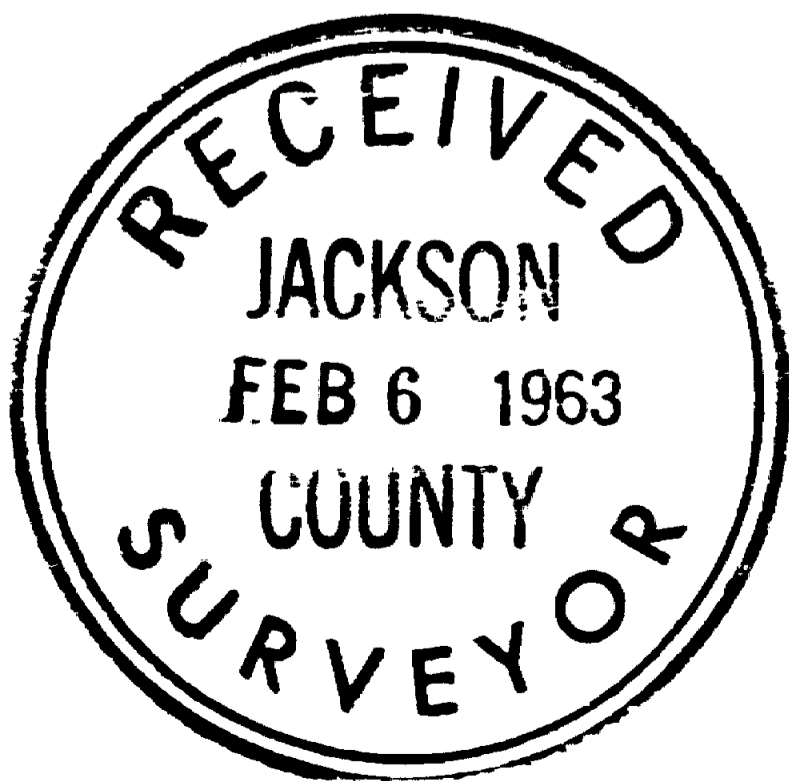

*Duane A. Smeltzer*

