
38-3W-12 TL'S 1700 & 1702

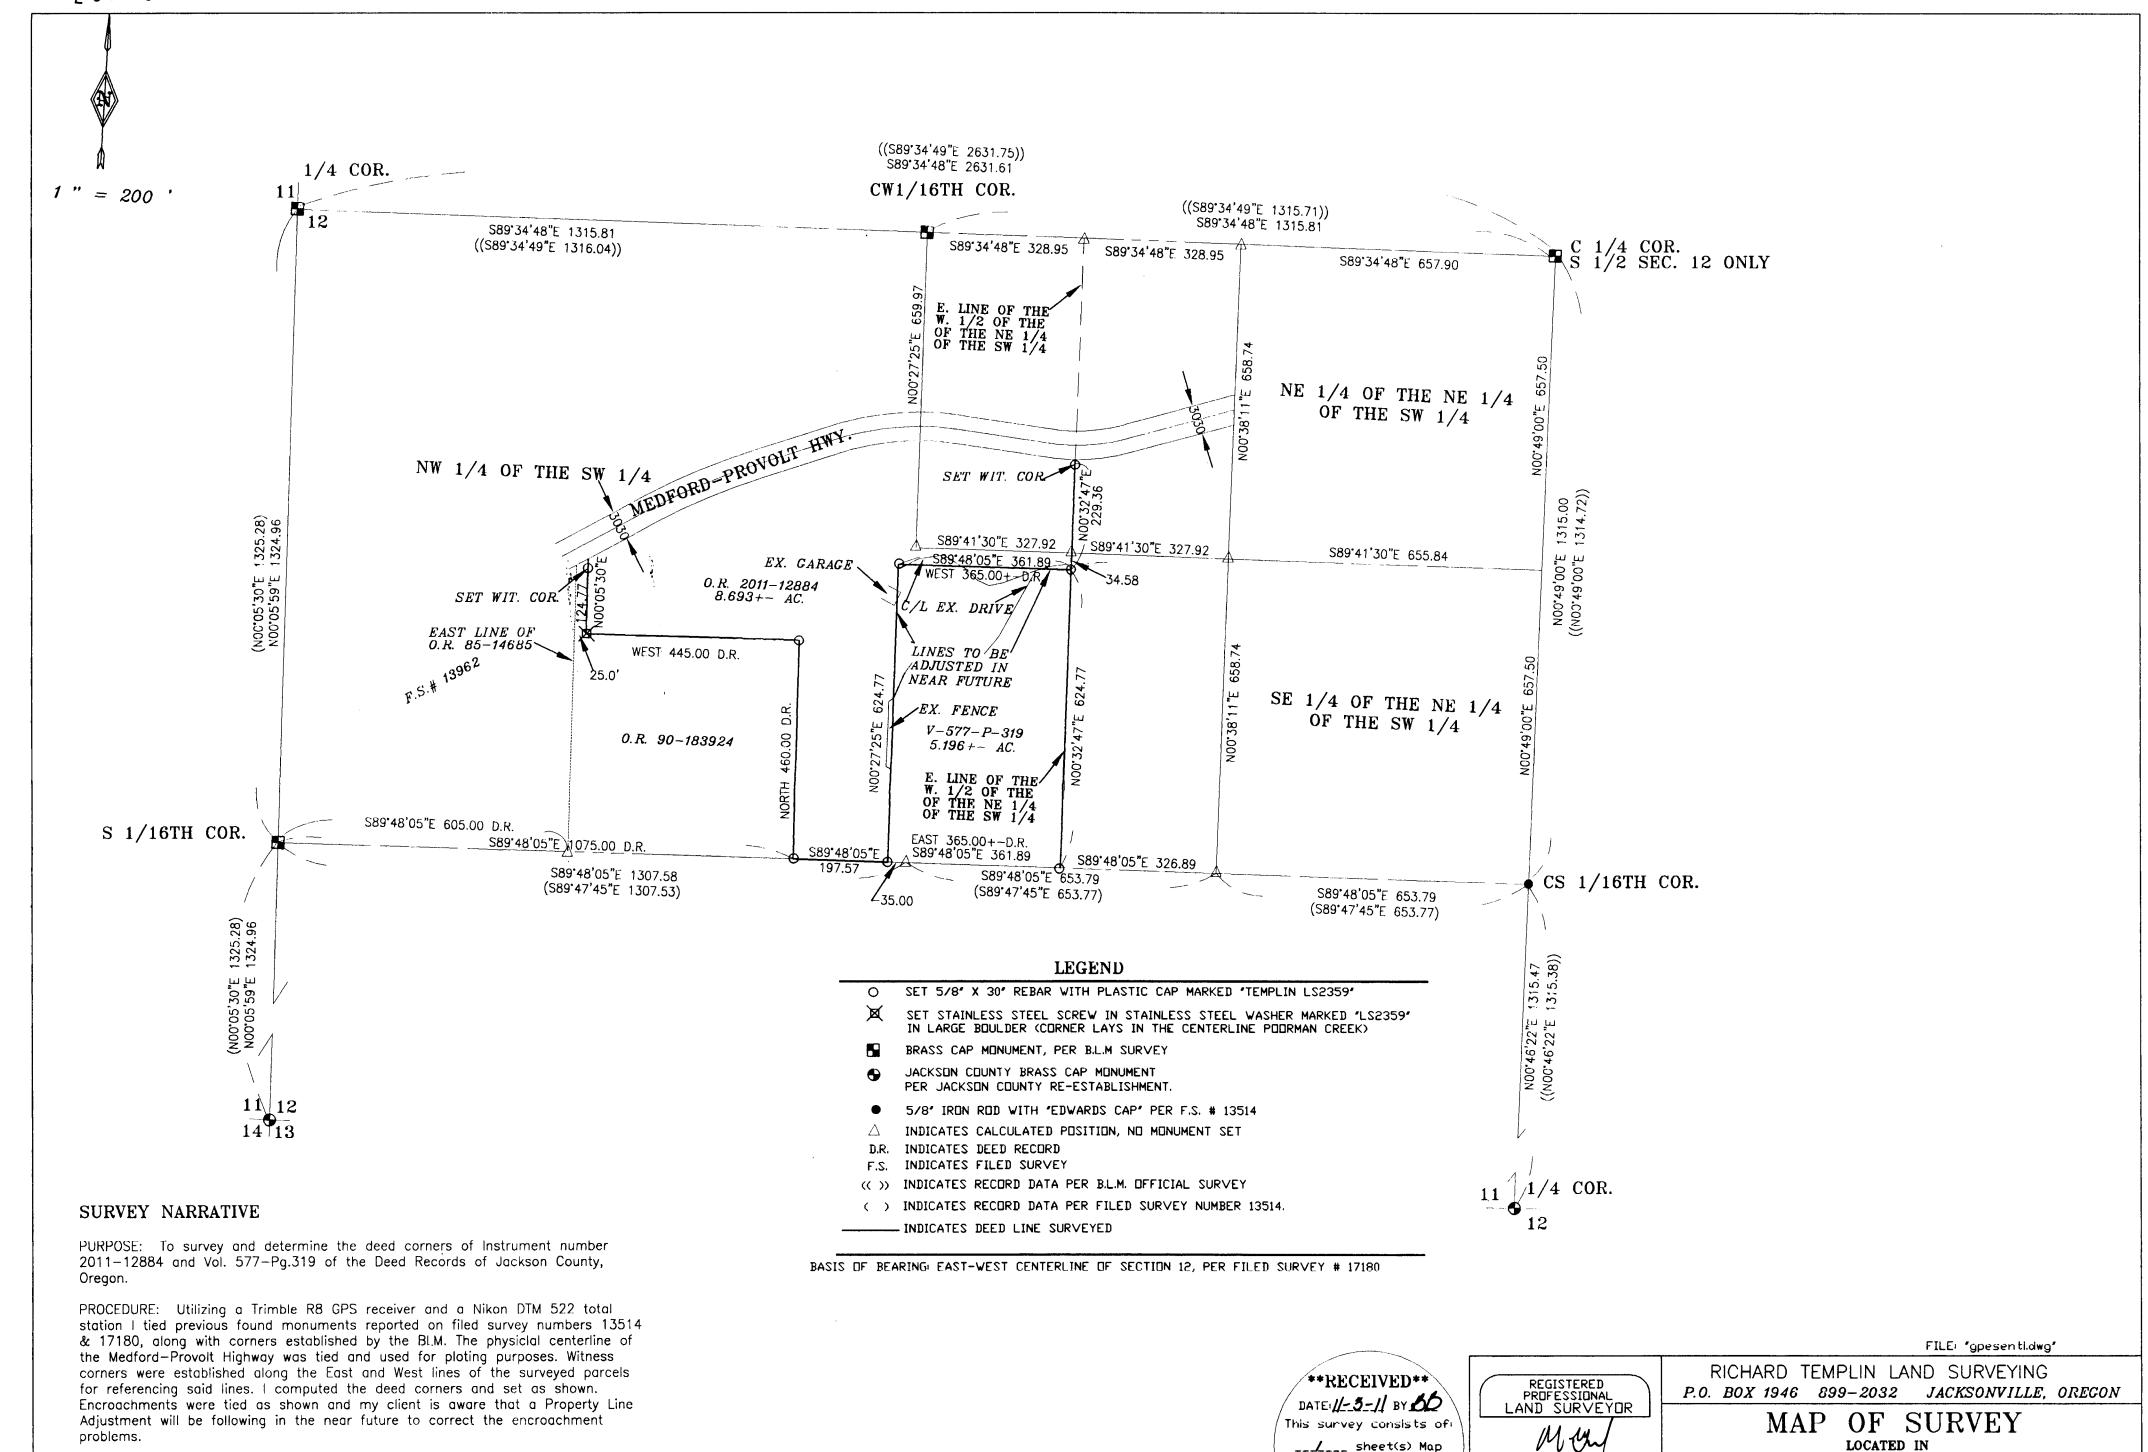

_____ sheet(s) Map

JACKSON COUNTY

SURVEYOR

JUNE 30, 2012

_**Q**__ page(s) Narrative,

DATE: October 28, 2011

NE 1/4 AND THE NW 1/4 OF THE SW 1/4 OF SECTION 12

T. 38S.,R.3 W., W.M. JACKSON COUNTY, OREGON

Mr. Michael Pesenti

Jacksonville, Or. 97530

P.O. Box 549