
372W27C TL1900

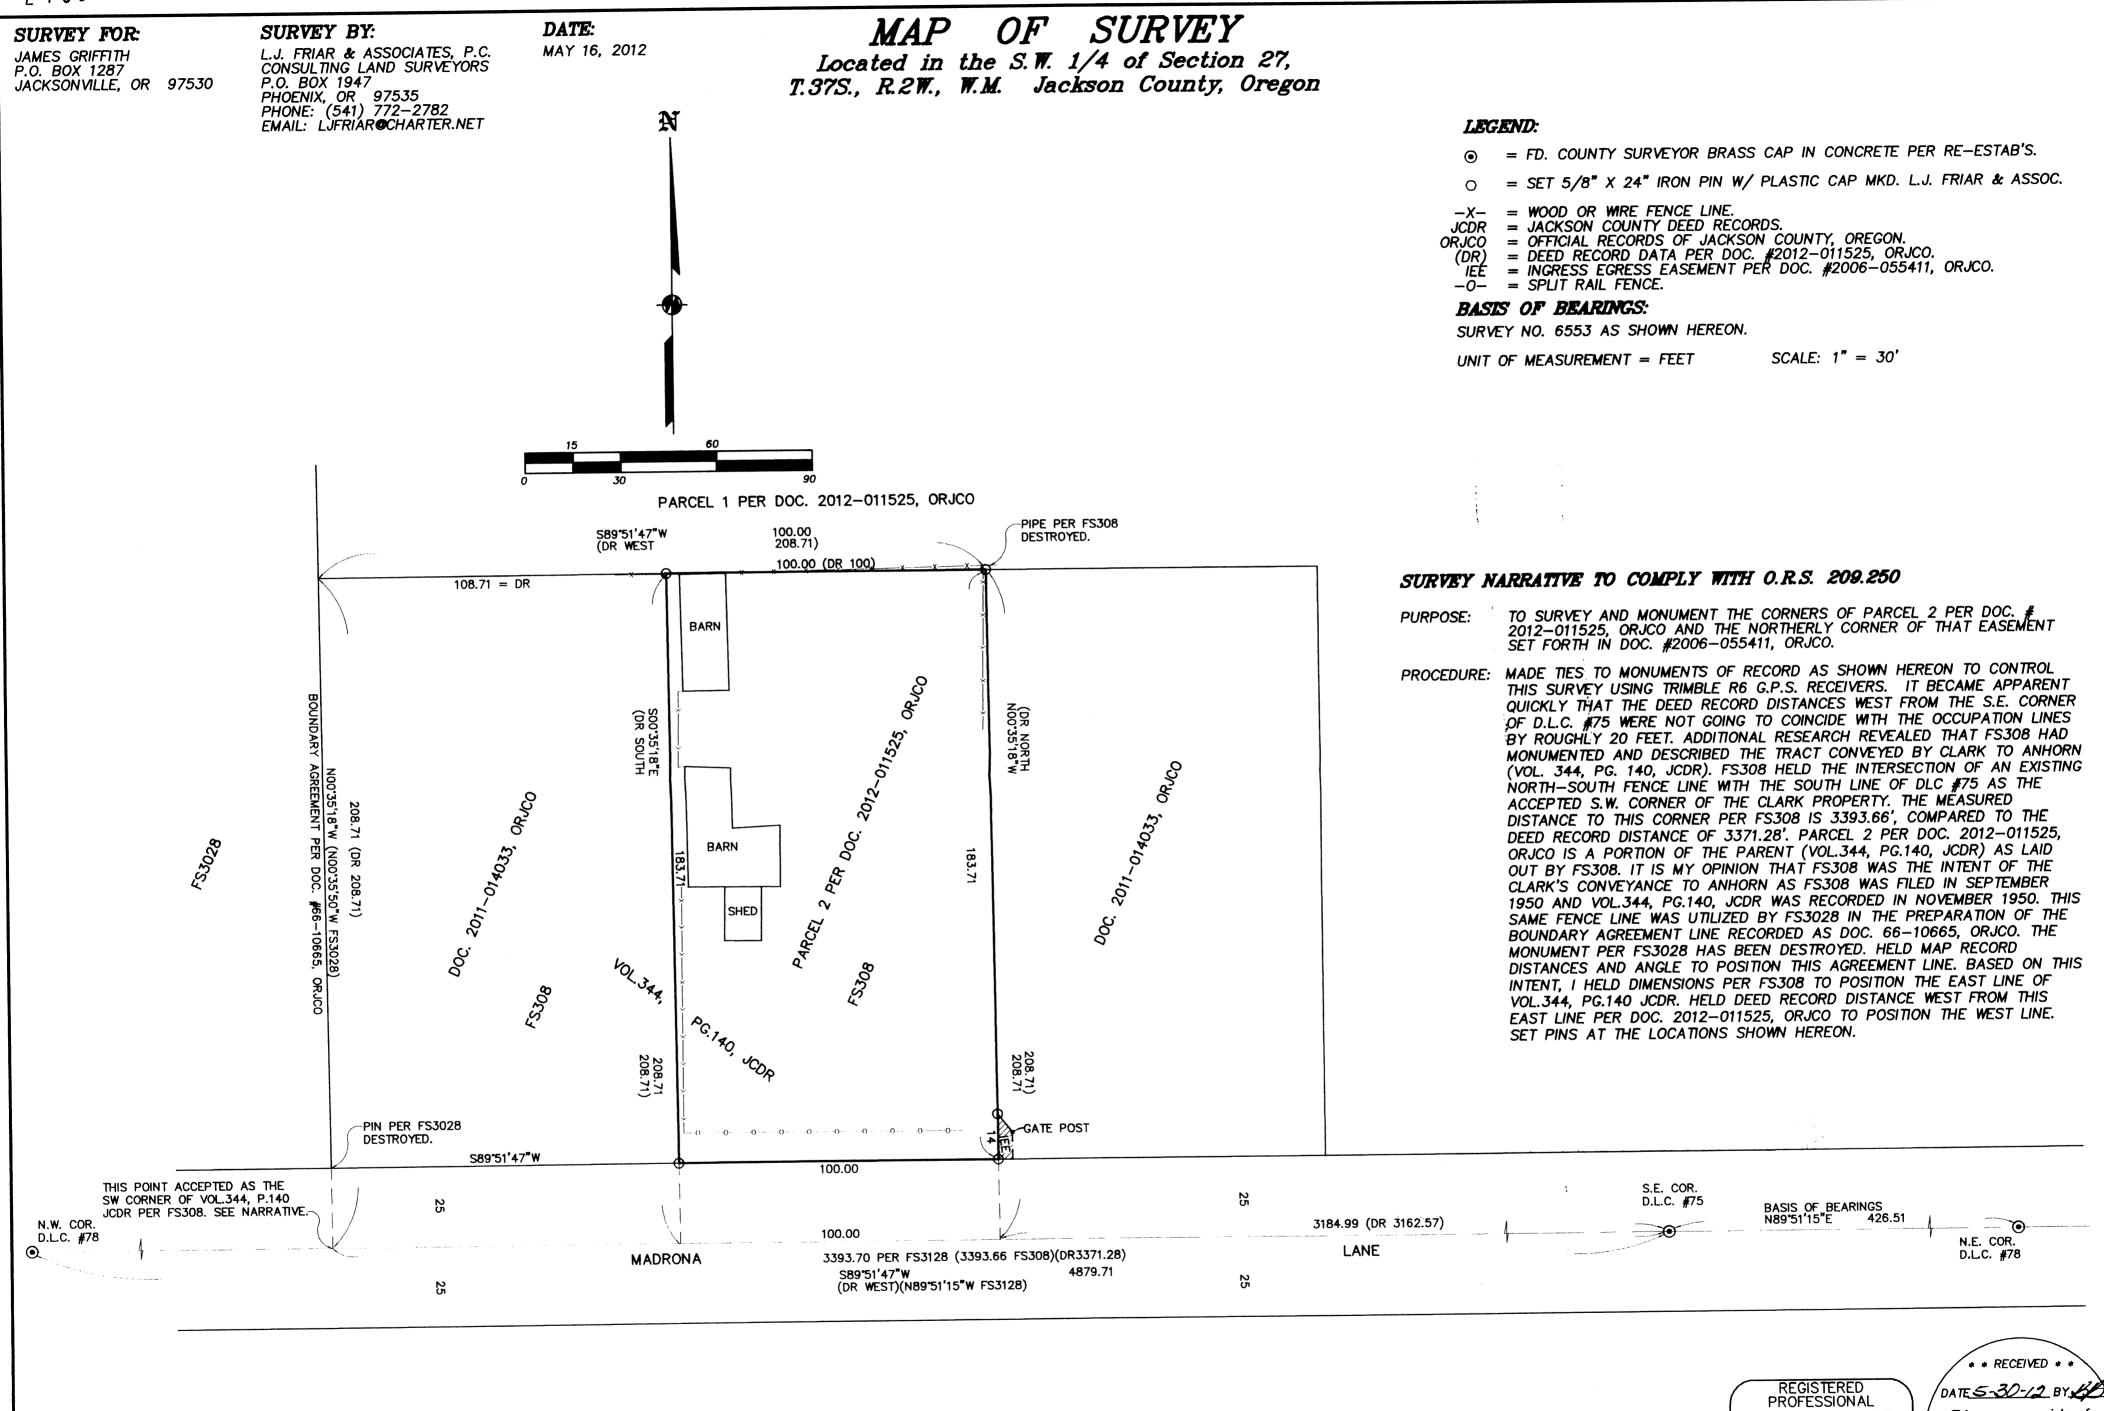

THIS PLAT WAS PREPARED USING AN HP450C DESIGNJET WITH 51640A INKJET INK ON CONTINENTAL JPC4M2 POLYESTER FILM.

This survey consists of:

JACKSON COUNTY

SURVEYOR

\_sheet(s) Map

O\_page(s) Narrative

LAND SURVEYOR

OREGON JULY 17, 1986

JAMES E. HIBBS 2234

RENEWAL DATE 6-30-13