


MAP OF SURVEY

FOR  
TIM LOPEZ

LOCATED IN  
THE NORTHWEST QUARTER OF SECTION 30,  
TOWNSHIP 36 SOUTH, RANGE 4 WEST, W.M.  
JACKSON COUNTY, OREGON

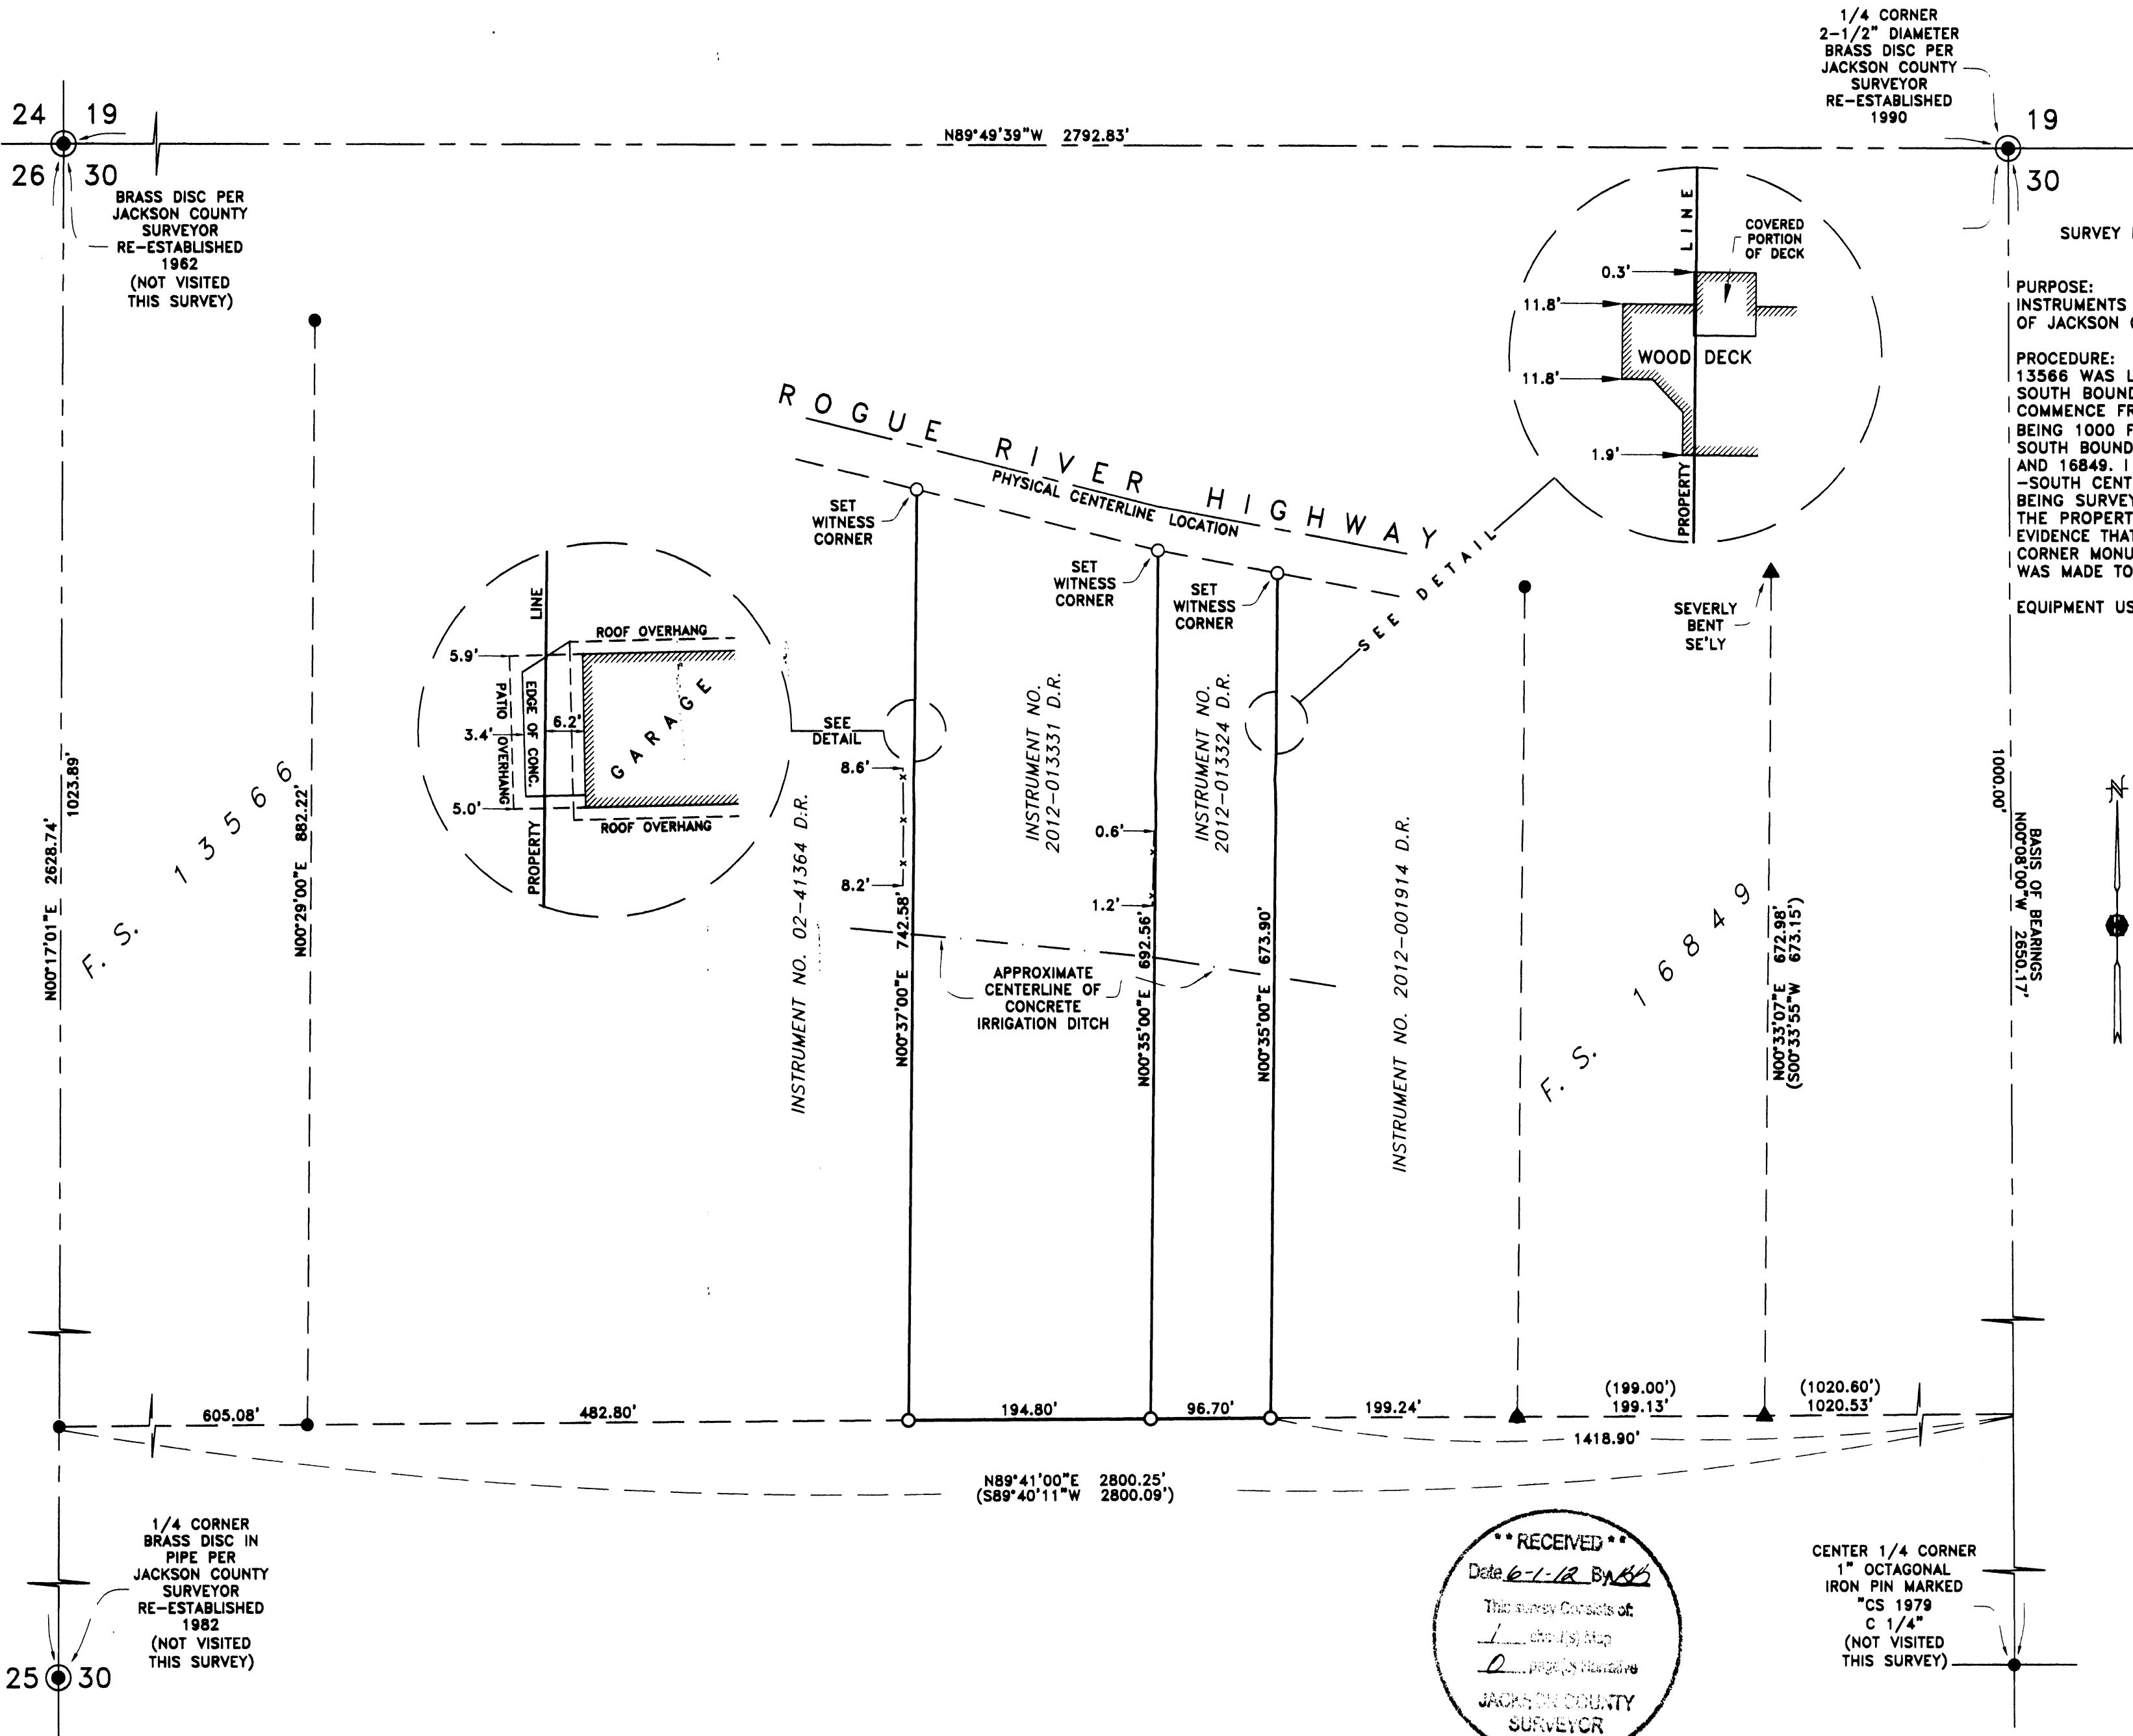

SURVEY NARRATIVE TO COMPLY WITH PARAGRAPH 209.250  
OREGON REVISED STATUTES

PURPOSE: TO SURVEY AND MONUMENT THOSE PROPERTIES AS DESCRIBED IN INSTRUMENTS NO. 2012-01331 AND 2012-013324 OF THE OFFICIAL RECORDS OF JACKSON COUNTY, OREGON.

PROCEDURE: SURVEY CONTROL ESTABLISHED BY THIS OFFICE FOR SURVEY NO. 13566 WAS LOCATED AND EXTENDED FOR PURPOSES OF THIS SURVEY. THE SOUTH BOUNDARY OF THE LEGAL DESCRIPTIONS OF THE DEEDS IN THIS AREA COMMENCE FROM A POINT ON THE NORTH-SOUTH CENTERLINE OF SECTION 30, BEING 1000 FEET SOUTH FROM THE NORTH 1/4 CORNER OF SECTION 30. THIS SOUTH BOUNDARY HAS BEEN PREVIOUSLY ESTABLISHED PER SURVEYS NO. 13566 AND 16849. I HELD DEED RECORD DISTANCE ALONG THIS LINE FROM THE NORTH-SOUTH CENTERLINE TO DETERMINE THE POINT OF BEGINNING OF THE PROPERTY BEING SURVEYED AND HELD DEED RECORD BEARING NORTHERLY TO ESTABLISH THE PROPERTY LINES RUNNING NORTH TO THE HIGHWAY. I COULD FIND NO EVIDENCE THAT THE HIGHWAY RIGHT-OF-WAY HAS BEEN MONUMENTED SO WITNESS CORNER MONUMENTS WERE SET NEAR THE HIGHWAY RIGHT-OF-WAY. NO ATTEMPT WAS MADE TO DETERMINE THE TRUE RIGHT-OF-WAY LOCATION.

EQUIPMENT USED: TRIMBLE S-6 ROBOTIC INSTRUMENT.

LEGEND

- = FOUND BRASS CAP MONUMENT AS NOTED.
- = FOUND 5/8" IRON PIN WITH PLASTIC CAP STAMPED "D. HUCK LS 2023" PER F.S. 13566. UNLESS NOTED OTHERWISE
- ▲ = FOUND 5/8" IRON PIN WITH PLASTIC CAP STAMPED "HULL RS 901" PER F.S. 16849.
- = SET 5/8"x24" IRON PIN WITH PLASTIC CAP STAMPED "D. HUCK LS 2023".
- (.....) = RECORD DATA PER F.S. 16849.
- x- = EXISTING WIRE FENCE
- D.R. = DEED RECORDS OF JACKSON COUNTY, OREGON
- F.S. = FILED SURVEY WITH THE JACKSON COUNTY SURVEYOR'S OFFICE.

HOFFBUHR & ASSOCIATES, INC.  
880 GOLF VIEW DRIVE, SUITE 201  
MEDFORD, OREGON 97504  
(541)779-4641


BY: DARRELL L. HUCK PLS No. 2023  
SCALE: 1 inch = 100 feet MAY 22, 2012  
BASIS OF BEARING: FILED SURVEY 7624

REGISTERED  
PROFESSIONAL  
LAND SURVEYOR

Darrell L. Huck

OREGON  
FEBRUARY 4, 1983  
DARRELL L. HUCK  
2023

Expires 6/30/2013

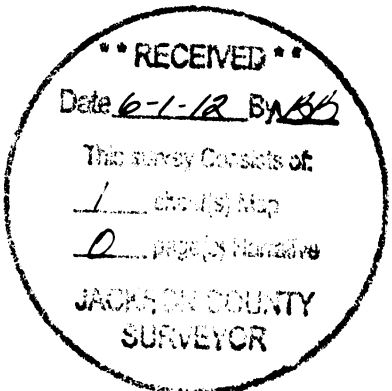

CENTER 1/4 CORNER  
1" OCTAGONAL  
IRON PIN MARKED  
"CS 1979  
C 1/4"  
(NOT VISITED  
THIS SURVEY)