
36-2W-36CD-TL'S 1900 & 2000 (SHEET 1 OF 1)

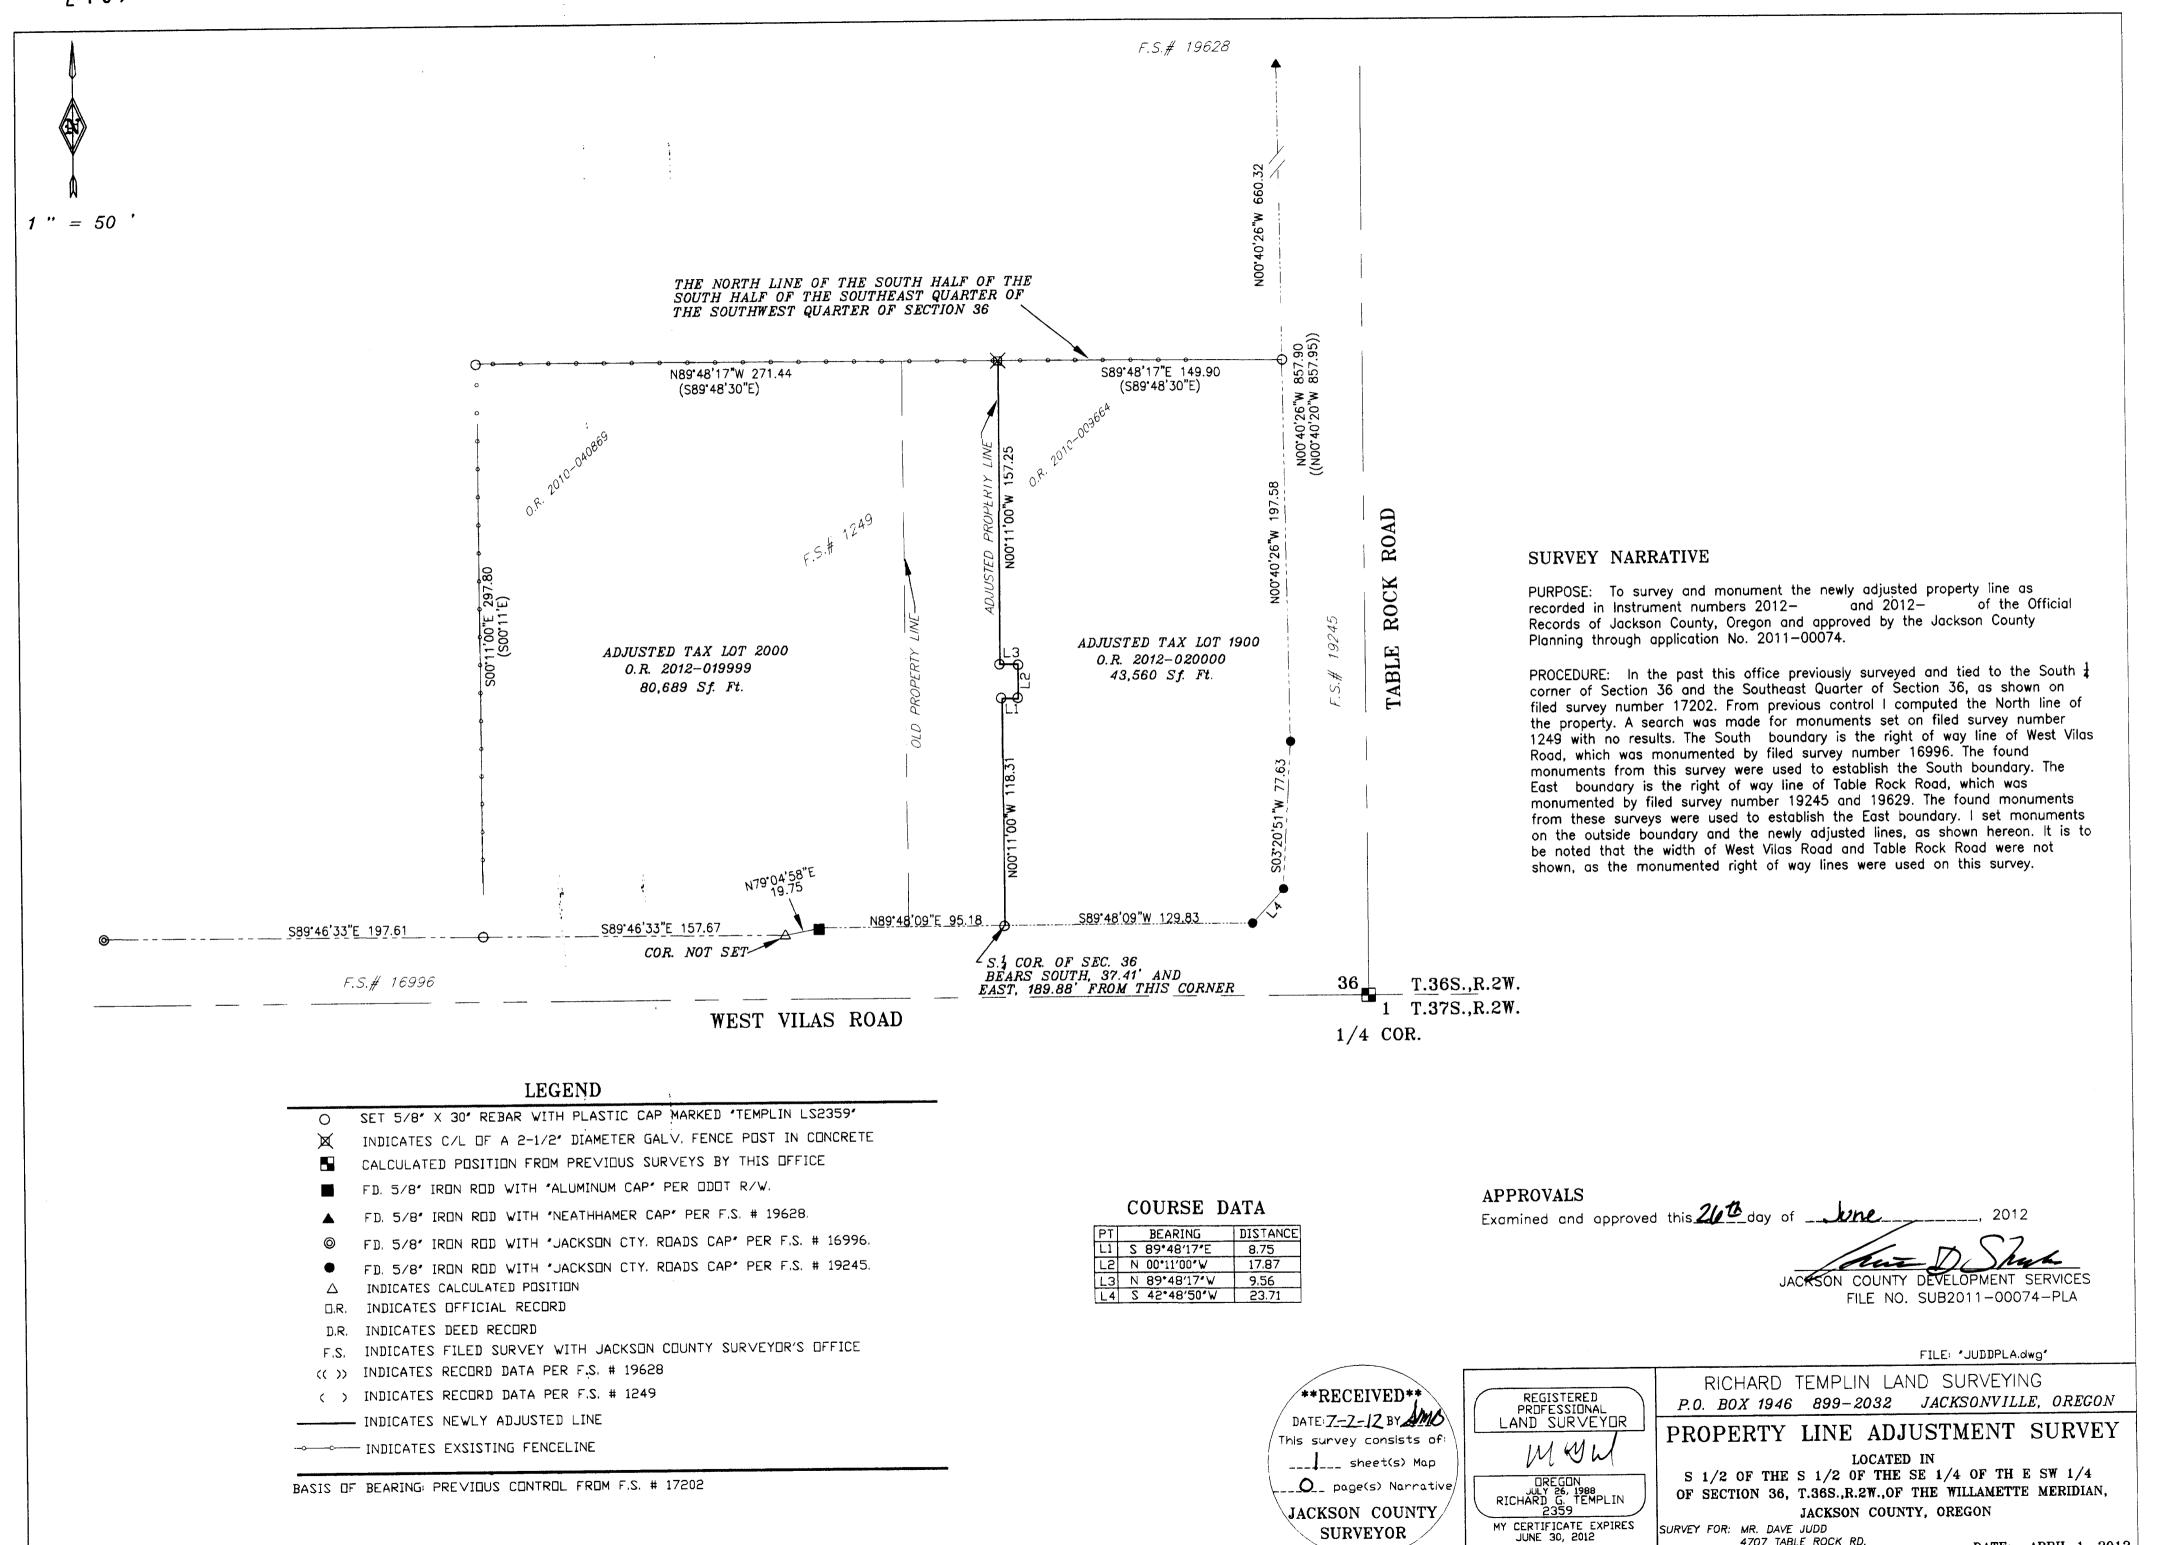

DATE: APRIL 1, 2012

4707 TABLE ROCK RD.

CENTRAL POINT, OR. 97502