

LT 1 BLK 2

SURVEY IN LOT 1 BLOCK 2  
ROGUE VALLEY HT'S.  
FOR  
BERGMAN


62 - 35

BY EDWARD MCGINTY  
MEDFORD OREGON  
NOVEMBER 1962

SCALE F = 50'  
O = 1. PIPE FD.  
● = 5/8" I. PIN



*Edward A. McGinty*

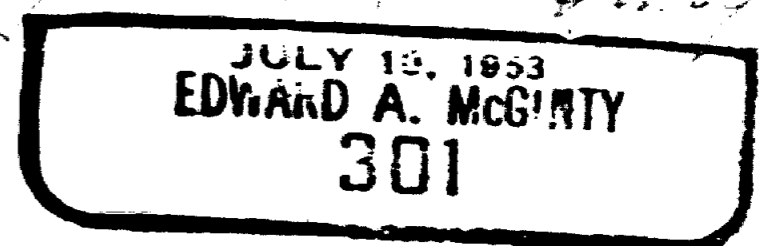

Survey No. 2110

Survey Narrative to comply with O.R.S. 209-250.

Survey for: Mr. Bergman (Bergman's Shop)  
3012 Crater Lake Hwy.

Survey by: Edward A. McGinty, L.S.  
12/12/62

PRECEDENCE OF SURVEY:

Surveyed the North 137 ft. of the East 105 ft. of the West 137.22 ft. of Lot. 1, Blk. 2 of the Rogue Valley Heights Sub-Div. Survey control was determined from the NW. and SW. lot corners and previous survey No. 798. No confirmation was made on this survey in determining whether the lots extended beyond the section line as shown in Sur. No. 798.

