


2112

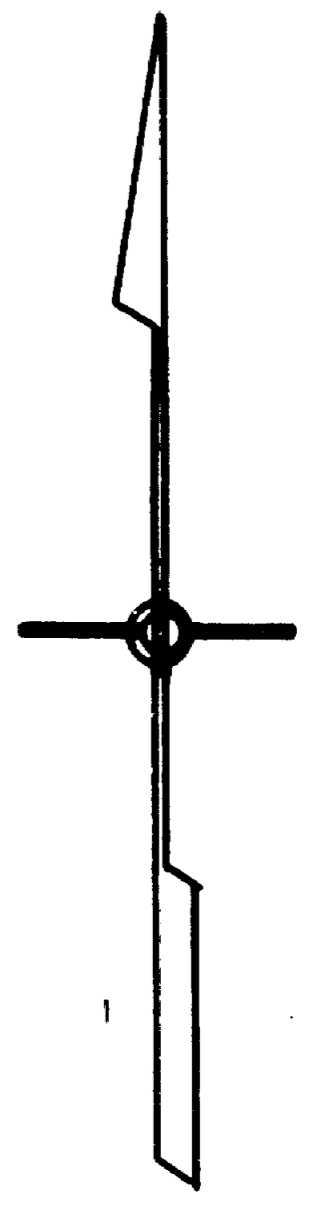

BASIS BEARING - W. LINE OF SUBD. =
 N 0° 03' 00" W = SOLAR N 0° 08' 20" W



SURVEY IN LOT 5, BLOCK 1 OF
 HILES LARK MEADOWS SUBDIVISION
 FOR

T. OAKES
 63-3

BY EDWARD MC GINTY
 MEDFORD OREGON
 FEB. 1963

SCALE 1" = 100'
 ○ = 5/8" I. PIN
 ■ = CONC. MON.

REGISTERED
 OREGON
 LAND SURVEYOR

Edward A. McGinty
 JULY 10, 1953
 EDWARD A. MCGINTY
 301

2112

2112

Survey No. 2112

Survey Narrative to comply with O.R.S. 209-250.

Survey for: Tom Oakes

Survey by: Edward A. McGinty, L.S.
2/8/63

BASIS OF BEARING: Previous survey for D. Bates.

PRECEDENCE OF SURVEY:

From previous survey for Bates, being a re-survey of Miles Lark Meadows Sub-d., and from the information attained from that survey, surveyed this tract of land.

