


BOUNDARY SURVEY OF PROPERTY
 SITUATE IN
 VICINITY, EAST OF NORTH RIVERSIDE AVENUE
 AND EAST FIFTH STREET, CITY OF MEDFORD,
 JACKSON COUNTY, OREGON
 FOR
 THE VINSON ESTATE c/o MAXINE BIGALOW
 L.P. LOVEJOY L.S. MEDFORD, OREGON
 SCALE: 1" = 50'
 BEARINGS BY PREVIOUS SURVEY
 o = SET 5/8" IRON PIN

REGISTERED
OREGON
 LAND SURVEYOR
Leland P. Lovejoy
 NOVEMBER 14, 1948
LELAND P. LOVEJOY
 282

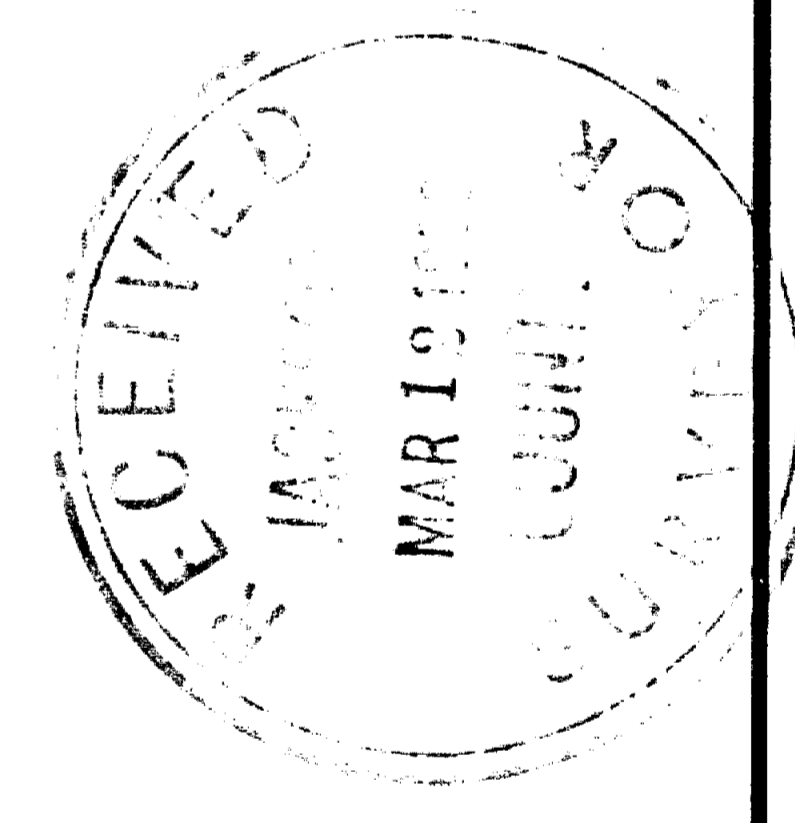

SURVEY NARRATIVE TO COMPLY WITH SECTION 87-3301947 OREGON STATE LAWS

Survey For: Mrs. Maxine Bigalow, Guardian
Pheba Vinson Vaughn Estate
2010 East Main Street
Medford, Oregon

Purpose of Survey: To establish property boundaries.

Survey Location: Section 30, Township 37 South, Range 1
West, Willamette Meridian, in vicinity of
North Riverside Avenue and East Fifth
Street, Medford, Oregon.

Survey Procedure: Found monuments and other survey points
recorded survey No. 536, No. 668, and
No. 1354, and used as a basis for survey
control, as shown on map. Set 5/8" iron pins
as shown.

Leland P. Lovejoy
Registered Land Surveyor

Work Completed February 10, 1963.

