
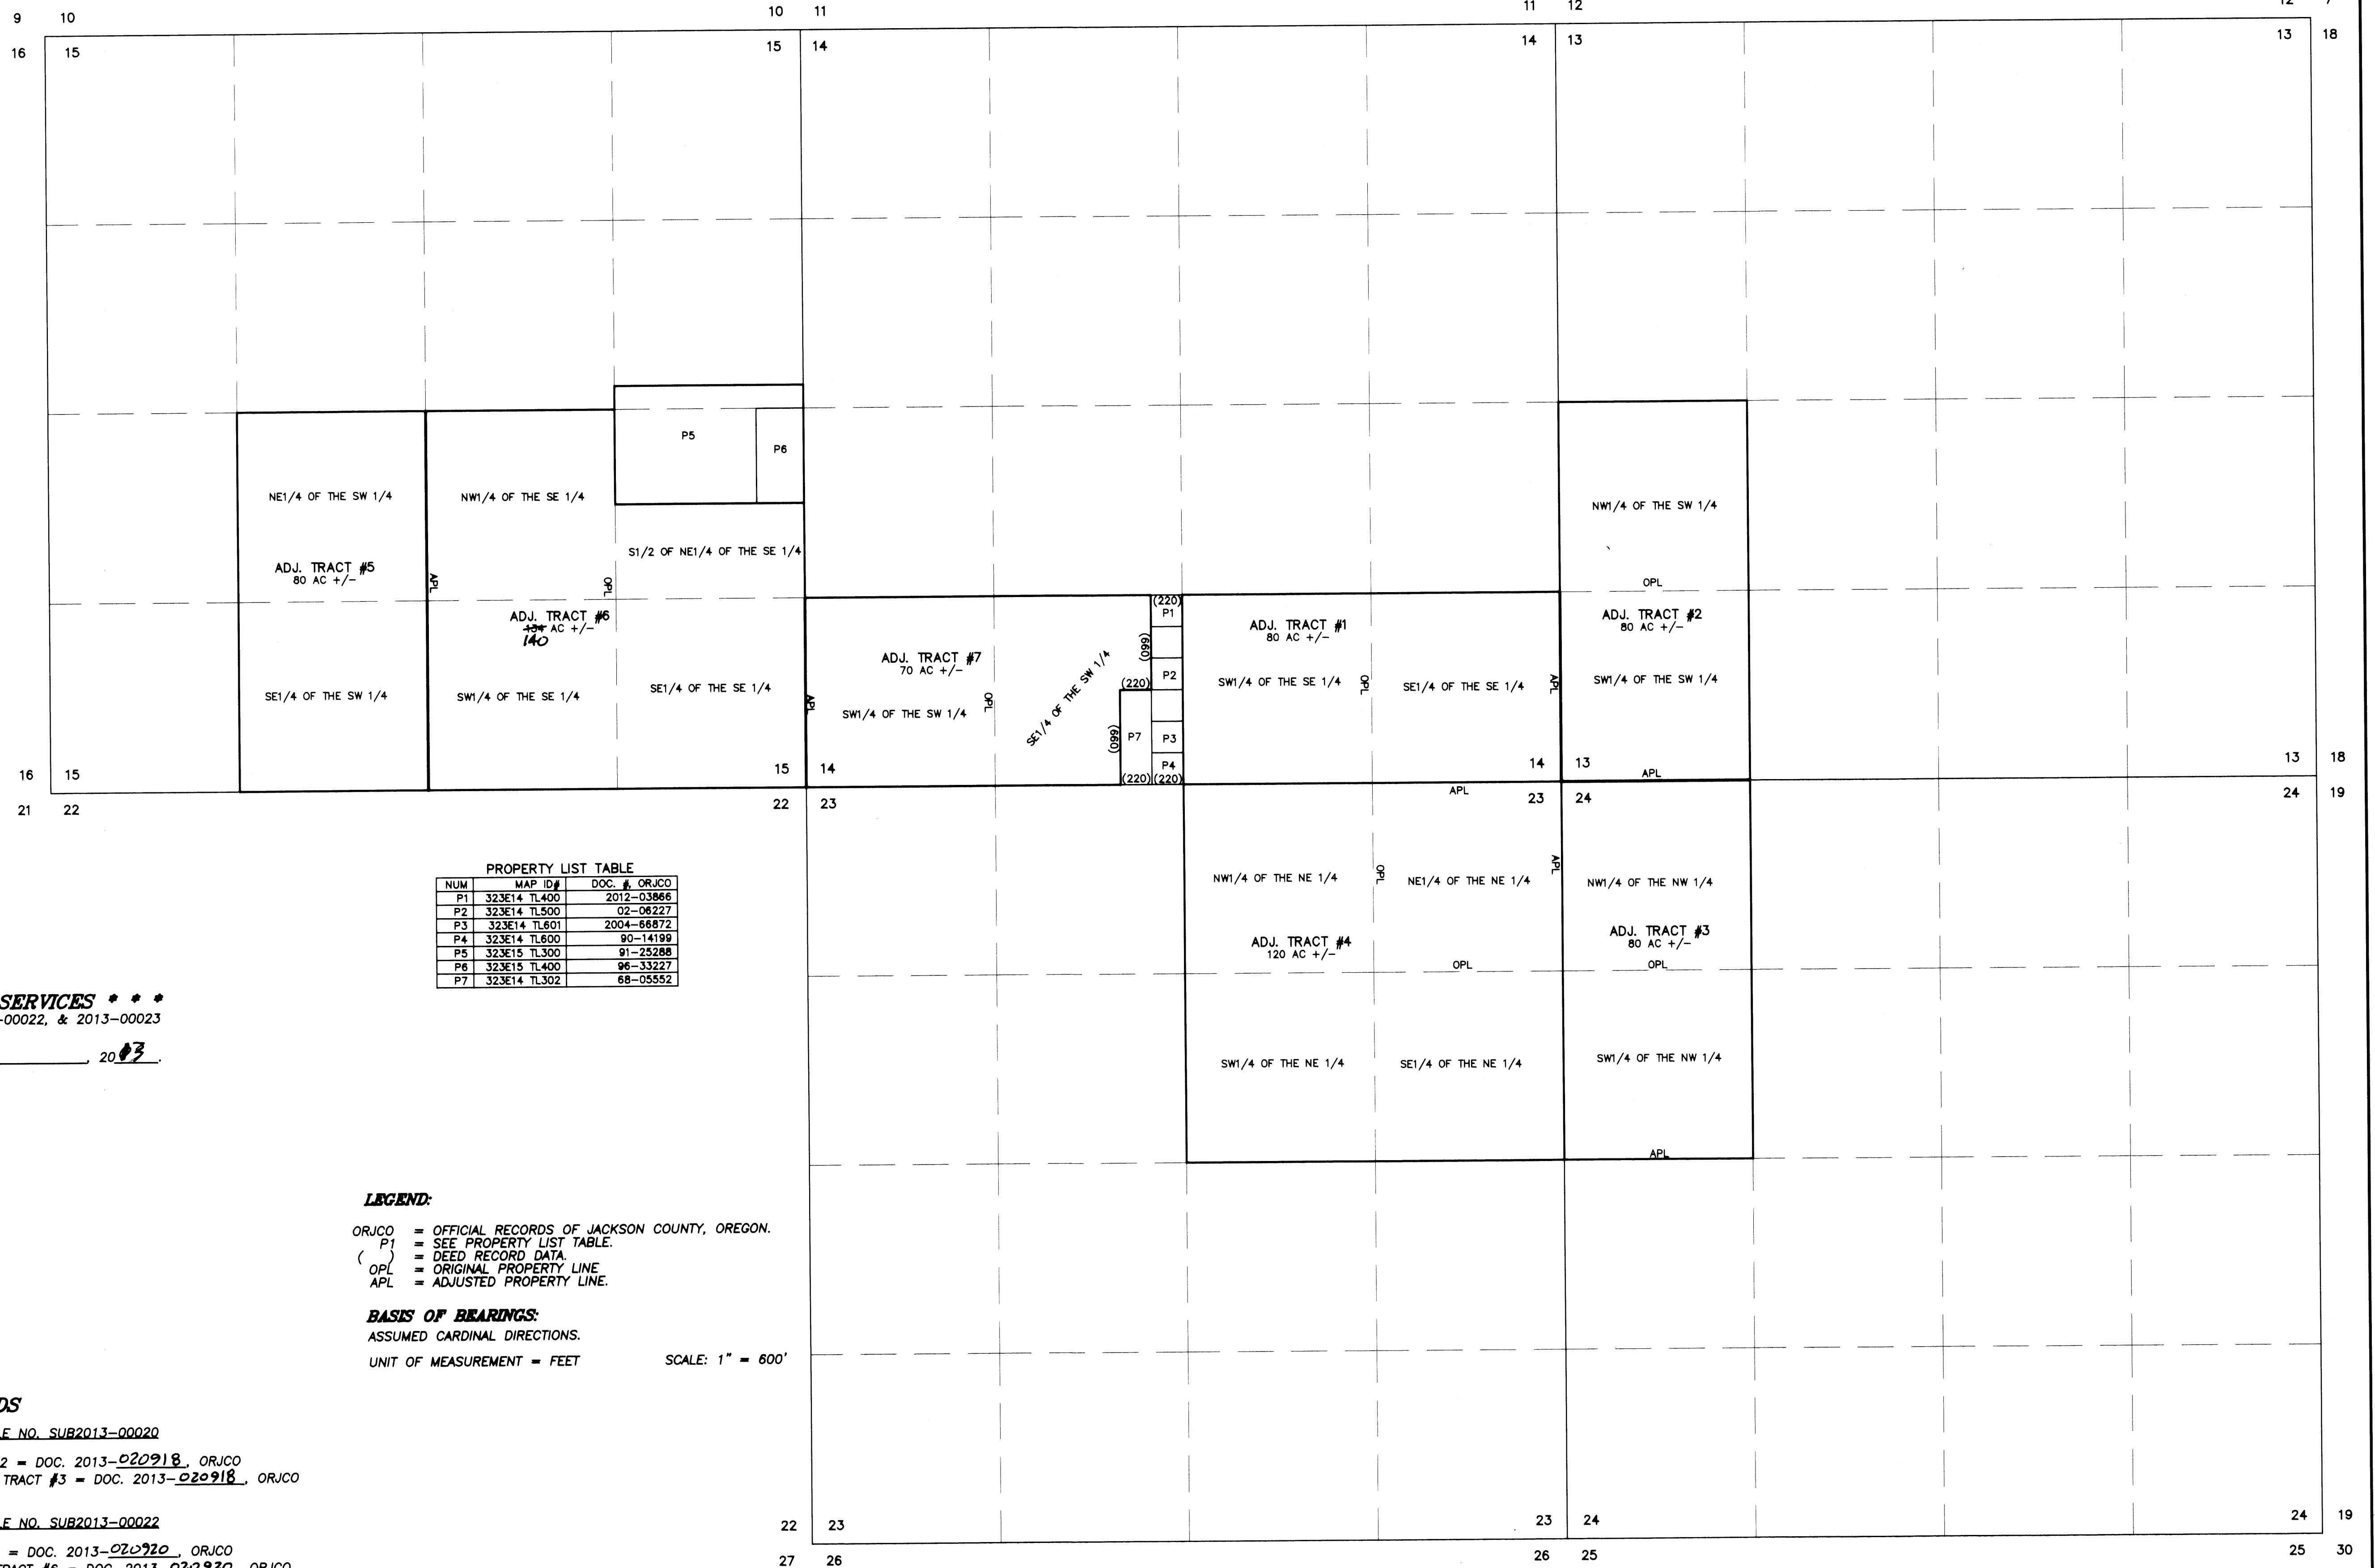


**SURVEY FOR:**  
HANCOCK NATURAL RESOURCE GROUP, LLC  
99 HIGH STREET, 26TH FLOOR  
BOSTON, MA 02110

**DATE:**  
MAY 11, 2013

**MAP OF SURVEY**  
**(UNSURVEYED) PROPERTY LINE ADJUSTMENT**  
**In Sections 13, 14, 15, 23 & 24, T.32S., R.3E., W.M.**  
**Jackson County, Oregon**  
**(JCDS #SUB2013-00019, 2013-00020, 2013-00021, 2013-00022, & 2013-00023)**

**SURVEY BY:**  
L.J. FRIAR & ASSOCIATES, P.C.  
CONSULTING LAND SURVEYORS  
P.O. BOX 1947  
PHOENIX, OR 97535  
PHONE: (541) 772-2782  
EMAIL: LJFRIAR@CHARTER.NET

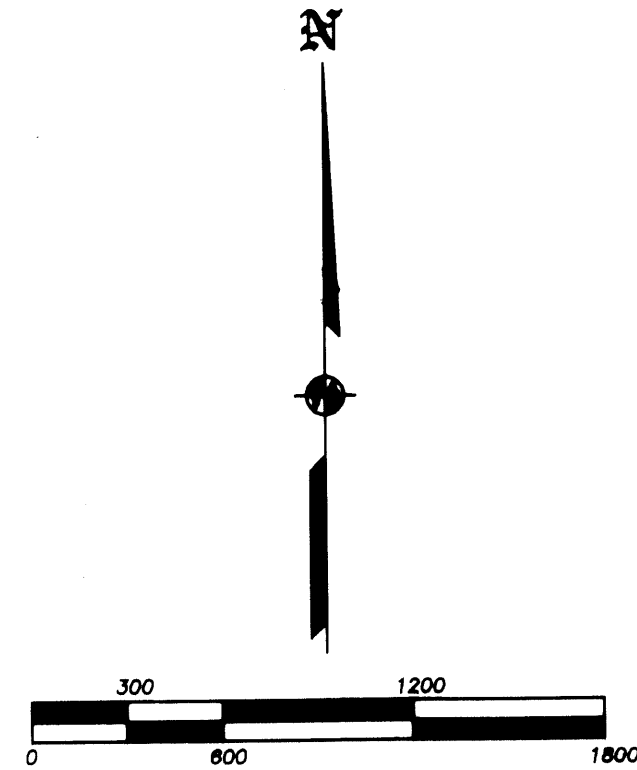

**PROPERTY LIST TABLE**

NUM	MAP ID#	DOC. #	ORJCO
P1	323E14 TL400	2012-03866	
P2	323E14 TL500	02-06227	
P3	323E14 TL601	2004-66872	
P4	323E14 TL600	90-14198	
P5	323E15 TL300	91-25288	
P6	323E15 TL400	96-33227	
P7	323E14 TL302	68-05552	

\*\*\* JACKSON COUNTY DEVELOPMENT SERVICES \*\*\*  
FILE NO. SUB2013-00019, 2013-00020, 2013-00021, 2013-00022, & 2013-00023

EXAMINED AND APPROVED THIS 15 DAY OF MAY, 2013.

BY: Charles Bennett

TITLE: Planner II

**LEGEND:**

- ORJCO = OFFICIAL RECORDS OF JACKSON COUNTY, OREGON.
- P1 = SEE PROPERTY LIST TABLE.
- ( ) = DEED RECORD DATA.
- OPL = ORIGINAL PROPERTY LINE
- APL = ADJUSTED PROPERTY LINE.

**BASIS OF BEARINGS:**

ASSUMED CARDINAL DIRECTIONS.  
UNIT OF MEASUREMENT = FEET      SCALE: 1" = 600'

**RECORDED ADJUSTMENT DEEDS**

FILE NO. SUB2013-00019

FILE NO. SUB2013-00020

ADJ. TRACT #1 = DOC. 2013-020917, ORJCO  
INTERIM ADJ. TRACT #3 = DOC. 2013-020917, ORJCO

ADJ. TRACT #2 = DOC. 2013-020918, ORJCO  
INTERIM ADJ. TRACT #3 = DOC. 2013-020918, ORJCO

FILE NO. SUB2013-00021

FILE NO. SUB2013-00022

FINAL ADJ. TRACT #3 = DOC. 2013-020919, ORJCO  
ADJ. TRACT #4 = DOC. 2013-020919, ORJCO

ADJ. TRACT #5 = DOC. 2013-020920, ORJCO  
INTERIM ADJ. TRACT #6 = DOC. 2013-020920, ORJCO

FILE NO. SUB2013-00023

FINAL ADJ. TRACT #6 = DOC. 2013-020921, ORJCO  
ADJ. TRACT #7 = DOC. 2013-020921, ORJCO

**SURVEY NARRATIVE TO COMPLY WITH O.R.S. 209.250**

**PURPOSE:** To graphically depict the adjusted property lines being created through various property line adjustments. See JCDS File Nos. SUB2013-00019, 2013-00020, 2013-00021, 2013-00022, & 2013-00023.

**PROCEDURE:** For the purpose of this Map, I assumed cardinal directions and 5280' feet to approximate the subject Sections and proceeded to graphically depict what the resultant tracts will be. No monuments were tied or set.

