

MAP OF SURVEY

located in the
TOWNSHIP 38 SOUTH, RANGE 4 EAST,
WILLAMETTE MERIDIAN, JACKSON COUNTY, OREGON
for

**HANCOCK FOREST
MANAGEMENT INC**

572 PARSONS DRIVE, STE 124
MEDFORD, OREGON 97501

LEGEND

- ⊕ = FOUND 3" BLM BRASS CAP AS DESCRIBED
- ⊗ = FOUND 2" POT METAL FILLED REDUCER AS DESCRIBED
- CH = CHAINS
- J.C.S.R. = JACKSON COUNTY SURVEY RECORDS
- S/N = SURVEY NUMBER (J.C.S.R.)
- RECORD GLO SURVEY DATA IS SHOWN IN PARENTHESIS ADJACENT TO MEASURED SURVEY DATA WHERE APPLICABLE.

SURVEY NARRATIVE

Purpose: This survey was conducted to mark the lines per Hancock Forest Management Inc. standards.

Procedure: This survey was conducted using Trimble GPS 5800 and R-8 receivers and Trimble 5600 robotic total station. The survey was ran as a closed survey shown hereon. No Monuments were set on this survey.

Surveyed by:
FARBER & SONS, INC. dba



PO BOX 5286
431 OAK STREET
CENTRAL POINT, OREGON 97502
(541) 664-5599


DATE: OCTOBER 18, 2013
JOB NO.: 2080-13

JOB: Hancock Forest\Dir 4\MicroSurvey\FINAL PLAT-101713-SPC.DWG
DRAWN BY: LSH ORIG. DATE: 10/21/2013 EDITED BY: XXX DATE: XX/XX/XXXX


BASIS OF BEARING
IS TRUE NORTH,
NAD 83/91 DATUM,
AS DERIVED BY
GLOBAL POSITIONING
SYSTEM
OBSERVATIONS.

Section 4

Section 9

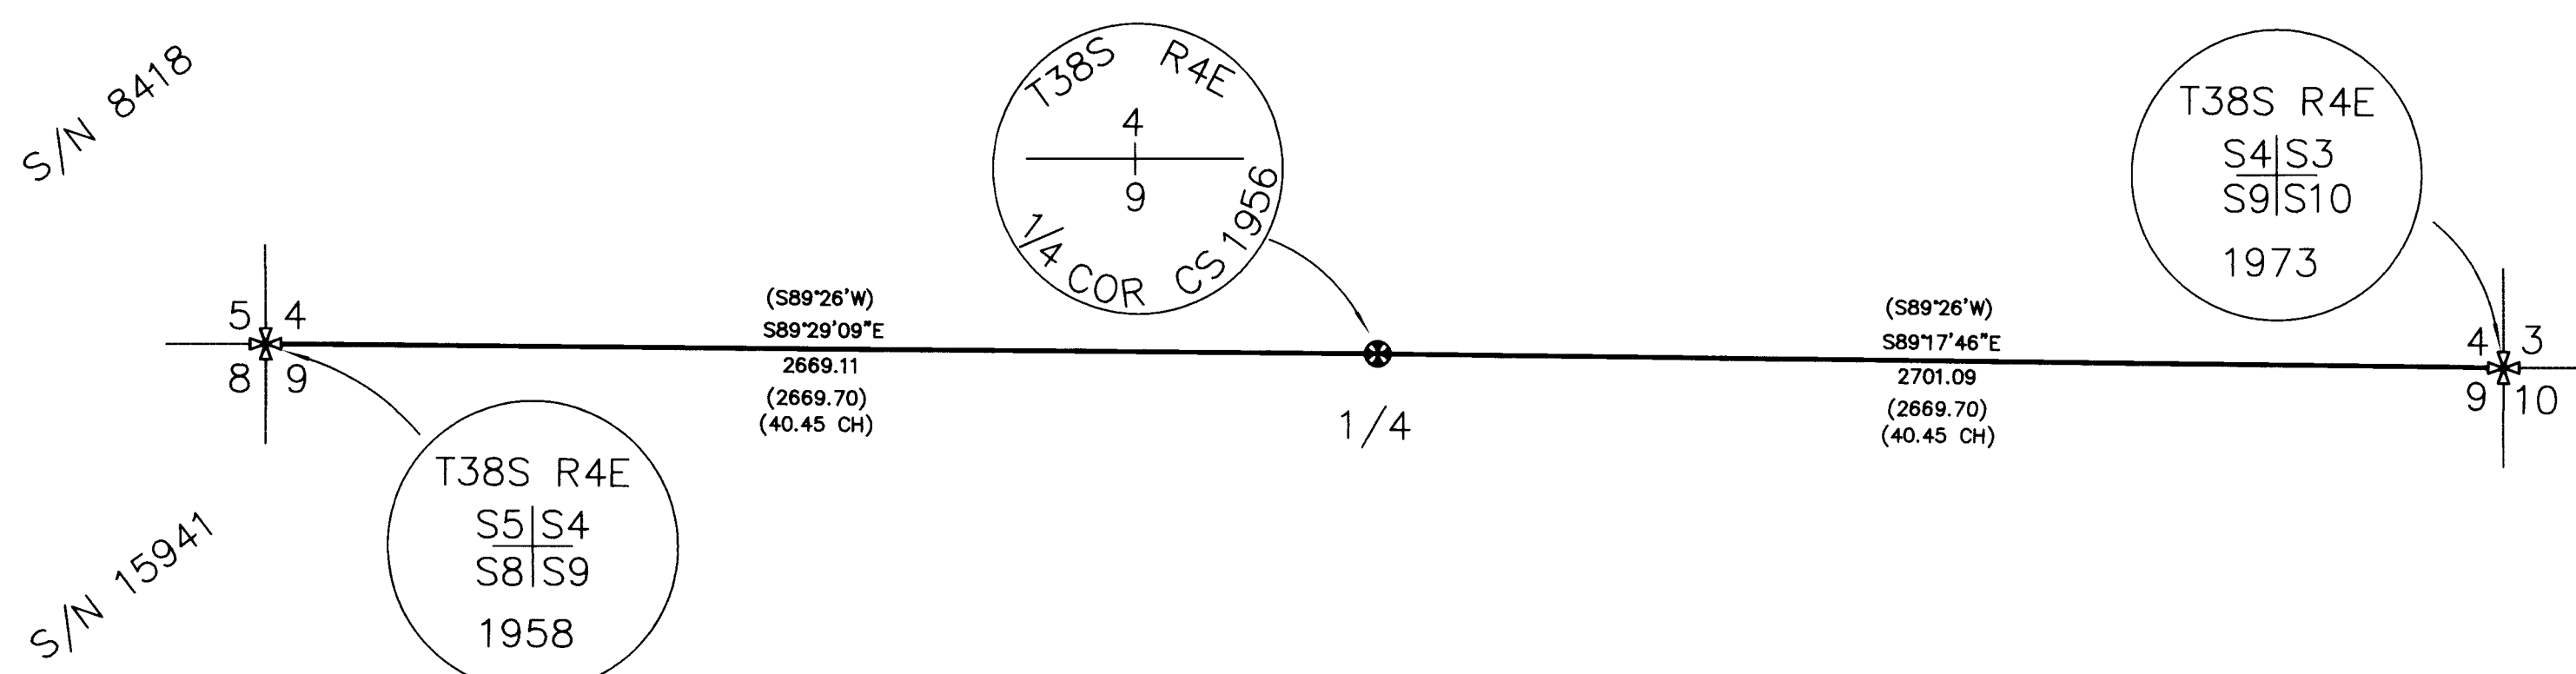

**** RECEIVED ****
DATE 11/17/13 BY LF
This survey consists of:
1 sheet(s) Map
2 page(s) Narrative
JACKSON COUNTY
SURVEYOR

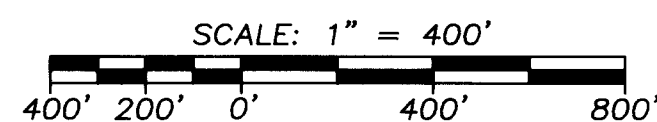

REGISTERED
PROFESSIONAL
LAND SURVEYOR

Herbert A. Farber
OREGON
JULY 26, 1985
HERBERT A. FARBER
2189

RENEWAL DATE 12-31-13

Sheet 1 of 1