

OREGON CORNER RESTORATION FORM

121401

Section 20 Township 33 S. Range 3W
County Jackson Date 1/14/14

Corner Designation

Center 1/4
Section 20

_____ Condition Report Only
_____ Not Found
X _____ Renewed
_____ Unrecorded
_____ Surveyed In
_____ Referenced Out

Previous Renewals/Surveys, etc.
1977 BLM Administrative Survey Filed In Jackson County Surveyors Office

Accessories Found: (Condition and Source)
Rotten Sugar Pine Stump Bears S83°E 16.6 feet (Record S80°E 16.4 feet) No Visible Marks


Monument Detail

Sketch



Legend:

- Found 5/8" Iron Rod
- ∧ Ridge Top
- ~ Unnamed Stream
- /— Line Blazed, Painted & Tagged

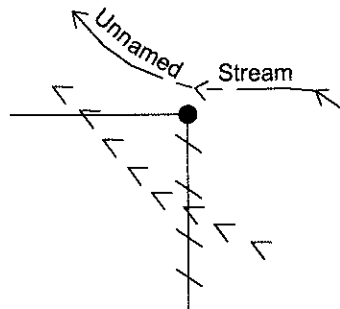

Monument Found

Found 1977 BLM Administrative 5/8" Iron Rod In Good Condition.


New Accessories

12" Douglas Fir Bears N71°W 15.1 Ft. We Scribe C1/4 S20 BT and Nail Aluminum Bearing Tree Tag To The Tree
8" Douglas Fir Bears S84°E 8.2 Ft. We Scribe C1/4 S20 BT and Nail Aluminum Bearing Tree Tag To The Tree

Location & Comments

Found 5/8" iron rod 0.3 feet above ground on a north slope which lies approx. 100 feet south of draw and 200 feet north of ridgetop.

Bearing Basis Bearing is from 1977 BLM Administrative Survey
Firm/Agency Lone Rock Timber Co.
Address P. O. Box 1127 Roseburg, Ore. 97470
Party Chief Ken W. Hoffine
Notes G. Angiolet
Witness G. Angiolet

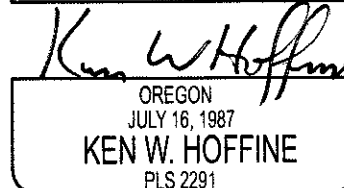

EXPIRES 6-30-15